



SCALE: 1" = 20'

EXIST.  
PROP.

EXIST.  
PROP.


# SITE PLAN FOR TOM REED

BEING KNOWN AS  $\frac{3}{4}$  L63 & THE SOUTHERLY TWENTY  
FEET (20') OF  $\frac{3}{4}$  L61 IN PAINESVILLE-ON-THE-LAKE  
SUBDIVISION, PAINESVILLE TOWNSHIP, LAKE COUNTY,  
OHIO.

UNLESS NOTED ALL LOTS - J.E. & I.L. RUZGA  
V832-237

< VACANT >

J.L. & M.L. O'CONNELL  
#970000429

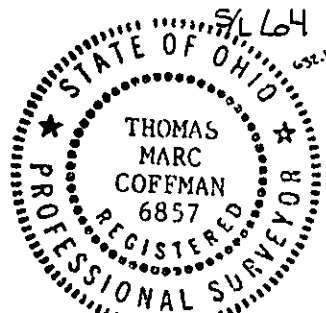

JAN 20, 2000


REV SL'S 3-30-00

$\frac{3}{4}$  L66

Grading Plan Approved  
as shown and/or noted  
THOMAS P. GILLES, P.E.  
Lake County Engineer

By TAM Date 4/12/2000

Swale as shown  
install yard drain need to drive

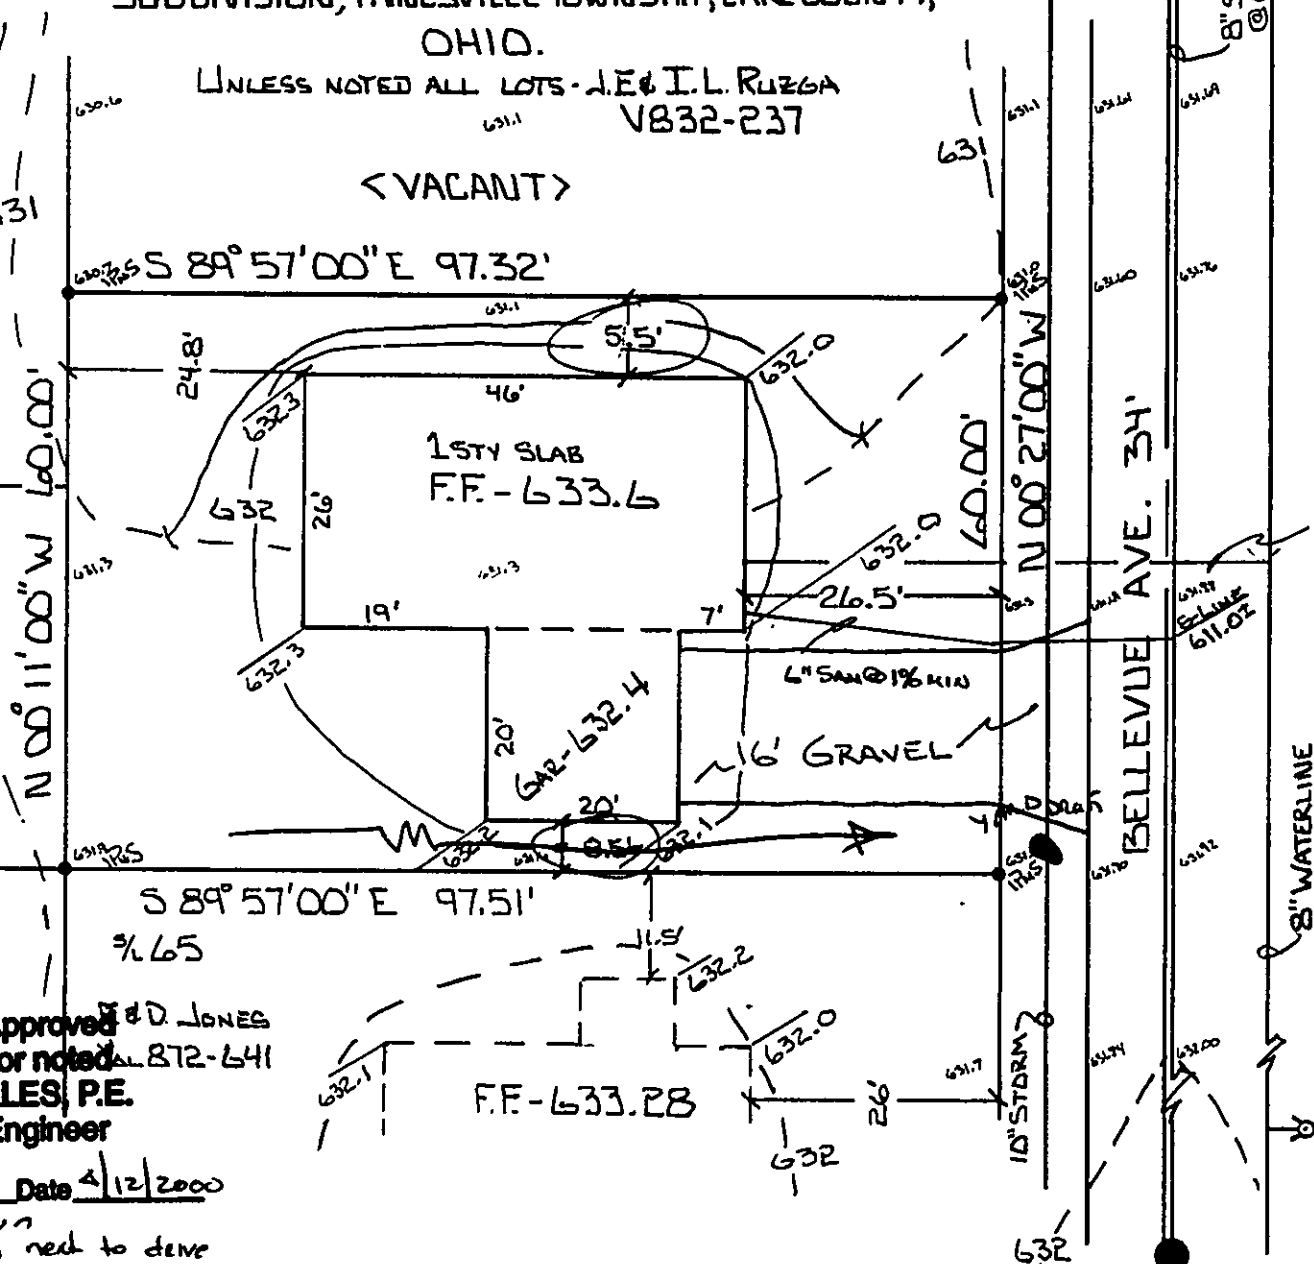

BENCHMARK - 631.89 N. RIM SAN M

INV. - 609.93

APPROVED  
PAINESVILLE TOWNSHIP  
ZONING DEPARTMENT

*2000-38 What*

I, the undersigned hereby certify that  
this topography, indicated by 1' contours  
and elevations shown hereon represent an  
actual field survey made by me on 3-27-00  
and that the elevations were taken at  
appropriate intervals and that as of that  
date they existed as indicated hereon.

J.W. Coffman P.E.  
N. 6857