


REVISIONS	BY

Barrington
CONSULTING GROUP, INC.
9114 TYLER BLVD., MENTOR, OHIO 44060
PHONE 440.205.1260 FAX 440.205.1262
BCG@BarringtonCGI.com

STATE OF OHIO
DAVID W. NOVAK
No. 7507
REGISTERED
SURVEYOR

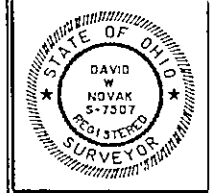


SITE PLAN
SIL 2 BELLMORE DR. PAINESVILLE TWP. OH. 44077
5' BELLMORE SUBDIVISION VOL. 44 PG. 21

LITTLE MOUNTAIN HOMES, INC.

WSD
CHECKED
DWN
DATE
FEB. 26, 2009
SCALE
1" = 20'
JOB NO
02007-02
SHEET
113

OF SHEETS

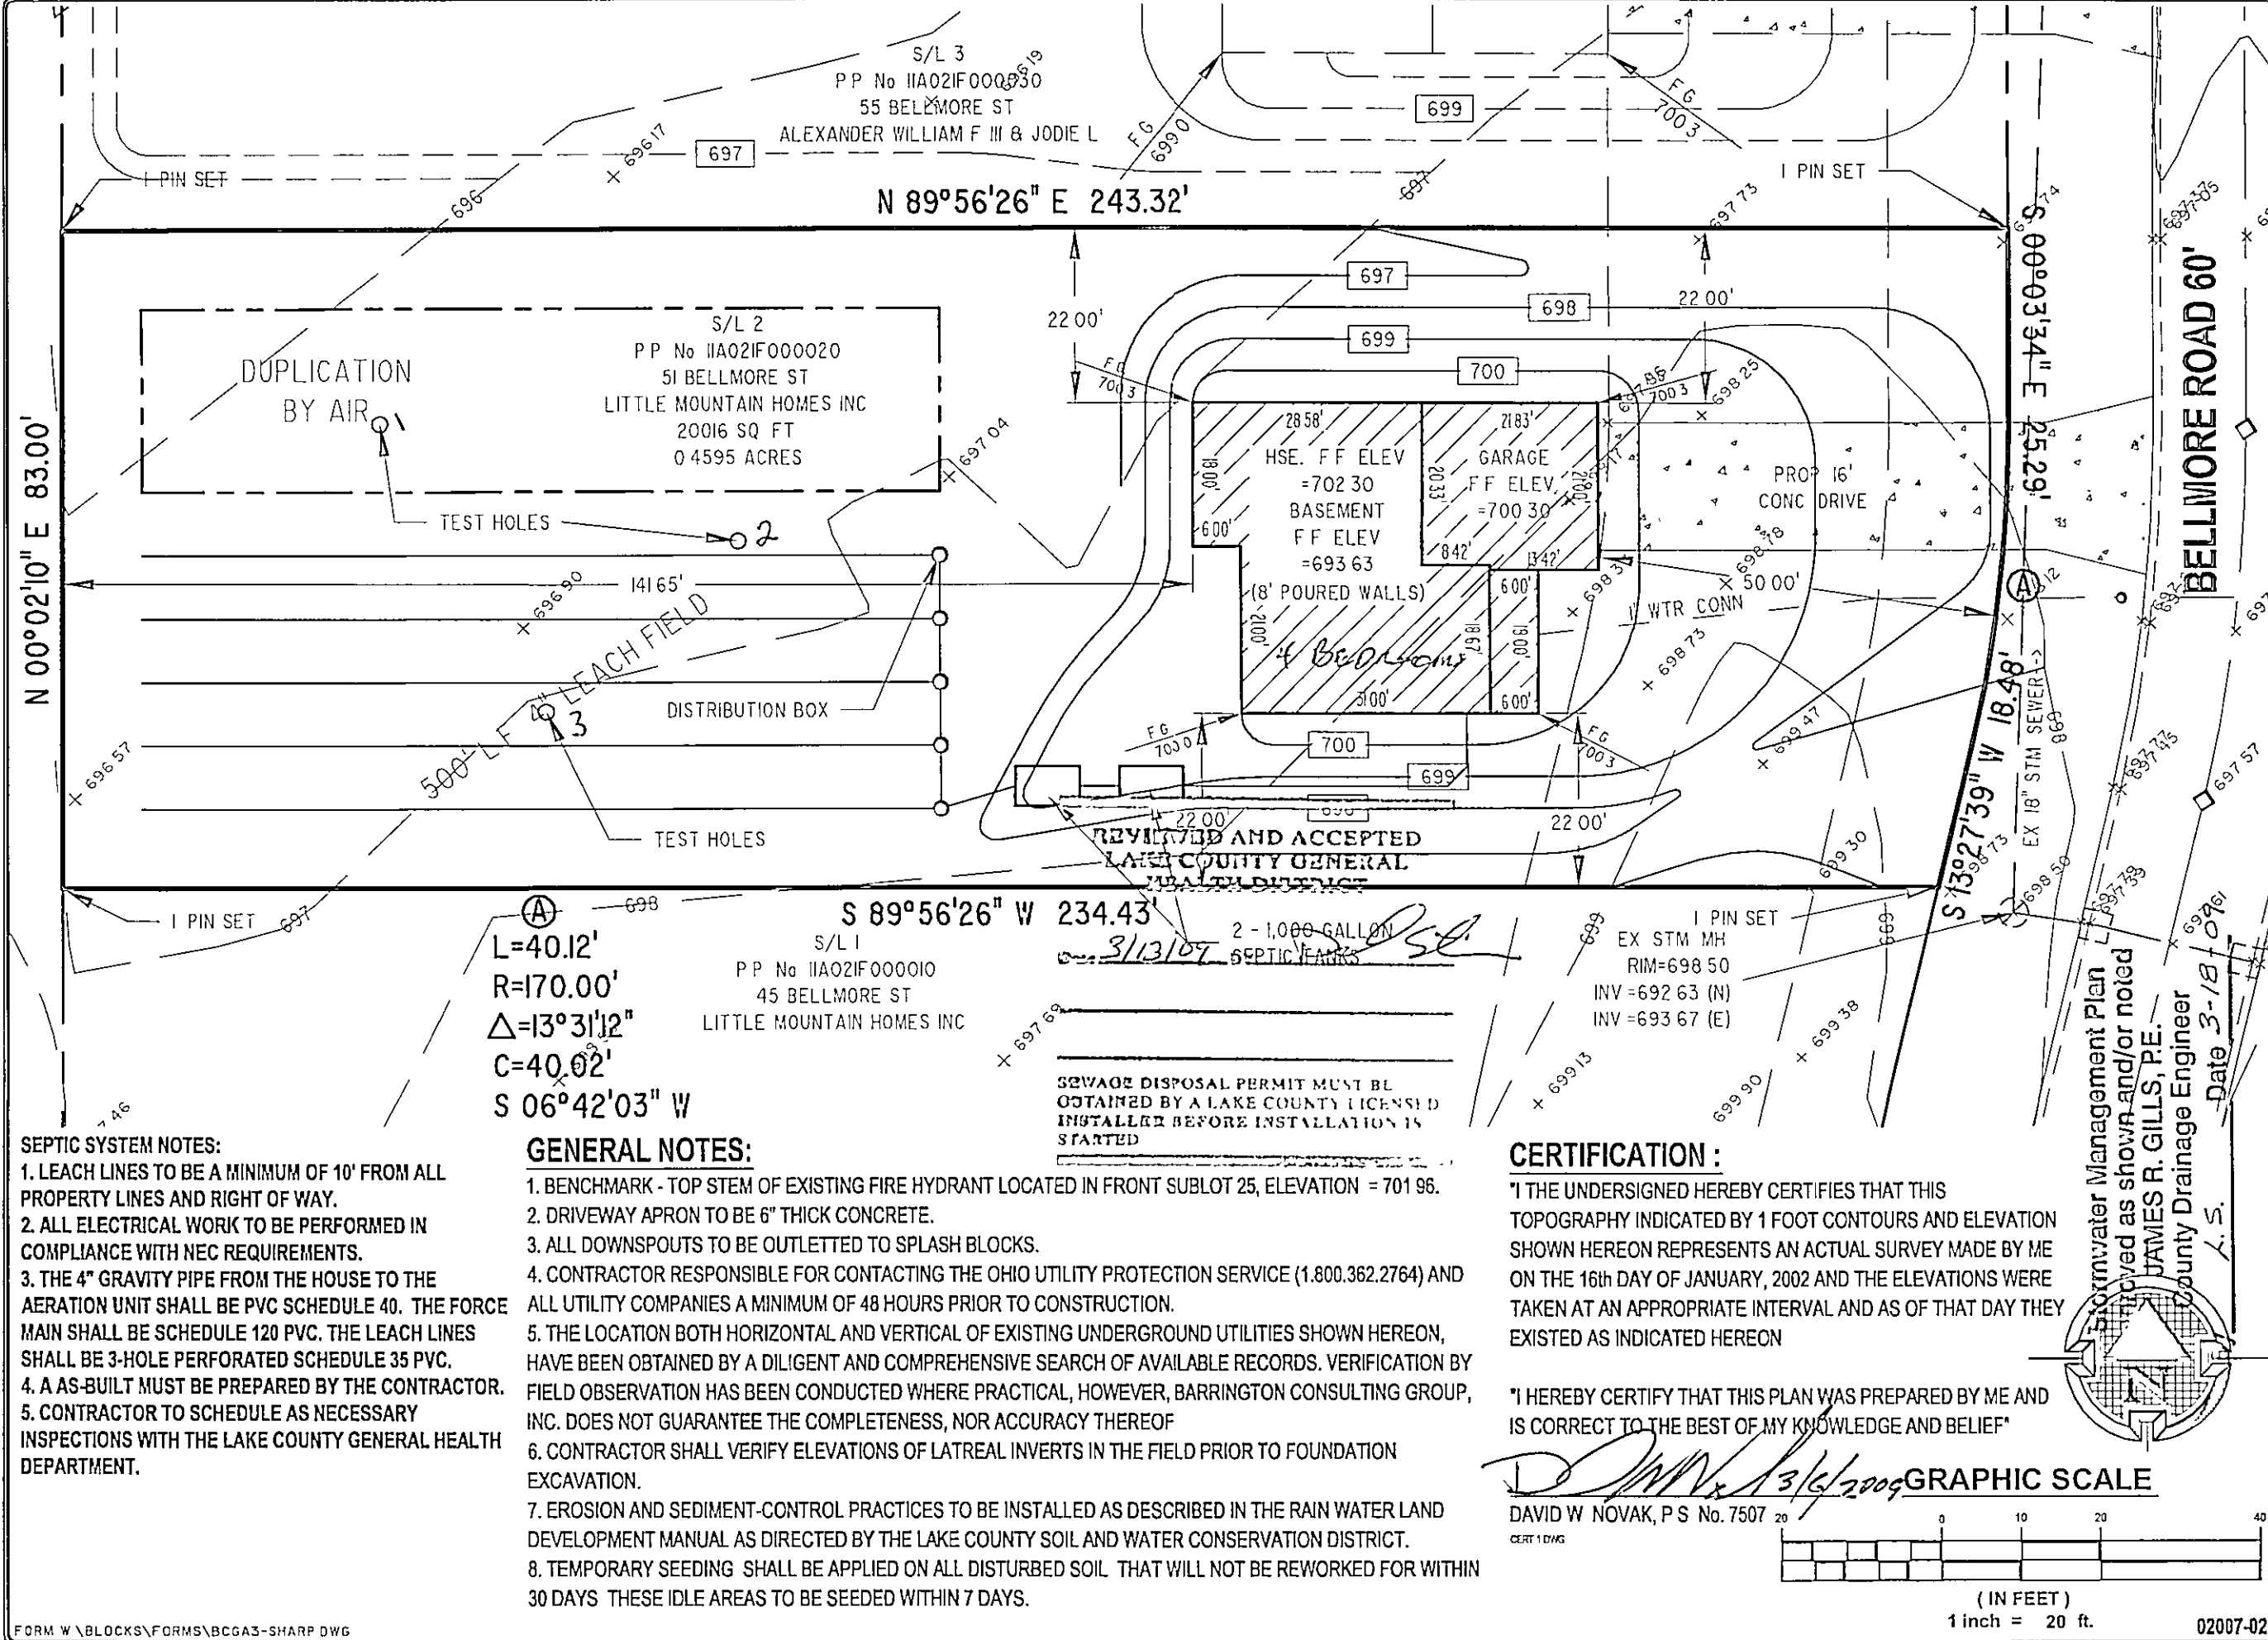

SEPTIC SYSTEM NOTES:

1. LEACH LINES TO BE A MINIMUM OF 10' FROM ALL PROPERTY LINES AND RIGHT OF WAY.
2. ALL ELECTRICAL WORK TO BE PERFORMED IN COMPLIANCE WITH NEC REQUIREMENTS.
3. THE 4" GRAVITY PIPE FROM THE HOUSE TO THE AERATION UNIT SHALL BE PVC SCHEDULE 40. THE FORCE MAIN SHALL BE SCHEDULE 120 PVC. THE LEACH LINES SHALL BE 3-HOLE PERFORATED SCHEDULE 35 PVC.
4. A AS-BUILT MUST BE PREPARED BY THE CONTRACTOR.
5. CONTRACTOR TO SCHEDULE AS NECESSARY INSPECTIONS WITH THE LAKE COUNTY GENERAL HEALTH DEPARTMENT.

GENERAL NOTES:

1. BENCHMARK - TOP STEM OF EXISTING FIRE HYDRANT LOCATED IN FRONT SUBLOT 25, ELEVATION = 701.95.
2. DRIVEWAY APRON TO BE 6" THICK CONCRETE.
3. ALL DOWNSPOUTS TO BE OUTLETED TO SPLASH BLOCKS.
4. CONTRACTOR RESPONSIBLE FOR CONTACTING THE OHIO UTILITY PROTECTION SERVICE (1.800.362.2764) AND ALL UTILITY COMPANIES A MINIMUM OF 48 HOURS PRIOR TO CONSTRUCTION.
5. THE LOCATION BOTH HORIZONTAL AND VERTICAL OF EXISTING UNDERGROUND UTILITIES SHOWN HEREON, HAVE BEEN OBTAINED BY A DILIGENT AND COMPREHENSIVE SEARCH OF AVAILABLE RECORDS. VERIFICATION BY FIELD OBSERVATION HAS BEEN CONDUCTED WHERE PRACTICAL, HOWEVER, BARRINGTON CONSULTING GROUP, INC. DOES NOT GUARANTEE THE COMPLETENESS, NOR ACCURACY THEREOF
6. CONTRACTOR SHALL VERIFY ELEVATIONS OF LATREAL INVERTS IN THE FIELD PRIOR TO FOUNDATION EXCAVATION.
7. EROSION AND SEDIMENT-CONTROL PRACTICES TO BE INSTALLED AS DESCRIBED IN THE RAIN WATER LAND DEVELOPMENT MANUAL AS DIRECTED BY THE LAKE COUNTY SOIL AND WATER CONSERVATION DISTRICT.
8. TEMPORARY SEEDING SHALL BE APPLIED ON ALL DISTURBED SOIL THAT WILL NOT BE REWORKED FOR WITHIN 30 DAYS THESE IDLE AREAS TO BE SEEDED WITHIN 7 DAYS.

CERTIFICATION :

"I THE UNDERSIGNED HEREBY CERTIFIES THAT THIS TOPOGRAPHY INDICATED BY 1 FOOT CONTOURS AND ELEVATION SHOWN HEREON REPRESENTS AN ACTUAL SURVEY MADE BY ME ON THE 16th DAY OF JANUARY, 2002 AND THE ELEVATIONS WERE TAKEN AT AN APPROPRIATE INTERVAL AND AS OF THAT DAY THEY EXISTED AS INDICATED HEREON

"I HEREBY CERTIFY THAT THIS PLAN WAS PREPARED BY ME AND IS CORRECT TO THE BEST OF MY KNOWLEDGE AND BELIEF"

David W. Novak
DAVID W. NOVAK, P S No. 7507
CERT 1 DWG

