



SITE PLAN FOR ERIE HOMES

Being Sublot No. 81, Block 6 of the Painesville
—on—the—Lake Subdivision, in the Township of
Painesville, Lake County, Ohio.


VILLAGE SURVEYING COMPANY

P. O. BOX 1096, FAIRPORT HARBOR, OH 44077


PHONE (440) 357-1359 - CELL (440) 413-0527

Grading Plan Approved
as shown and/or noted
JAMES R. GILLS, P.E.
Lake County Engineer

Date 9/23/02

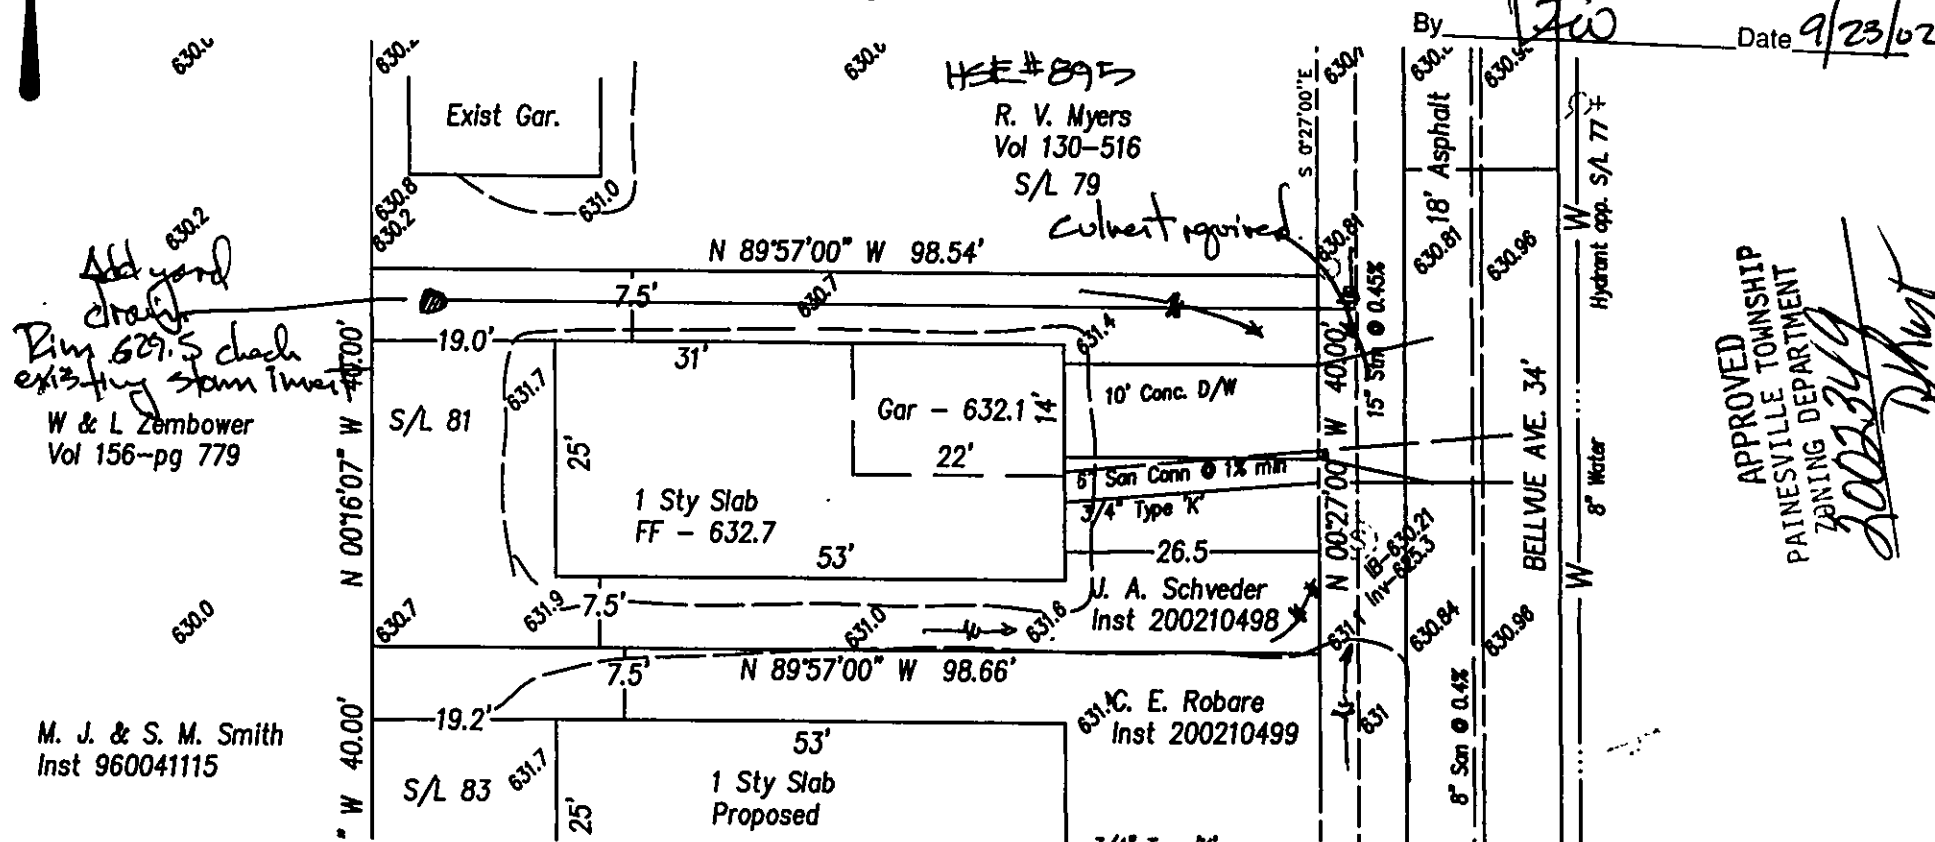

APPROVED
PAINESVILLE TOWNSHIP
ZONING DEPARTMENT
2002349
R. Hunt

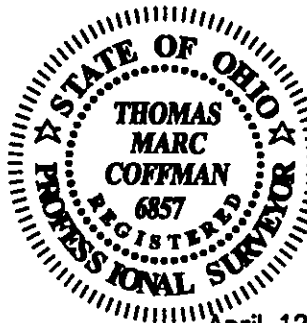

April 12, 2002

I, the undersigned hereby certify that the boundary survey represented by this plat and that all monumentation set has been done in accordance with the specifications set forth in Chapter 4733-37 of the Ohio Administrative Code.

I, further certify that the topography, indicated by 1 foot contours and elevations shown hereon represent an actual field survey made by me on March 3, 2002 and the elevations were taken at the appropriate intervals and that as of that date they existed as indicated hereon.

BENCHMARK - 631.62
N. Rim San MH S/L 87 C/L
INV. - 623.24

THOMAS COFFMAN P.S., DATE
REGISTERED SURVEYOR No. 5768
STATE OF OHIO