


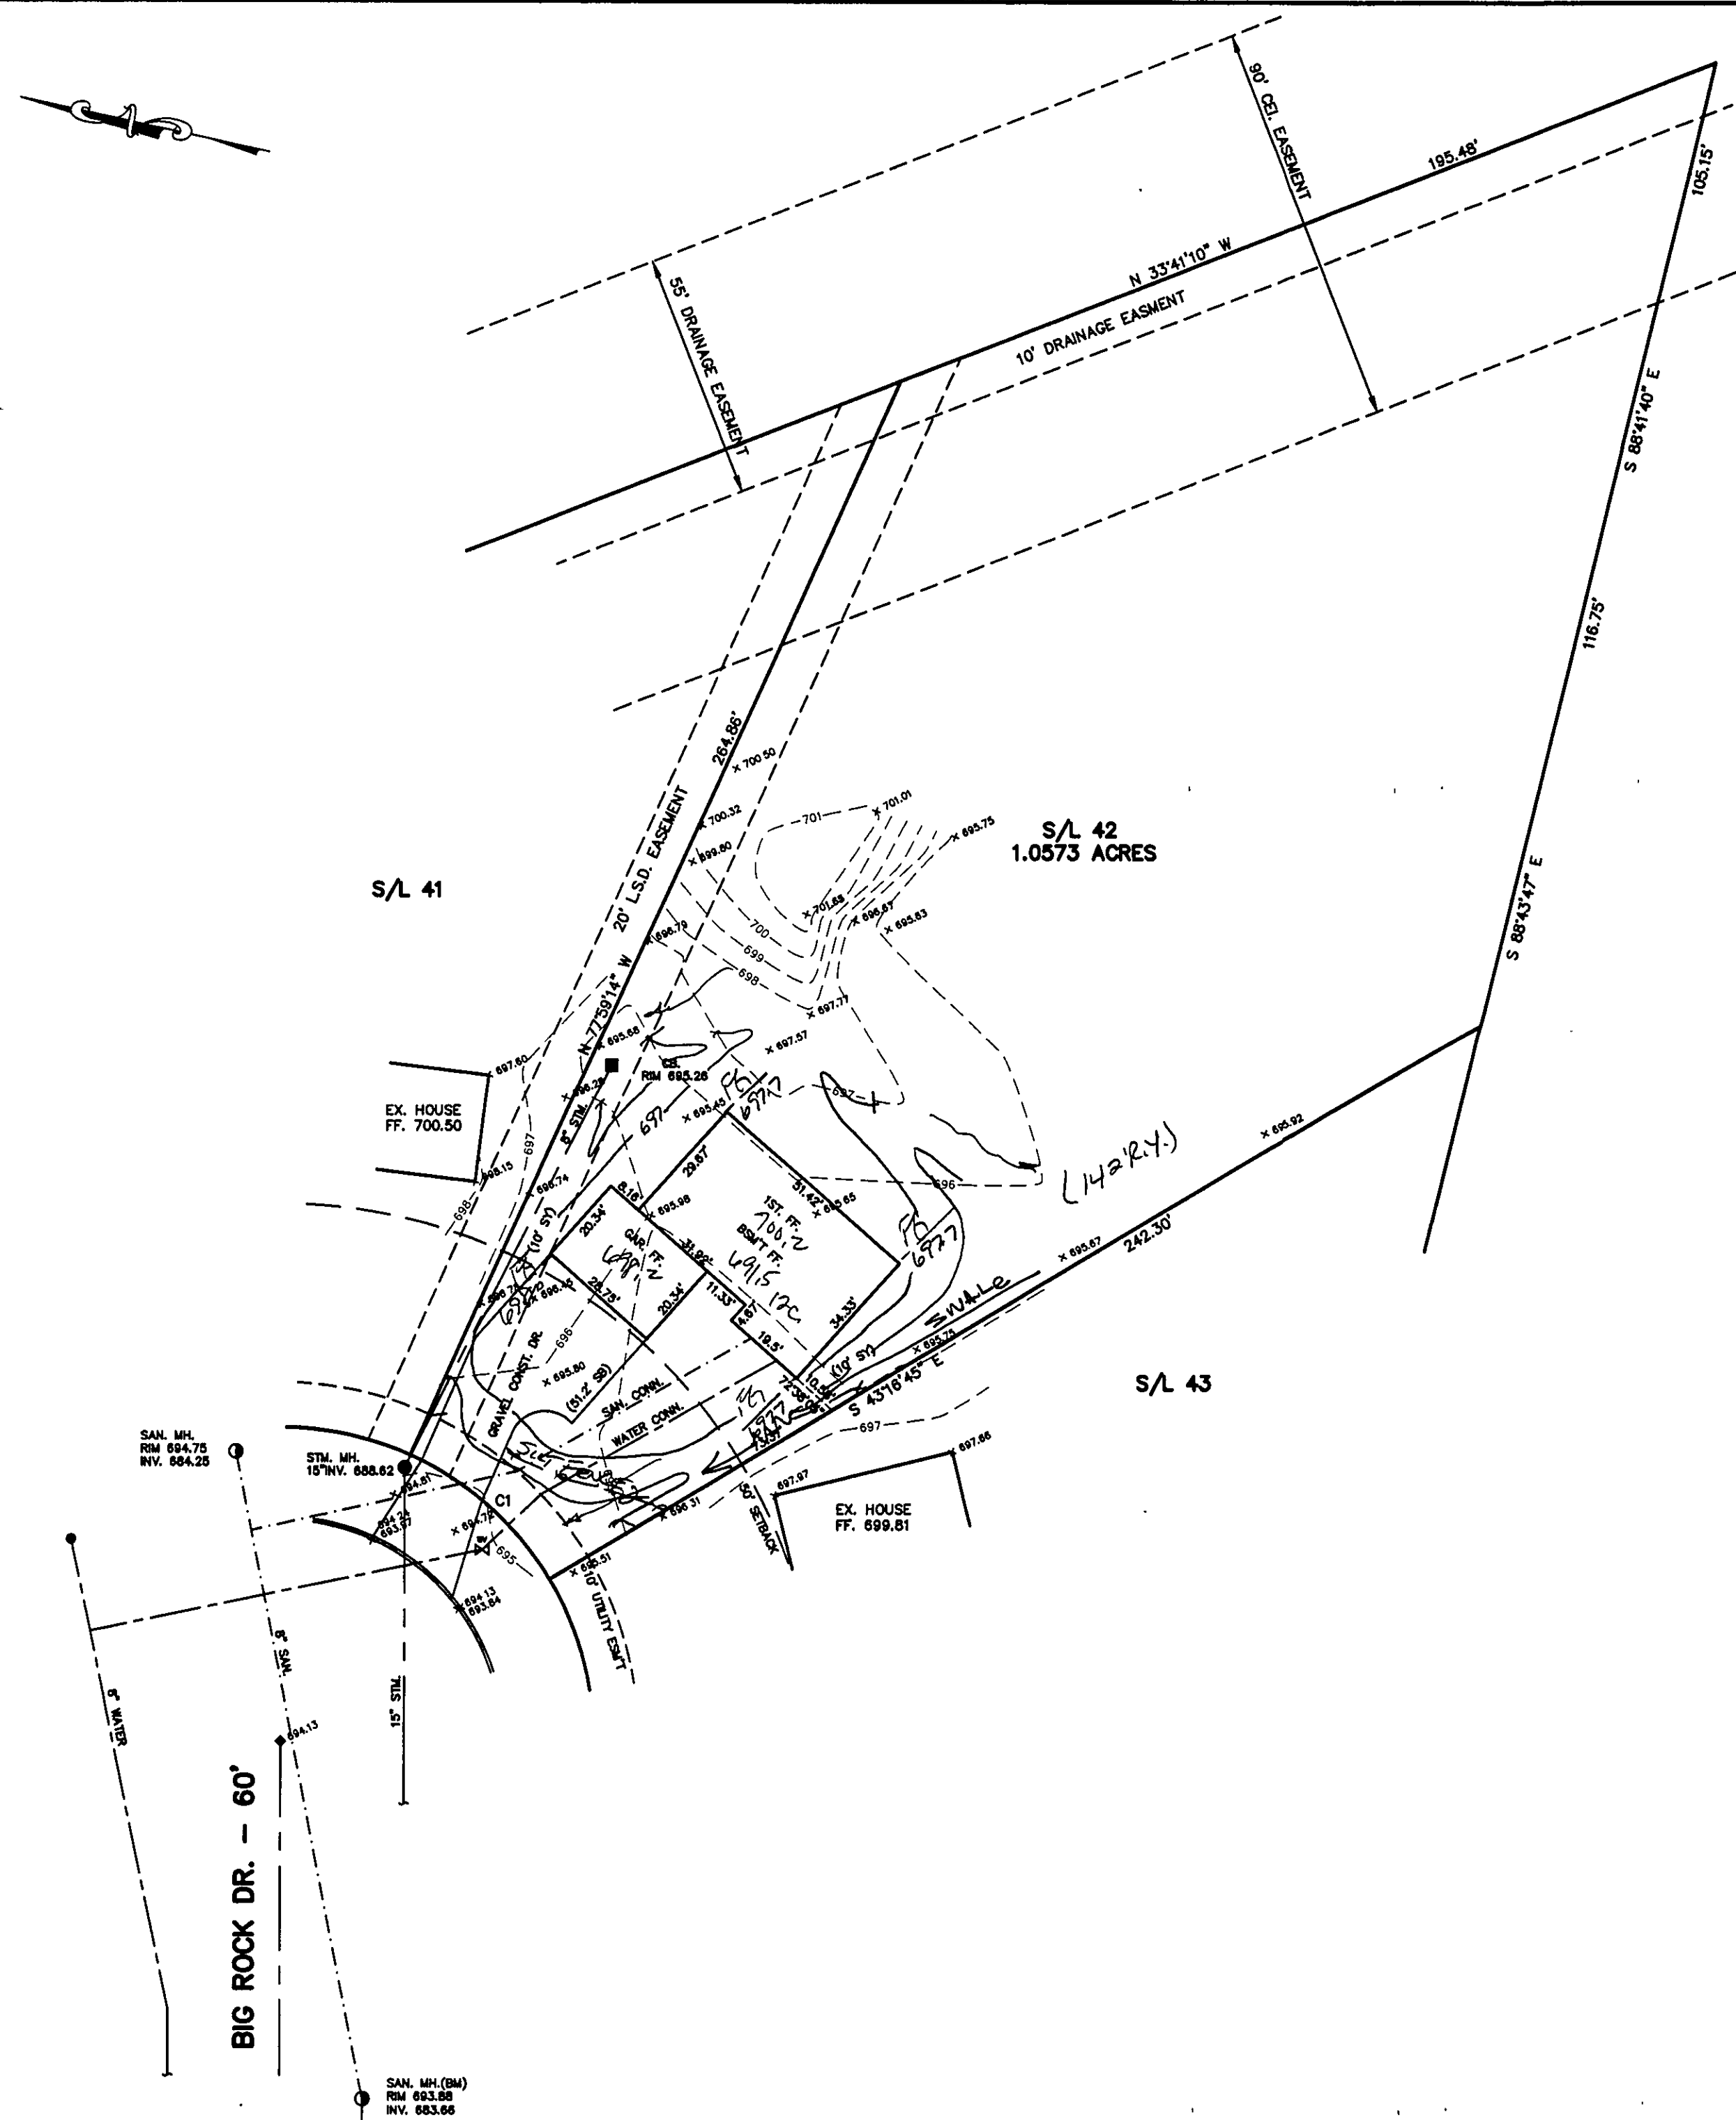

SITE PLAN

PAINESVILLE TWP., LAKE COUNTY, OHIO
for: CORNERSTONE HOMES
CLIENT OWNER
ADDRESS STREET CITY ZIP

EASTERN WOODLANDS
SUBDIVISION 34-19 NAME TRACT
VOL-PG. BIG ROCK DR. LOT STREET
42 SUBLOT NO. STREET VOL-PG. PERM. PARCEL NO.

LEGEND

SANITARY MANHOLE --- 100.0
STORM MANHOLE --- 100.0
INLET OR CATCH BASIN --- 100.0
HYDRANT --- 100.0
EXISTING CONTOURS ---
PROPOSED CONTOURS ---
EXIST. ELEV. --- 100.0
100.0 ± 2 PROP. ELEV.
AS BUILT ELEVATION
INDICATES DIRECTION OF SURFACE DRAINAGE

DESIGN CERTIFICATION

THIS PLAT WAS PREPARED BY ME, AND IS CORRECT TO THE BEST OF MY KNOWLEDGE AND BELIEF.

Harry S. Jones Jr. #6343
NAME SURVEYOR REGISTRATION NO.

REVISIONS			PLAN PREPARED BY:		
NO.	DATE	BY	BABCOCK JONES & ASSOCIATES, INC.		
1			PAINESVILLE, OHIO		
2			DRAWN BY T.R.	SCALE 1"=30'	PHONE NO. 440-357-1811
3			CHK'D. H.J.	DATE 9/25/01	DRAWING NO. 99-033-42
4			CREW CHIEF R.B.	APP'D H.J.	
5					

"AS BUILT" CERTIFICATION
I, HEREBY CERTIFY THAT THE CIRCLED GRADES ARE EXISTING FINISH GRADES CHECKED IN THE FIELD ON 9/25/01, 2001 AND ARE CORRECT TO THE BEST OF MY KNOWLEDGE AND BELIEF.

REGISTERED SURVEYOR REG. NO.
C1: R=70.00'
L=42.41'
T=21.88'
D=34°42'35"
C=41.76'
N29°21'20"E
BM-SANITARY MANHOLE #7
RIM=693.88

NOTE: TEMPORARY SEEDING REQUIRED IN DISTURBED AREAS.

Grading Plan Approved as shown and/or noted
JAMES R. GILLS, P.E.
Lake County Engineer
By *TAM* Date 10/11/01
SWARE AS SHOWN
Rel. zoning permit # 2001327

ROOF DRAINS SHALL DISCHARGE TO SPLASH BLOCKS.

