




APPROVED
PAINEVILLE TOWNSHIP
ZONING DEPARTMENT

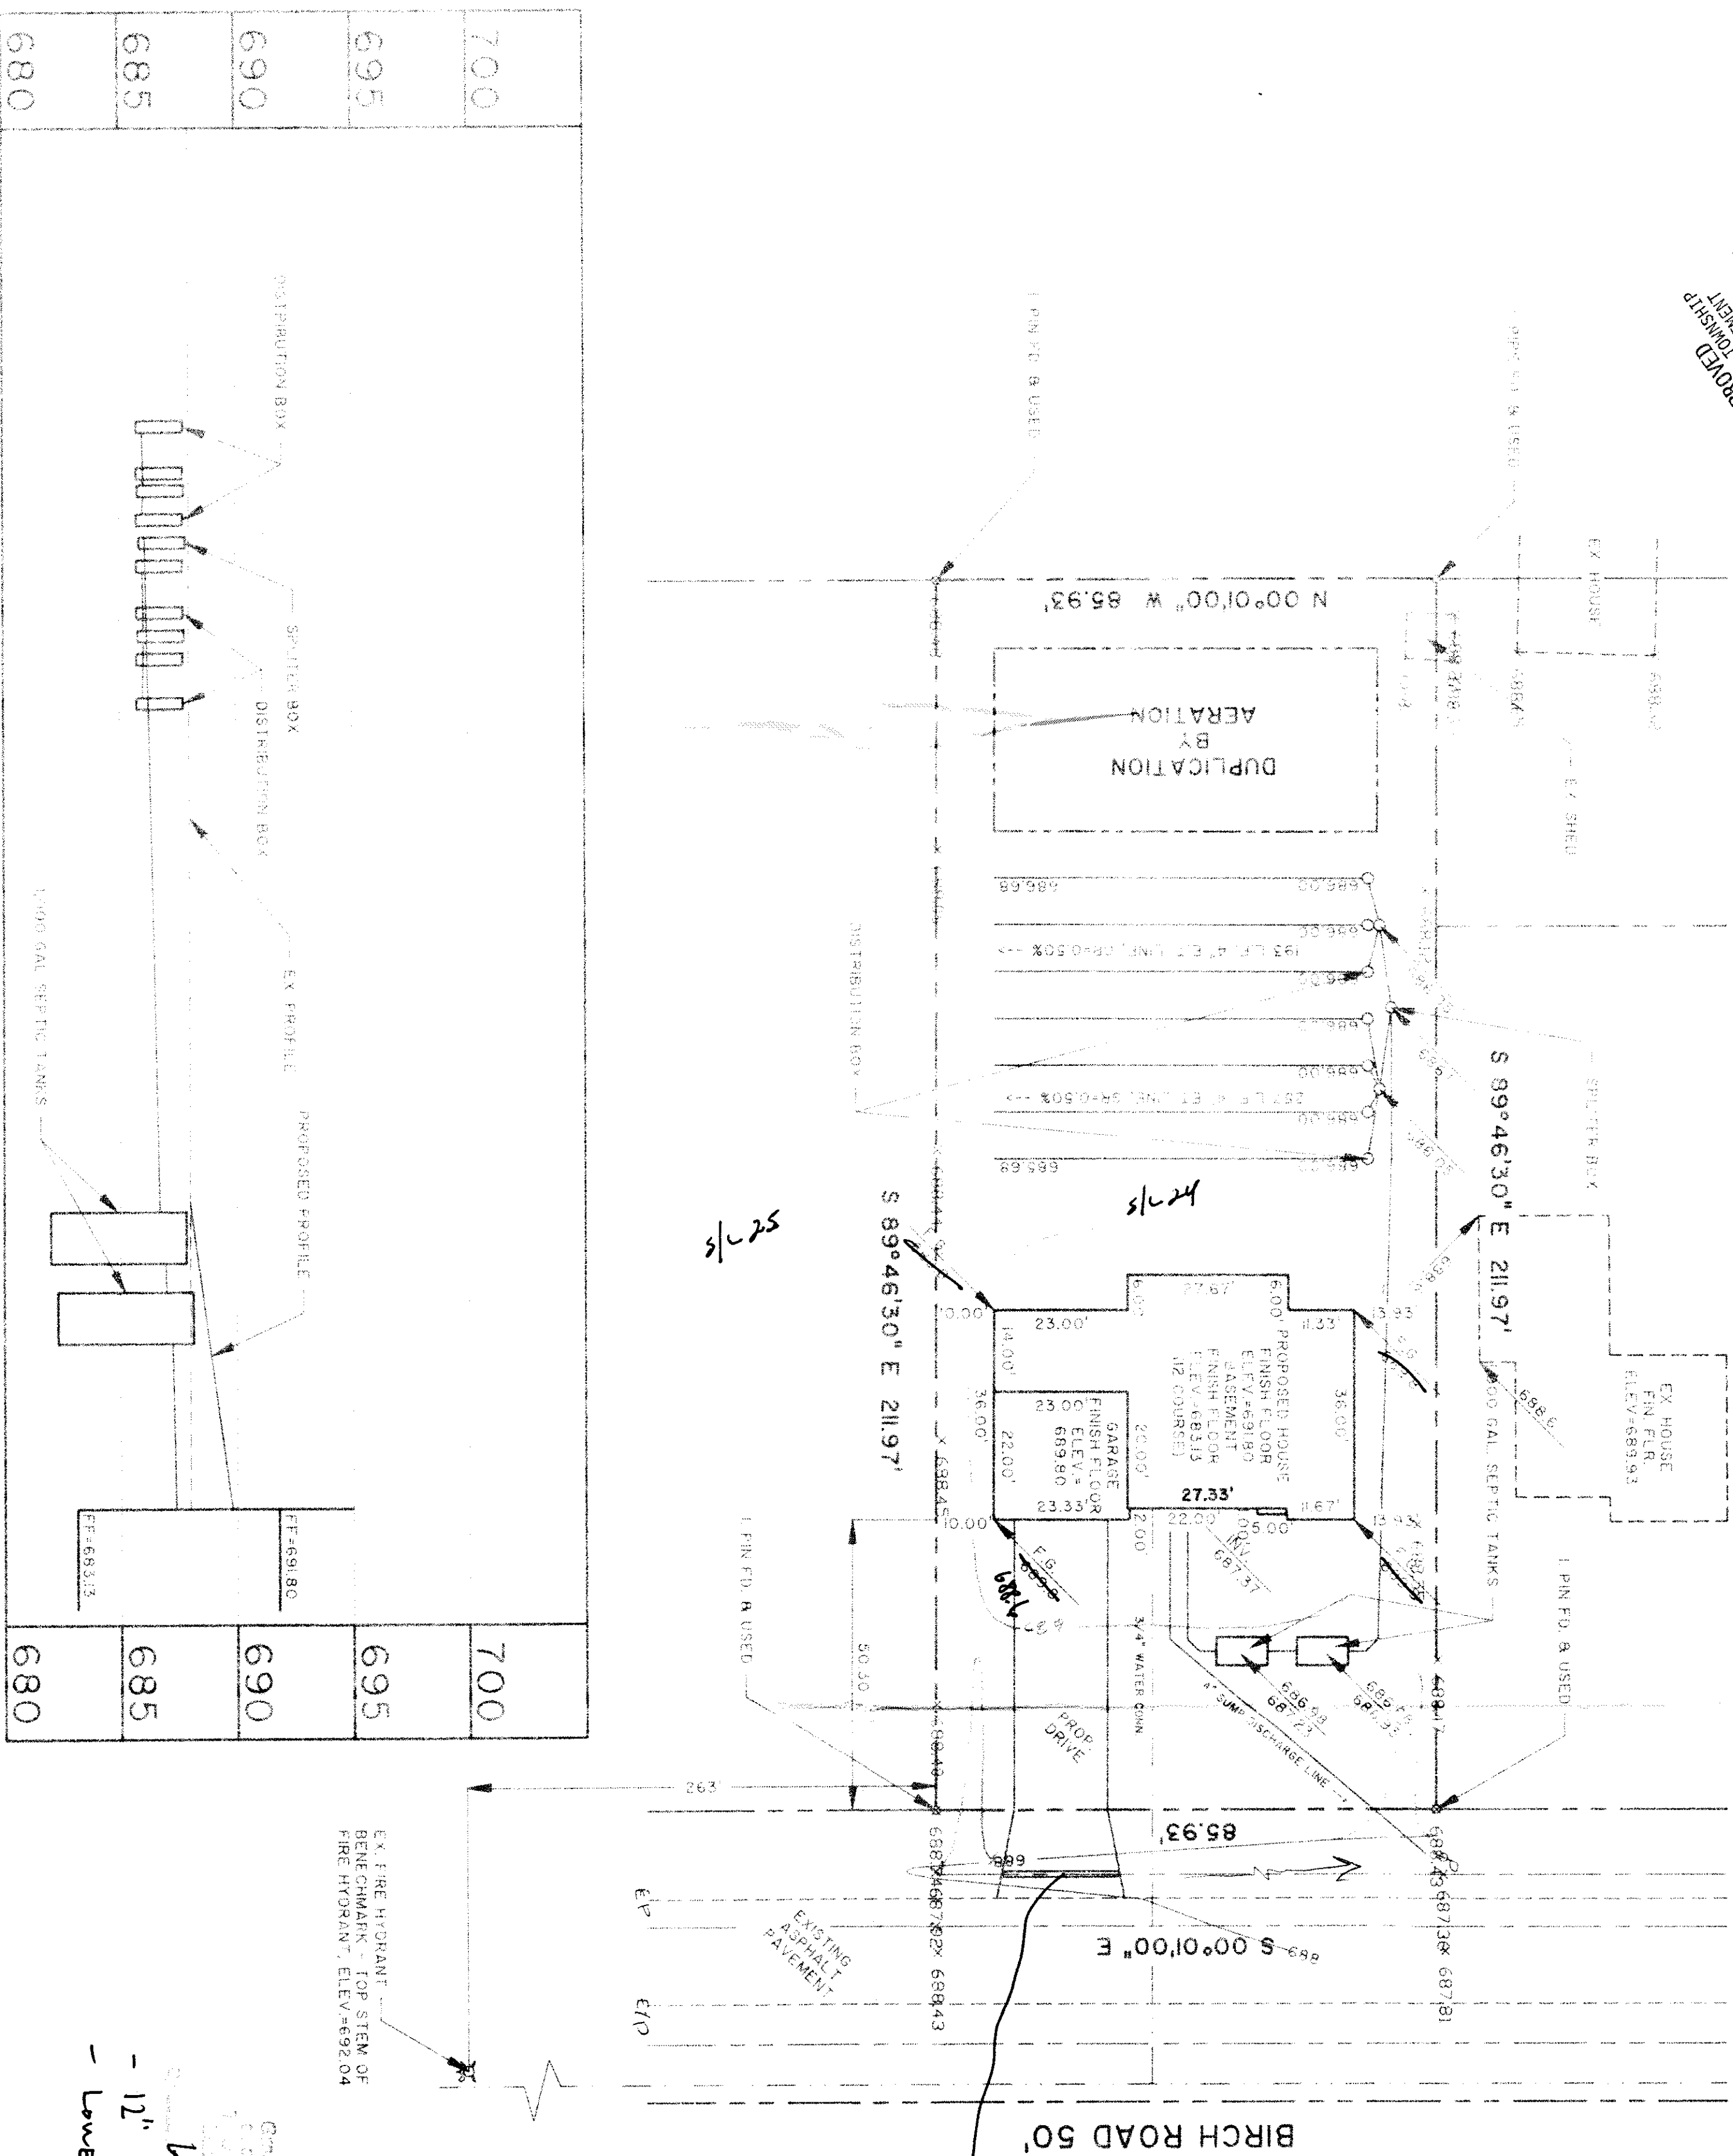

* THE STANDARD TRENCH IS 24 INCHES
WIDE. THE TRENCH DEPTH Varies FROM 18
INCHES TO 30 INCHES DEEP. THE SAND AT
THE TOP OF THE TRENCH WILL VARY FROM 10
TO 18 INCHES DEEP.

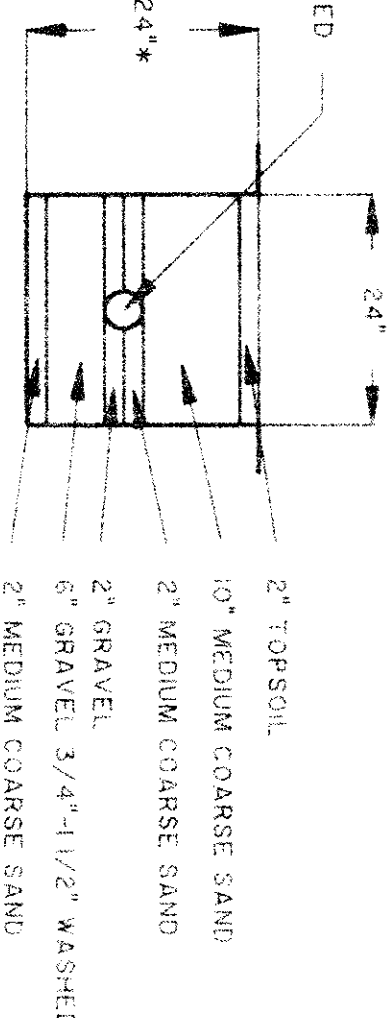

TYPICAL EVAPOTRANSPIRATION TRENCH CROSS SECTION

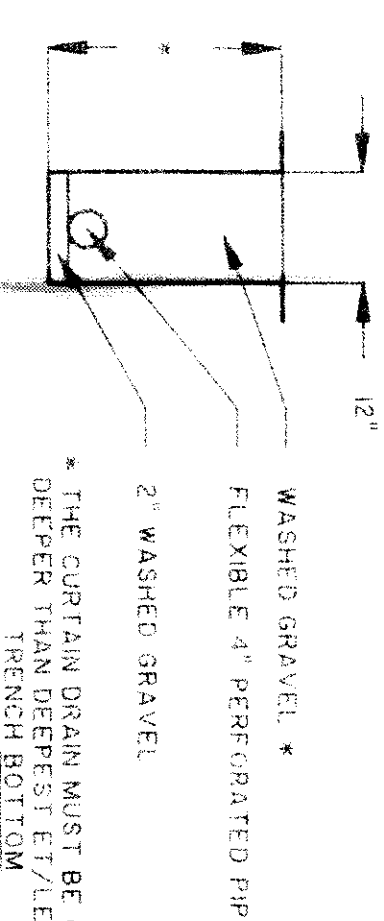

TYPICAL CURTAIN DRAIN CROSS SECTION

GENERAL NOTES:

1. ADJUST ALL TANKS AND BOXES TO GRADE.
2. BENCHMARK - TOP STEM OF FIRE HYDRANT LOCATED 263 SOUTH, ELEV.=692.04

LEGEND

- EXISTING CONTOUR
- PROPOSED CONTOUR
- EXISTING ELEVATION
- PROPOSED ELEVATION

CERTIFICATION


"I, THE UNDERSIGNED HEREBY CERTIFY THAT THIS TOPOGRAPHY INDICATED BY F CONTOURS AND ELEVATIONS SHOWN HEREON REPRESENTS AN ACTUAL SURVEY MADE BY ME ON THE 10th DAY OF JUNE, 1996 AND THE ELEVATIONS WERE TAKEN AT APPROPRIATE INTERVALS AND AS OF THAT DAY THEY EXISTED AS INDICATED HEREON.

"I HEREBY CERTIFY THAT THIS PLAN WAS PREPARED BY ME AND IS CORRECT TO THE BEST OF MY KNOWLEDGE"

DAVID W. NOVAK, P.E. REG. 1557

SEAL OF THE PROFESSIONAL ENGINEER
DAVID W. NOVAK, P.E. REG. 1557
STATE OF OHIO
EXPIRATION DATE 12-31-99

GRAPHIC SCALE

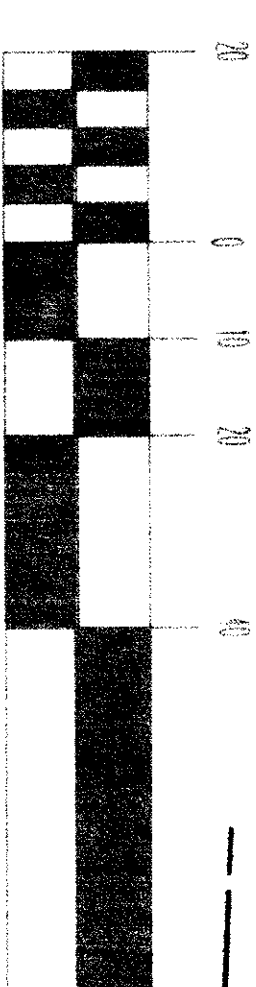

LOW YIELD WATER FIXTURES REQUIRED ON ALL:

- Shower Head
- Toilet

Building and Zoning
LAKESIDE GENERAL ALTH DISTRICT
Date: 7-2-96
By: J. L. Linder
JOEL LINDER, R. S. L. R. H.
Main Commissioner

Himebaugh and Novak
Surveyors and Site Consultants
8663 Tyler Boulevard
Mentor, Ohio 44060-4346

LITTLE MOUNTAIN HOMES, INC.
1447 NORTH RIDGE ROAD, PAINESVILLE, OH 44077

DATE: JUNE 25, 1996
DRAWN BY: D. W. NOVAK
CHECKED BY: DWN
ZP=NOTED BY:

SITE PLAN
PP-11B-034C-00-024, BIRCH ROAD, PAINESVILLE, TWP.

96045-24
SHEET NO. 01