


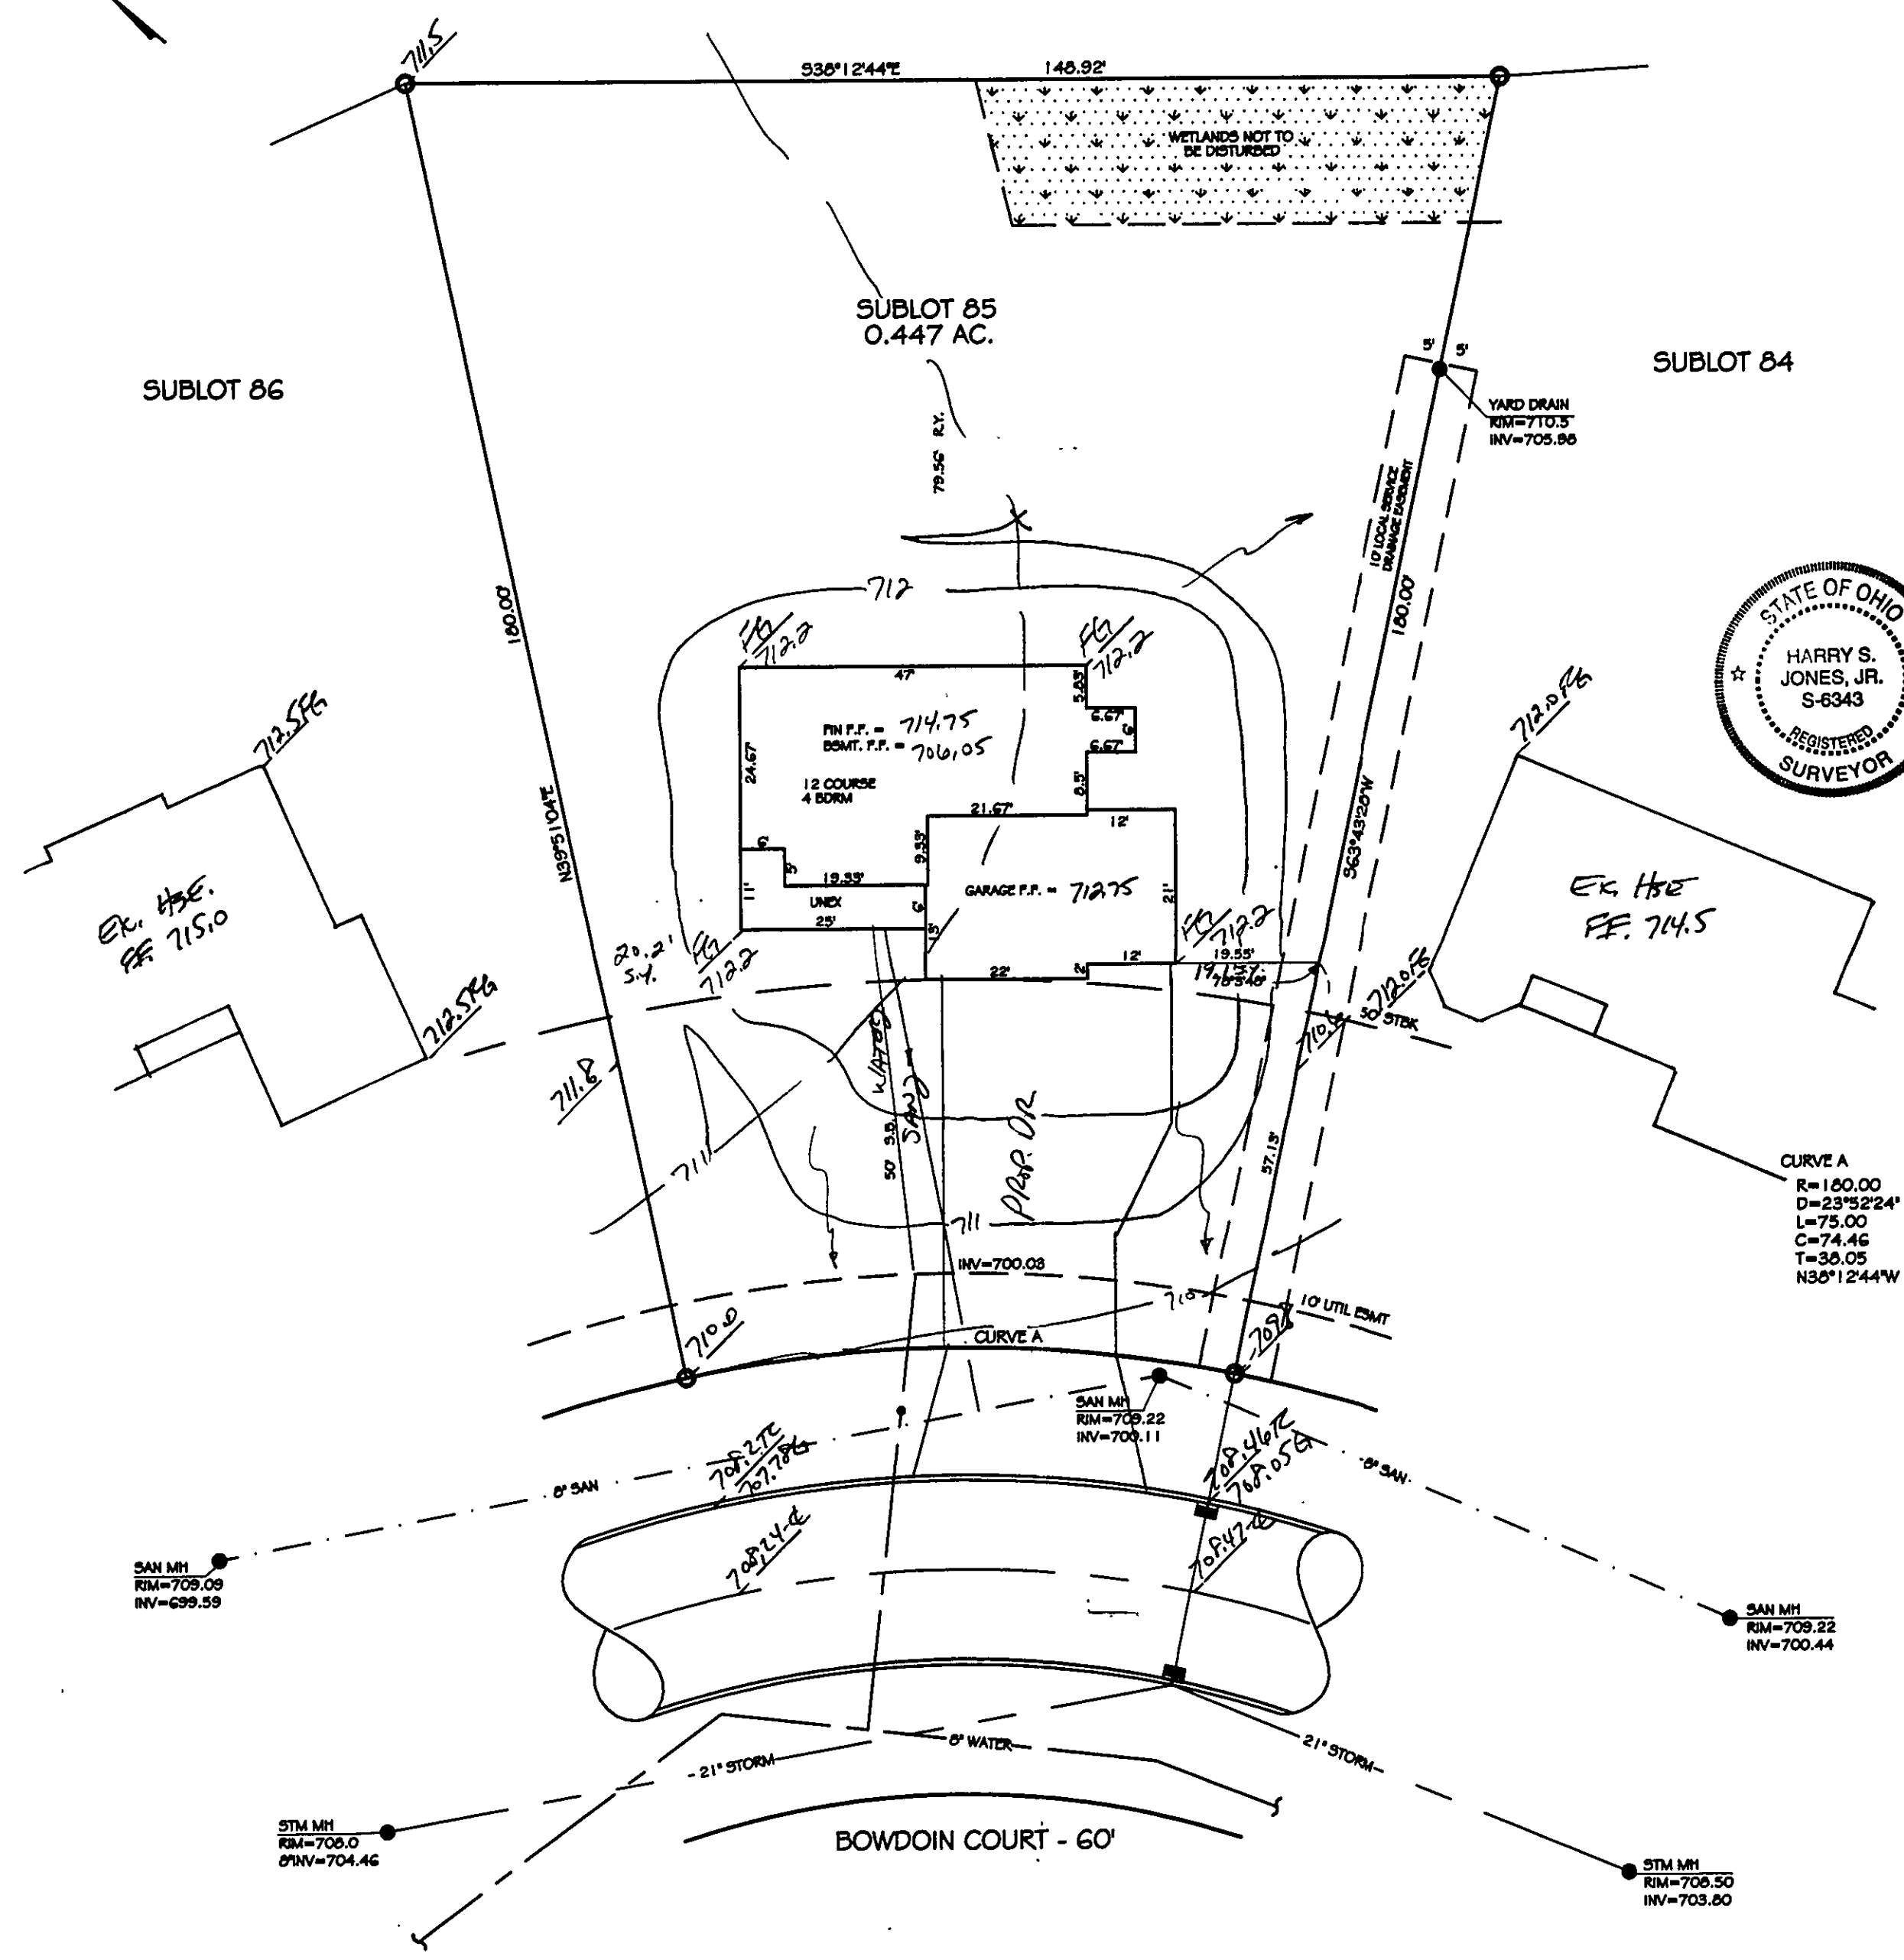

SITE PLAN

PAINESVILLE TWP., LAKE COUNTY, OHIO

for: **MARUT** 428-9506
CLIENT OWNER
ADDRESS STREET CITY ZIP

HEATHERSTONE SUB
SUBDIVISION **31-21** NAME TRACT STREET
VOL.-PG. **BOWDOIN COURT** LOT
SUBLOT NO. STREET VOL.-PG. PERM. PARCEL NO.

LEGEND

SANITARY MANHOLE ---●---
STORM MANHOLE ---■---
INLET OR CATCH BASIN ---◇---
HYDRANT ---◇---
EXISTING CONTOURS ---
PROPOSED CONTOURS ---
EXIST. ELEV. ---100.0
100.0 ±2 PROP. ELEV.
AS BUILT ELEVATION
INDICATES DIRECTION OF SURFACE DRAINAGE

REMARKS

ALL BOUNDARY DATA SHOWN WAS OBTAINED FROM (DEEDS, RECORDED SUBDIVISION PLAT OR OTHER PUBLIC RECORDS)
LOCATIONS AS SHOWN OF ADJACENT WELLS AND SEPTIC TANKS OBTAINED FROM LAKE COUNTY HEALTH DEPARTMENT

DESIGN CERTIFICATION

THIS PLAT WAS PREPARED BY ME, AND IS CORRECT TO THE BEST OF MY KNOWLEDGE AND BELIEF.
NAME *Harry S. Jones, Jr.* SURVEYOR REGISTRATION NO. *6343*

CHECK LIST

NO. OF BEDROOMS
DIMENSIONS
BEARINGS
TIE TO NEAREST STREET
SUBLOT NO. PARCEL NO.
SURROUNDING OWNERS
BLDG. DIMENSIONS FIN. GR.
BLDG. TIES FL'R. GRADES
APRON TYPE WIDTH THICKNESS
SIDEWALK TYPE WIDTH THICKNESS
CULVERT TYPE DIA., LENGTH
ROCK OUTCROPPINGS
WATER MAIN SIZE, LOCATION
SAN. SEWER SIZE & GR. LOC.
SAN. MH. CAST. ELEV. INV. ELEV.
SAN. CONN. SIZE, LOC. DEPTH
STORM SEWER SIZE & GR. LOC.
STORM MH. CAST ELEV. INV. ELEV.
PAV'TYPE GRADE CURBS
GAS LINE LOC. SIZE PRESSURE
SEPTIC TANK LOCATION & DUPLICATION AREA
WELL LOCATION
ISOLATION RADIUS FROM WELL

REVISIONS			PLAN PREPARED BY:		
NO.	DATE	BY	BABCOCK JONES & ASSOCIATES, INC.		
1			PAINESVILLE, OHIO		
2			DRAWN BY	M.S.	SCALE 1"=20'
3			CHK'D.	H.J.	DATE 7/20/98
4			CREW	W.D.	APP'D H.J.
5			CHIEF		PHONE NO. 440-357-1811
					DRAWING NO. 92-186-85

"AS BUILT" CERTIFICATION
I, HEREBY CERTIFY THAT THE CIRCLED GRADES ARE EXISTING FINISH GRADES CHECKED IN THE FIELD ON _____, 19____ AND ARE CORRECT TO THE BEST OF MY KNOWLEDGE AND BELIEF.

REGISTERED SURVEYOR REG. NO.

Grading Plan Approved as shown and/or not
THOMAS P. GILLES, Jr.
Lake County Engineer

By *G.H.* Date *7.30.98*

APPROVED
PAINESVILLE TOWNSHIP
ZONING DEPARTMENT
19980724
D.R.