

REG. SURVEYOR NO. 15366

DESIGN CERTIFICATION
THIS PLAN WAS PREPARED BY ME,
AND IS CORRECT TO THE BEST OF
MY KNOWLEDGE AND BELIEF.


AS BUILT CERTIFICATION
I HEREBY CERTIFY THAT THE CIRCLED GRADES
ARE EXISTING FINISH GRADES CHECKED IN THE
FIELD ON
SURVEY IS CORRECT TO THE BEST OF MY
KNOWLEDGE AND BELIEF.



COLPETZER & WOODS
CONSULTANTS, INC.
9470 MENTOR AVENUE • MENTOR, OHIO 44066 • (216) 357-7569

DATE: June 28, 1982
SCALE: 1" = 20'
DRAWN BY: [Signature]
CHKD BY: [Signature]
JOB NO. 82-071
FB 431 PG 50

SITE PLAN FOR:
B.S.M. INC.
1251 MADISON AVE., FAIRBURN, OH.
BEING A PART OF ORIGINAL LOT NO. 20, TRACT 1
IN THE TOWNSHIP OF FAIRBURN, OHIO.

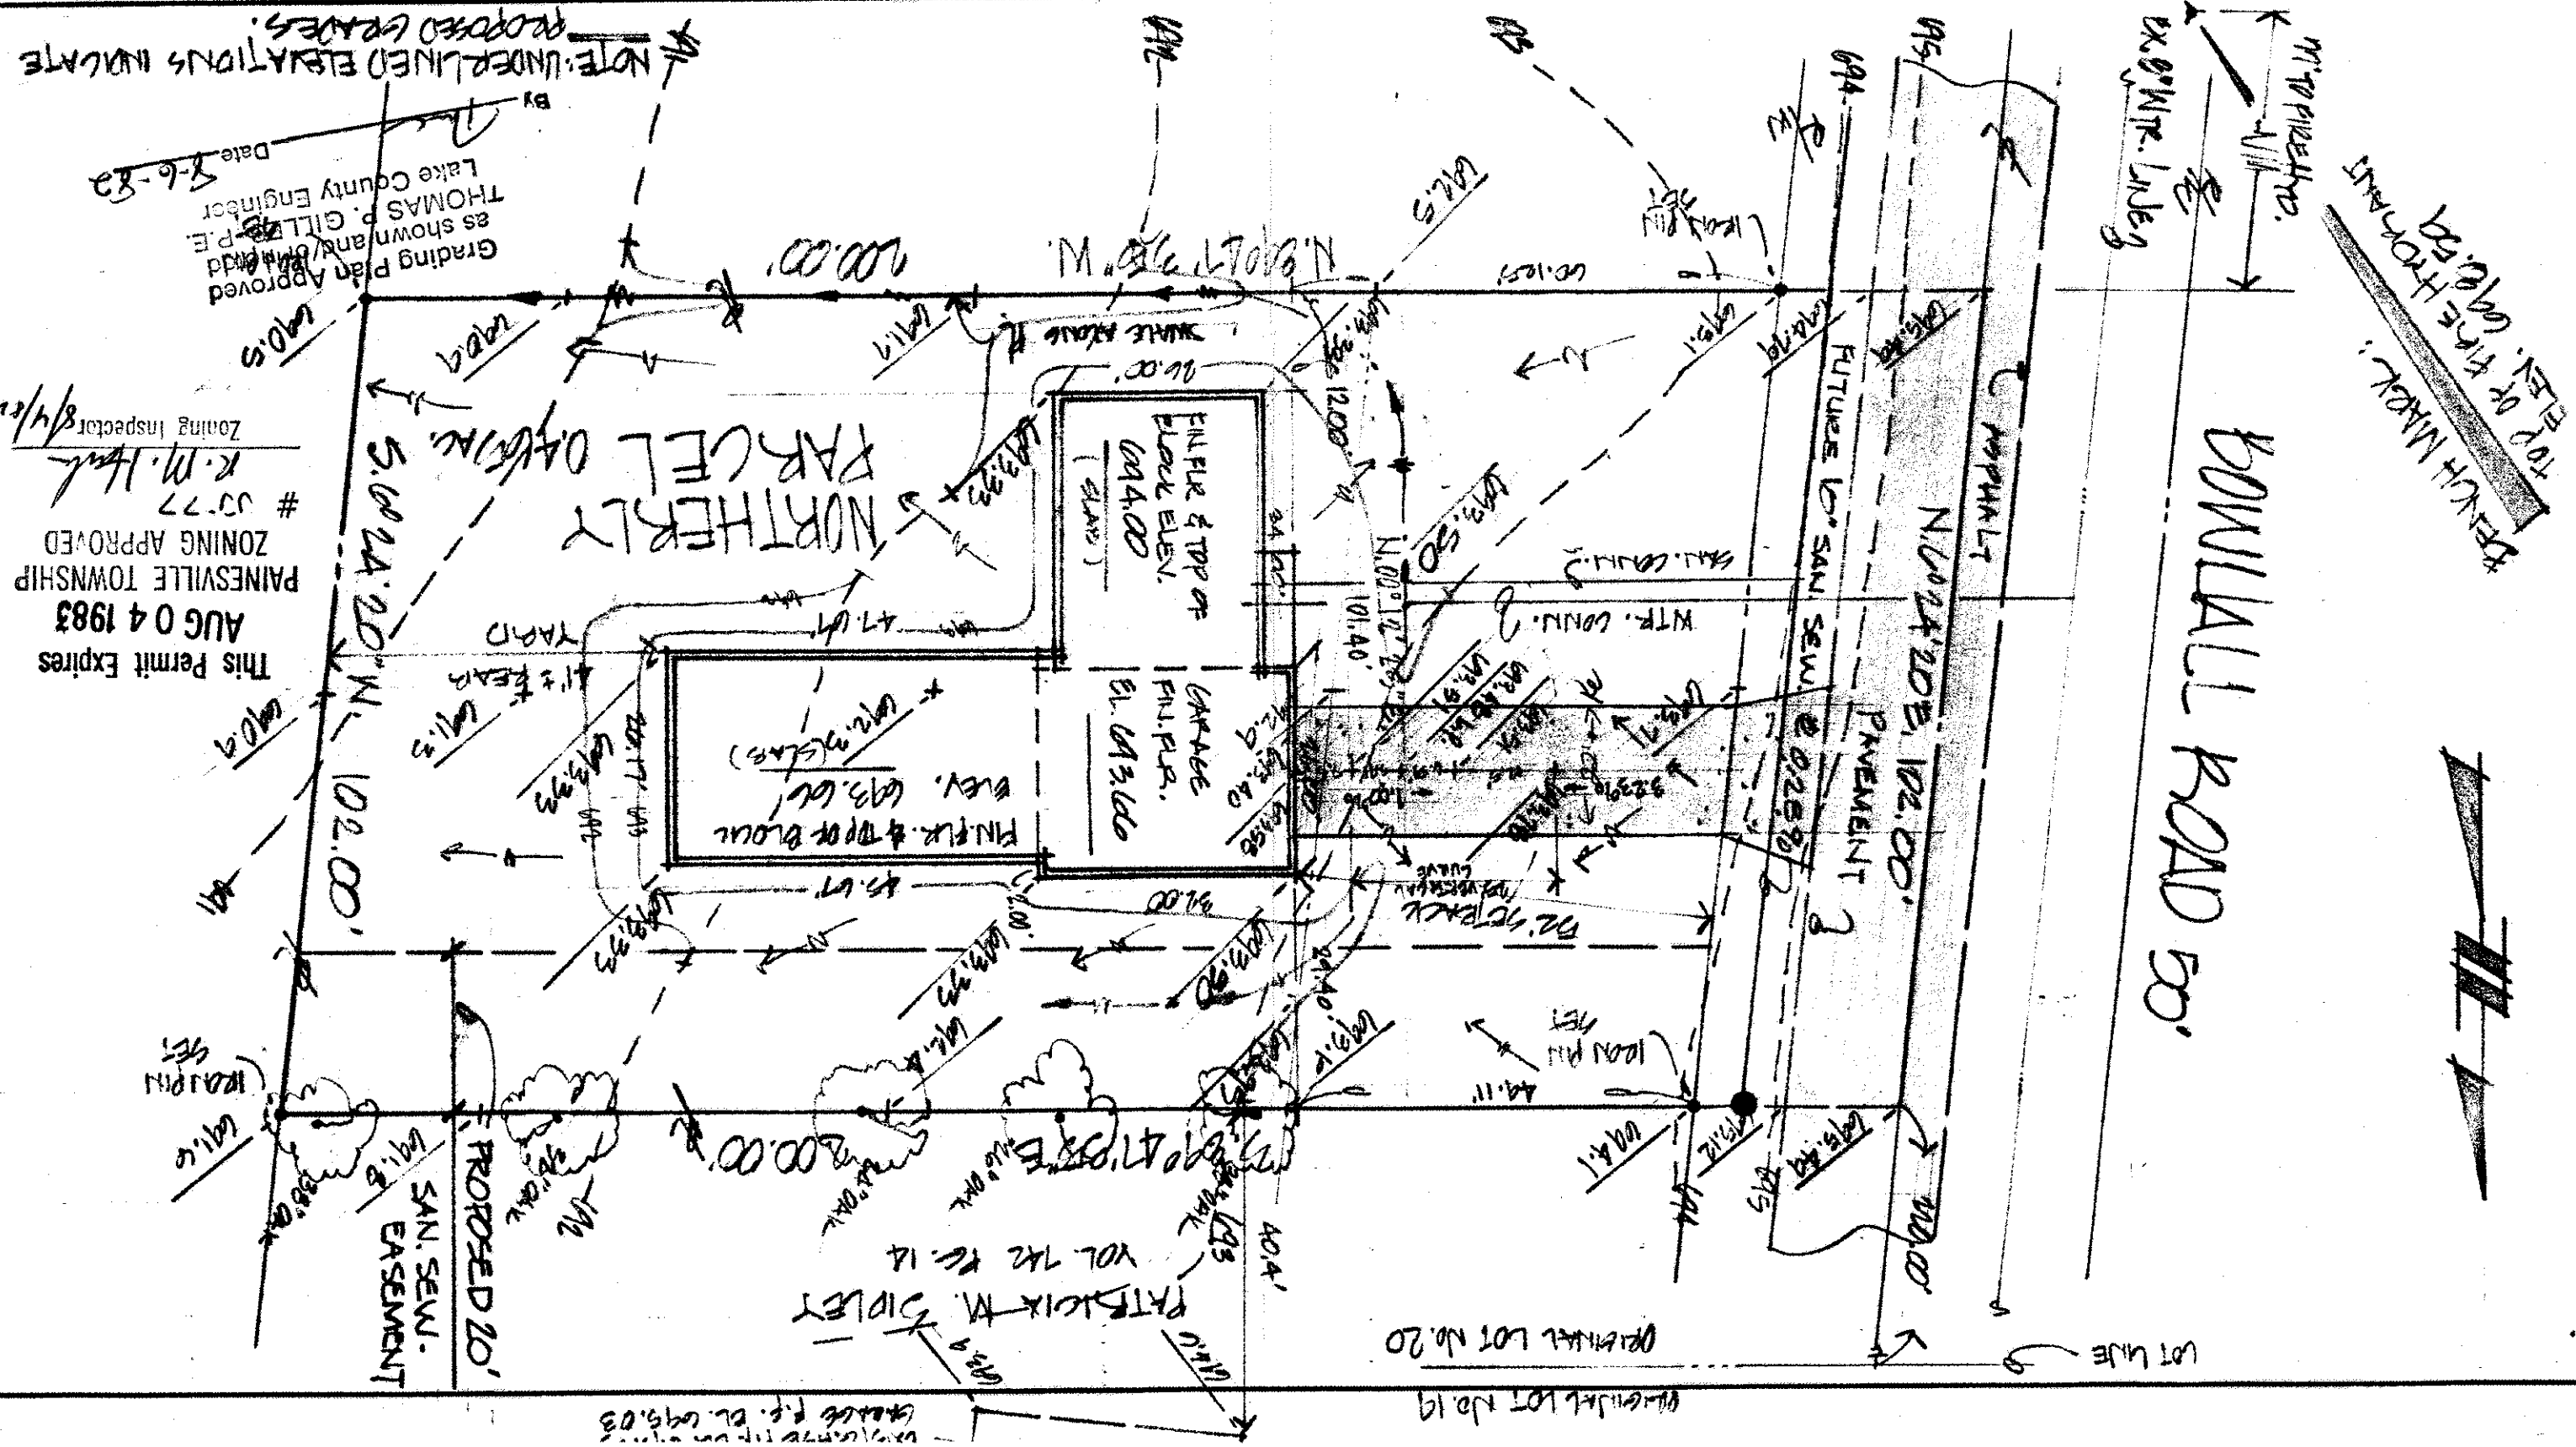

This Permit Expires
AUG 04 1983
PAINESVILLE TOWNSHIP
ZONING APPROVED
03-77
K.M.H.
Zoning Inspector
8/4/82

Grading Plan Approved
as shown and/or modified
THOMAS P. GILL
Lake County Engineer
Date 8-6-82