

SITE PLAN


PALESVILLE TOWNSHIP, LAKE COUNTY, OHIO
for: JOHN LAMPERT 357-7030
CLIENT OWNER

ADDRESS STREET CITY ZIP

SUBDIVISION NAME LOT 784 TRACT 1256
VOL. - PG. 320-34 PAGE 10
SUBLOT NO. STREET PERM. PARCEL NO. 60441100 STREET

LEGEND	
SANITARY MANHOLE	WATER VALVE (GAS)
STORM MANHOLE	WATER METER (GAS)
INLET OR CATCH BASIN	AS BUILT ELEVATION
HYDRANT	INDICATES DIRECTION OF SURFACE DRAINAGE
EXISTING CONTOURS	
PROPOSED CONTOURS	
EXIST. ELEV.	100.0
PROP. ELEV.	100.0

REMARKS
ALL BOUNDARY DATA SHOWN WAS OBTAINED FROM (DEEDS, RECORDS)
SUBDIVISION PLAT OR OTHER PUBLIC RECORDS
LOCATIONS AS SHOWN OF ADJACENT WELLS AND SEPTIC TANKS OBTAINED FROM LAKE COUNTY HEALTH DEPARTMENT

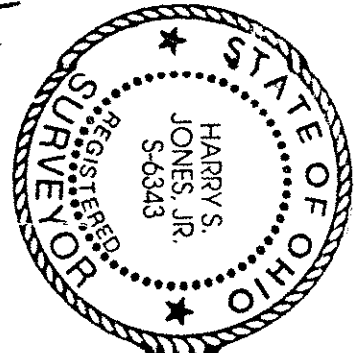

DESIGN CERTIFICATION
THIS PLAT WAS PREPARED BY ME, AND IS CORRECT TO THE BEST OF MY KNOWLEDGE AND BELIEF
NAME SURVEYOR REGISTRATION NO. 6343

CHECK LIST	
NO. OF BEDROOMS	WATER MAIN SIZE, LOCATION
SAN. SEWER SIZE, % GR. LOC.	SAN. SEWER SIZE, % GR. LOC.
TE TO NEAREST STREET	SAN. MH. CAST. ELEV. INV. ELEV.
SUBLOT NO. PARCEL NO.	SAN. CONN. SIZE, LOC. DEPTH
SUBDIVISION OWNERS	STORM SEWER SIZE, % GR. LOC.
BLDG. DIMENSIONS FTM. GR.	STORM MH. CAST. ELEV. INV. ELEV.
PAYT TYPE GRADE CURBS	PAYT TYPE GRADE CURBS
APRON TYPE WIDTH THICKNESS	GAS LINE LOC. SIZE PRESSURE
SEPTIC TANK LOCATION & DUPLICATION AREA	SEPTIC TANK LOCATION & DUPLICATION AREA
WELL LOCATION	WELL LOCATION
ISOLATION RADIUS FROM WELL	ISOLATION RADIUS FROM WELL
ROCK OUTCROPPINGS	

REVISIONS	
NO.	DATE BY
1	5/2/94 HT
2	5/5/94 HT
3	5/17/94 HT
4	5/20/94 HT
5	5/20/94 HT

PLAN PREPARED BY: BABCOCK • JONES & ASSOCIATES, INC. PAINESVILLE, OHIO	SCALE 1" = 20'	PHONE NO. 357-1811
DRAWN BY: HT	DATE: 4/29/94	DRAWING NO. 74-080
CHKD. HT	APPD. HT	
CREW CHIEF HT		

"AS BUILT" CERTIFICATION
I, HEREBY CERTIFY THAT THE CIRCLED GRADES ARE EXISTING FINISH GRADES CHECKED IN THE FIELD ON 19____ AND ARE CORRECT TO THE BEST OF MY KNOWLEDGE AND BELIEF.


REGISTERED SURVEYOR REG. NO. 6343

TRM - T.S.E.H.
ELEV. = 100.00

LOWER F6 TO 944
7 21 94

"I, the undersigned hereby certify that this topography indicated by 6", 1" or 2" contours, and elevations shown hereon represent an actual field survey made by me on the 27th day of April, 1994 and that the elevations were taken at appropriate intervals and that as of that date they existed as indicated hereon."

Signature: [Handwritten Signature]
Reg. No. 6343

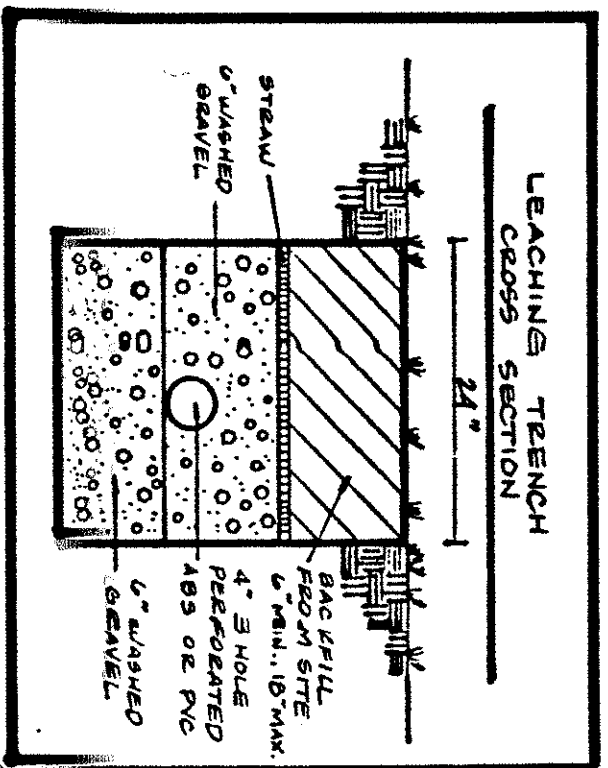

SEWAGE DISPOSAL PERMIT MUST BE OBTAINED BY A LAKE COUNTY LICENSED INSTALLER BEFORE INSTALLATION IS STARTED.

LOW YIELD WATER FIXTURES REQUIRED ON ALL:
Shower Head
Toilet

- A. To be brought to finished grade
1. Septic tank man hole covers
 2. Splitter box cover
 3. Distribution box cover
- B. No footer drains or downspouts to be discharged into septic tanks
- C. All waste water to be discharged into septic tanks

HYDRAULIC PROFILE
SCALE: HORIZ: 1" = 20'
VERT: 1" = 5'

Reviewed and Accepted
LAKE COUNTY GENERAL HEALTH DISTRICT
Date: 5-24-94
JOEL LUCIA, R.S., M.P.H.
Health Commissioner
BY: [Signature]

