


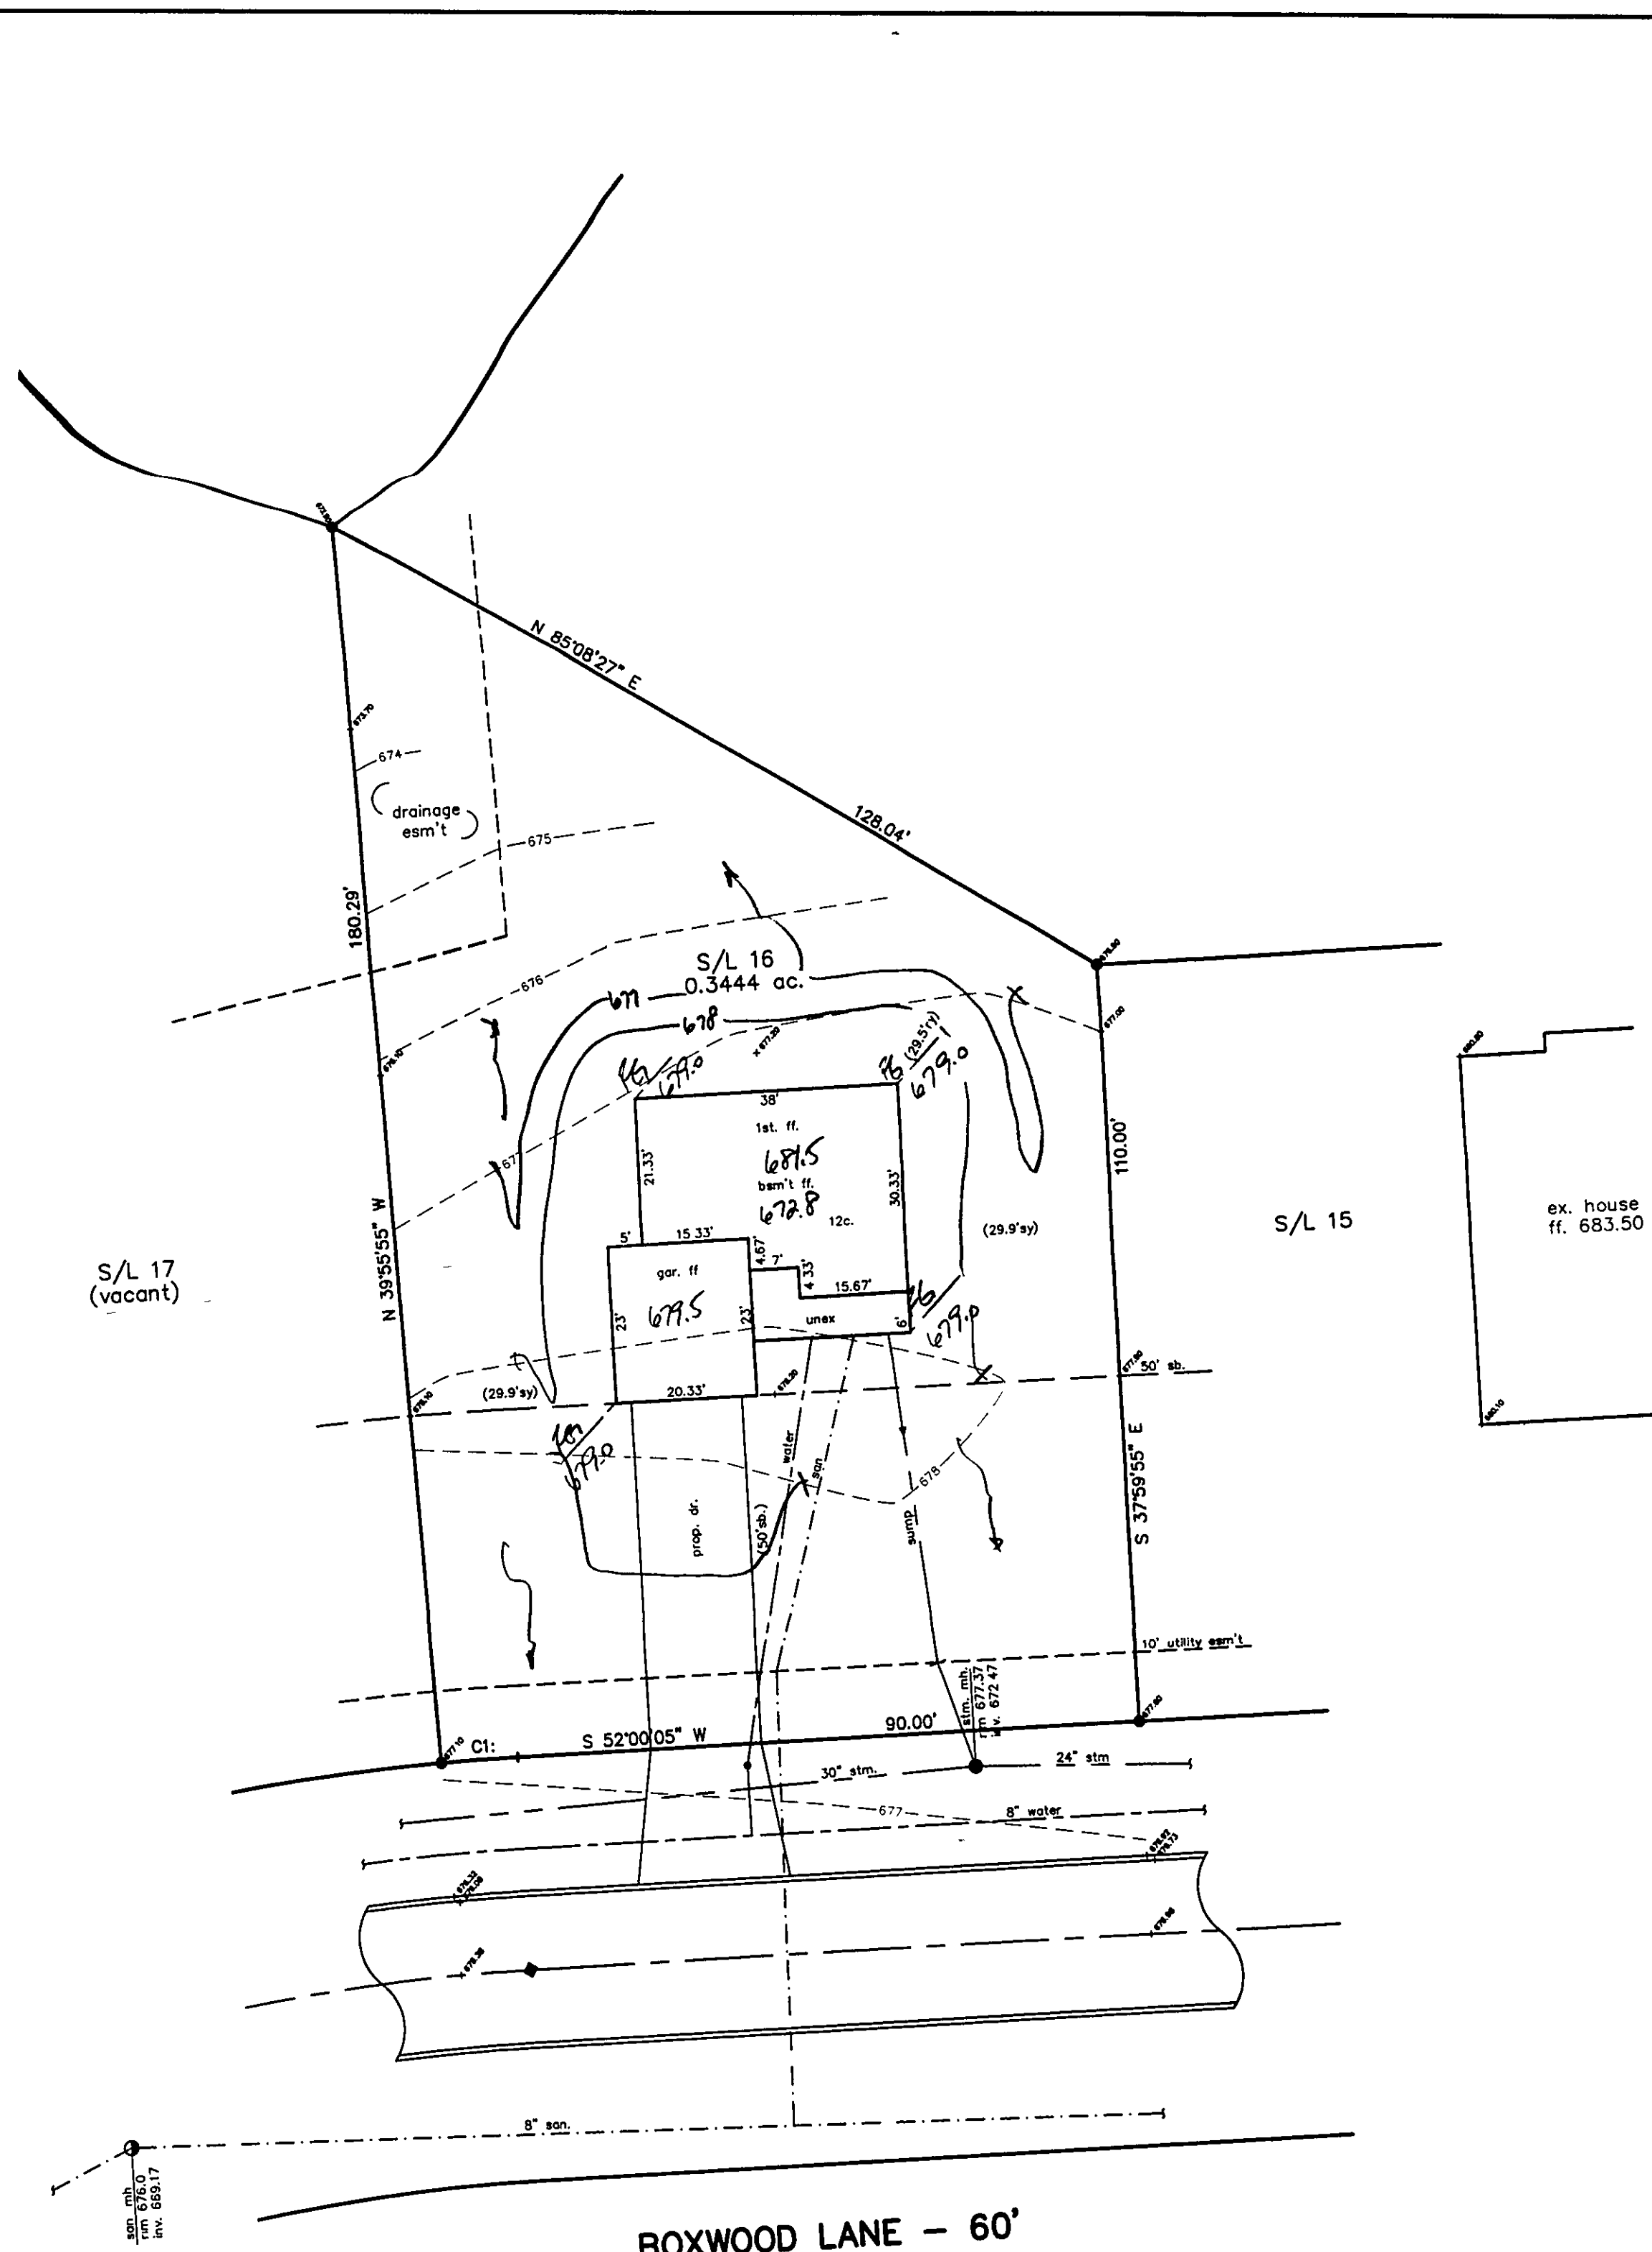

SITE PLAN
CITY OF PAINESVILLE, LAKE COUNTY, OHIO
for: **SHAMROCK CONSTRUCTION**
CLIENT: _____ OWNER: _____
ADDRESS: _____ STREET: _____ CITY: _____ ZIP: _____

BRIARWOOD SUB.
SUBDIVISION 28-22 NAME: _____ TRACT: _____ STREET: _____
VOL-PG. BOXWOOD LANE LOT: _____
16 SUBLOT NO. STREET VOL-PG. PERM. PARCEL NO.

LEGEND
EXIST. ELEV. - 100.0
100.0 ± PROP. ELEV.
AS BUILT ELEVATION
INDICATES DIRECTION OF SURFACE DRAINAGE
SANITARY MANHOLE
STORM MANHOLE
INLET OR CATCH BASIN
HYDRANT
EXISTING CONTOURS
PROPOSED CONTOURS

REMARKS
ALL BOUNDARY DATA SHOWN WAS OBTAINED FROM (DEEDS, RECORDED SUBDIVISION PLAT OR OTHER PUBLIC RECORDS)
LOCATIONS AS SHOWN OF ADJACENT WELLS AND SEPTIC TANKS OBTAINED FROM LAKE COUNTY HEALTH DEPARTMENT

DESIGN CERTIFICATION
THIS PLAT WAS PREPARED BY ME, AND IS CORRECT TO THE BEST OF MY KNOWLEDGE AND BELIEF.
NAME: *Harry E. Jones* SURVEYOR REGISTRATION NO. *16343*

CHECK LIST
NO. OF BEDROOMS
DIMENSIONS
BEARINGS
TIE TO NEAREST STREET
SUBLOT NO. PARCEL NO.
SURROUNDING OWNERS
BLDG. DIMENSIONS FIN GR.
BLDG. TIES FL'R. GRADES
APRON TYPE WIDTH THICKNESS
SIDEWALK TYPE WIDTH THICKNESS
CULVERT TYPE DIA. LENGTH
ROCK OUTCROPPINGS
WATER MAIN SIZE, LOCATION
SAN. SEWER SIZE & GR. LOC.
SAN. MH. CAST. ELEV. INV. ELEV.
SAN. CONN. SIZE, LOC. DEPTH
STORM SEWER SIZE & GR. LOC.
STORM MH. CAST. ELEV. INV. ELEV.
PAV'T TYPE GRADE CURBS
GAS LINE LOC. SIZE PRESSURE
SEPTIC TANK LOCATION & DUPLICATION AREA
WELL LOCATION
ISOLATION RADIUS FROM WELL

REVISIONS			PLAN PREPARED BY:	
NO.	DATE	BY	Bj BABCOCK JONES & ASSOCIATES, INC.	
1			PAINESVILLE, OHIO	
2			DRAWN BY T.R. SCALE 1"=20' PHONE NO. 440-357-1811	
3			CHK'D. H.J. DATE 12/22/98 DRAWING NO. 97-070-16	
4			APP'D H.J.	
5			CREW CHIEF M.M.	

"AS BUILT" CERTIFICATION
I, HEREBY CERTIFY THAT THE CIRCLED GRADES ARE EXISTING FINISH GRADES CHECKED IN THE FIELD ON 19____, AND ARE CORRECT TO THE BEST OF MY KNOWLEDGE AND BELIEF.

REGISTERED SURVEYOR
C1: R=330.00'
L=11.13'
C=11.13'
D=01°55'59"
S51°01'12"W
REG. NO. TBM-SANITARY MH. S/L 2 RIM=676.24



APPROVED
PAINESVILLE TOWNSHIP
ZONING DEPARTMENT
19980319
DR