

PAINESVILLE TWP., LAKE COUNTY, OHIO

for: JOHN CUTLIP

CLIENT	OWNER
ADDRESS	STREET
CITY	ZIP

BRANCH SURVEY	NAME	TRACT	STREET
SUBDIVISION	A-77	LOT	11B-27A-10
14 PT. VOL.-PG.	BRANCH AVE	VOL.-PG.	PERM. PARCEL NO.
SUBLOT NO.	STREET	VOL.-PG.	PERM. PARCEL NO.

LEGEND

SANITARY MANHOLE	---○---
STORM MANHOLE	---□---
INLET OR CATCH BASIN	---○---○---
HYDRANT	---○---○---
EXISTING CONTOURS	---○---
PROPOSED CONTOURS	---○---

EXIST. ELEV. 100.0
100.0 ± PROP. ELEV.
AS BUILT ELEVATION
INDICATES
DIRECTION OF
SURFACE DRAINAGE

REMARKS

ALL BOUNDARY DATA SHOWN WAS OBTAINED FROM (DEEDS, RECORDED SUBDIVISION PLAT OR OTHER PUBLIC RECORDS)

LOCATIONS AS SHOWN OF ADJACENT WELLS AND SEPTIC TANKS OBTAINED FROM LAKE COUNTY HEALTH DEPARTMENT

DESIGN CERTIFICATION

THIS PLAT WAS PREPARED BY ME, AND IS CORRECT TO THE BEST OF MY KNOWLEDGE AND BELIEF.

NAME: *Harry S. Jones, Jr.* SURVEYOR REGISTRATION NO. 05-162

CHECK LIST

NO. OF BEDROOMS	WATER MAIN SIZE, LOCATION
DIMENSIONS	SAN. SEWER SIZE & GR. LOC.
BEARINGS	SAN. MH. CAST. ELEV. INV. ELEV.
TIE TO NEAREST STREET	SAN. CONN. SIZE, LOC. DEPTH
SUBLOT NO. PARCEL NO.	STORM SEWER SIZE & GR. LOC.
SURROUNDING OWNERS	STORM MH. CAST. ELEV. INV. ELEV.
BLDG. DIMENSIONS FIN GR.	PAV'T TYPE GRADE CURBS
BLDG. TIES FL'R. GRADES	GAS LINE LOC. SIZE PRESSURE
APRON TYPE WIDTH THICKNESS	SEPTIC TANK LOCATION & DUPLICATION AREA
SIDEWALK TYPE WIDTH THICKNESS	WELL LOCATION
CULVERT TYPE DIA., LENGTH	ISOLATION RADIUS FROM WELL
ROCK OUTCROPPINGS	

REVISIONS

NO.	DATE	BY
1	8/8/05	H.J.
2	8/12/05	H.J.
3	8/18/05	B.P.
4	8/24/05	H.J.
5	1/5/06	H.J.

PLAN PREPARED BY: BABCOCK JONES & ASSOCIATES, INC. PAINESVILLE, OHIO

DRAWN BY	B.P.	SCALE	1"=20'	PHONE NO.	440-397-1811
CHK'D.	H.J.	DATE	8/2/05	DRAWING NO.	05-162
CREW CHIEF	W.B.	APP'D	H.J.		

"AS BUILT" CERTIFICATION




I, HEREBY CERTIFY THAT THE CIRCLED GRADES ARE EXISTING FINISH GRADES CHECKED IN THE FIELD ON 1/6/06, 2006 AND ARE CORRECT TO THE BEST OF MY KNOWLEDGE AND BELIEF.

REGISTERED SURVEYOR REG. NO.

TBM - 1" IRON PIPE FND
ELEV - 686.18

1.8
RIM 684.52
INV. 680.62

EXISTING UTILITIES NOTE:
THE SIZE AND LOCATION, BOTH HORIZONTAL AND VERTICAL OF THE UNDERGROUND UTILITIES SHOWN HEREON, HAVE BEEN OBTAINED BY A SEARCH OF AVAILABLE RECORDS. VERIFICATION BY FIELD OBSERVATION HAS BEEN CONDUCTED WHERE PRACTICAL, HOWEVER, BABCOCK, JONES AND ASSOCIATES INC. DOES NOT GUARANTEE THE COMPLETENESS NOR ACCURACY THEREOF.

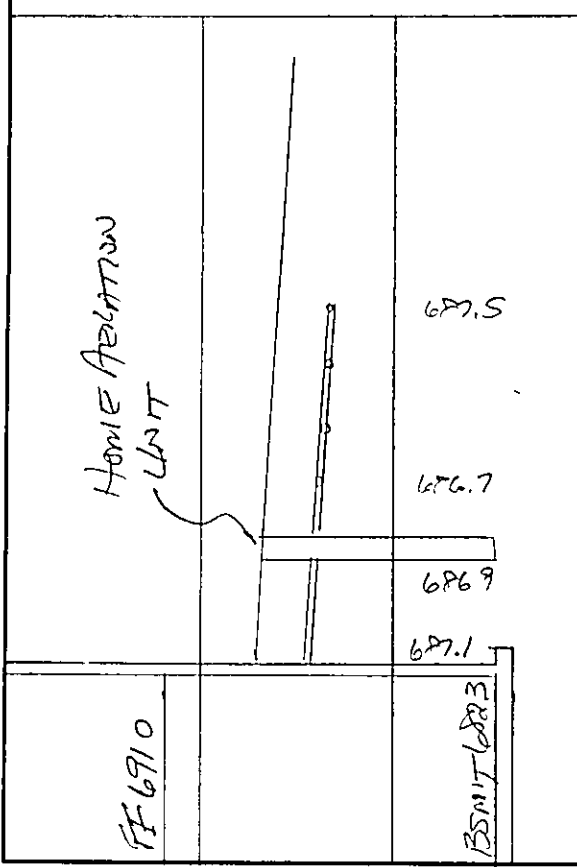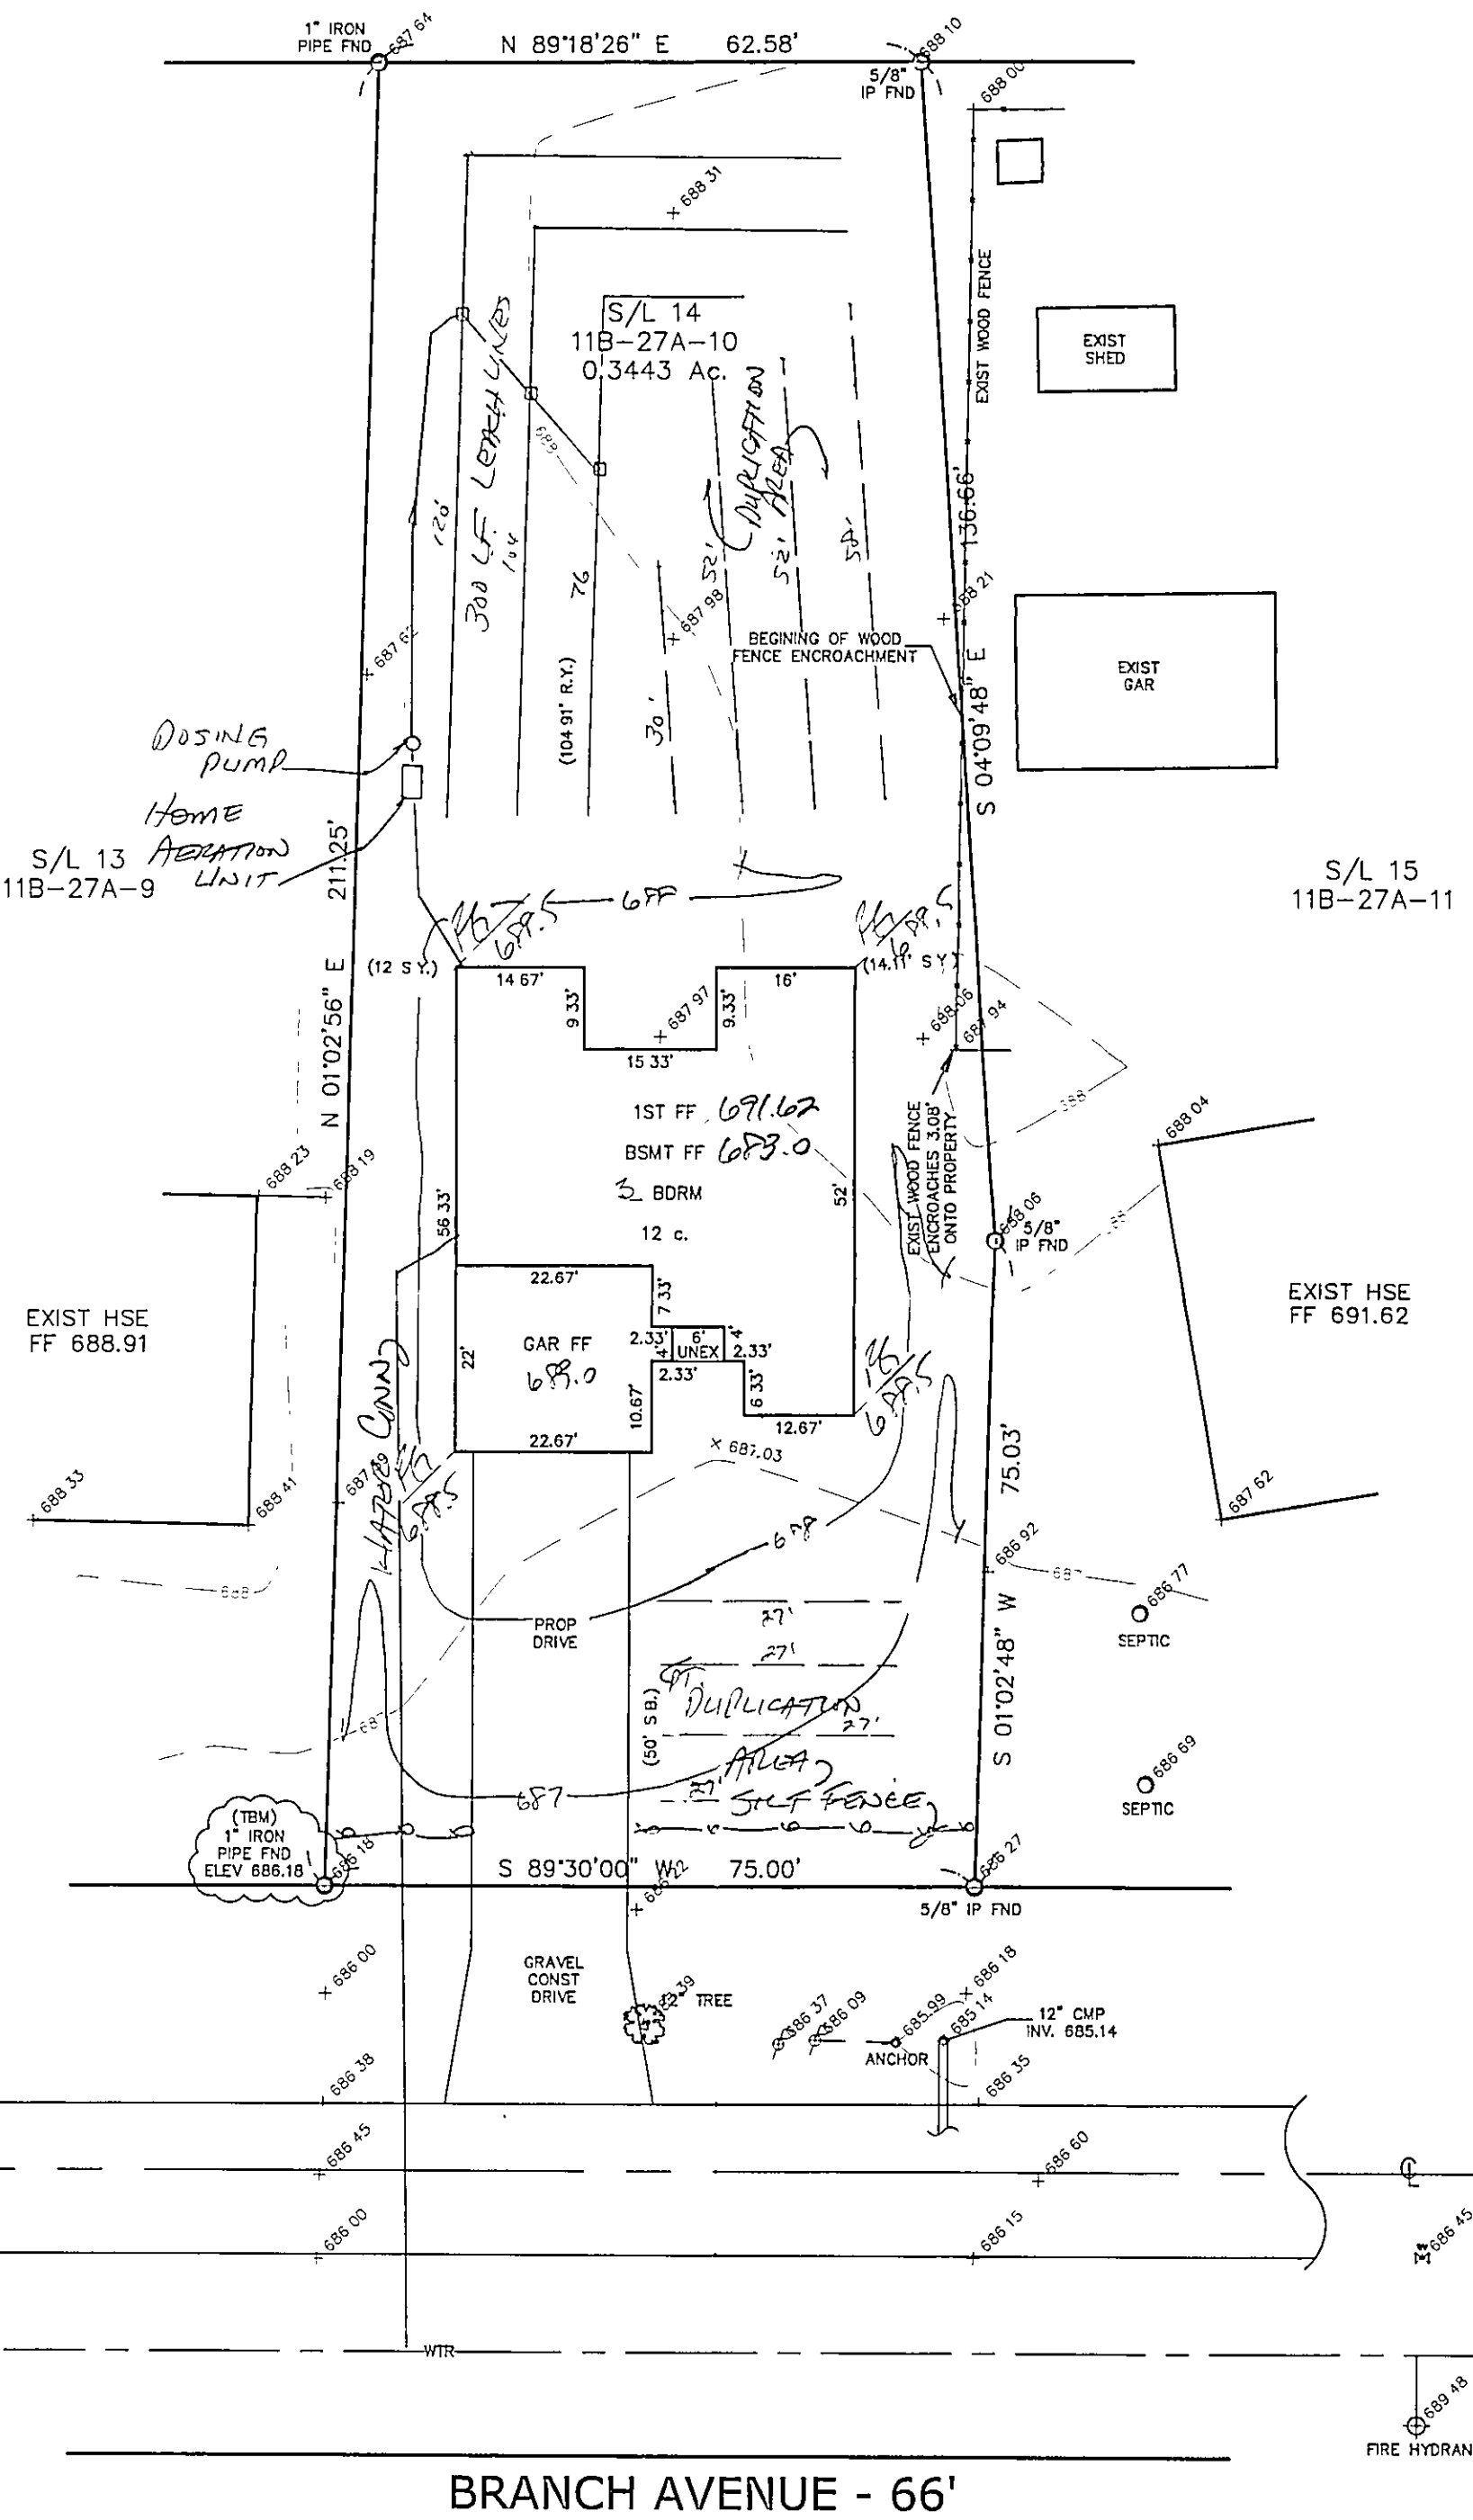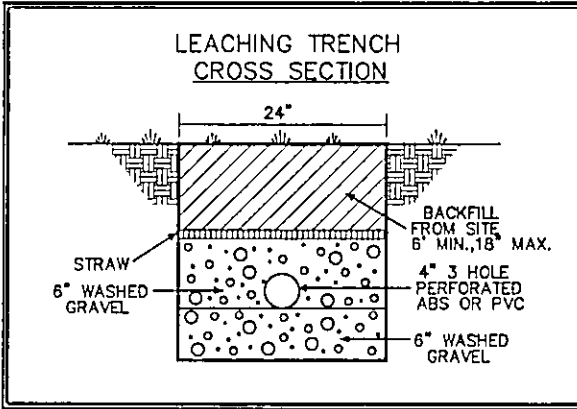

140' x 44' x 11' x 5'

BRANCH AVENUE - 66'