


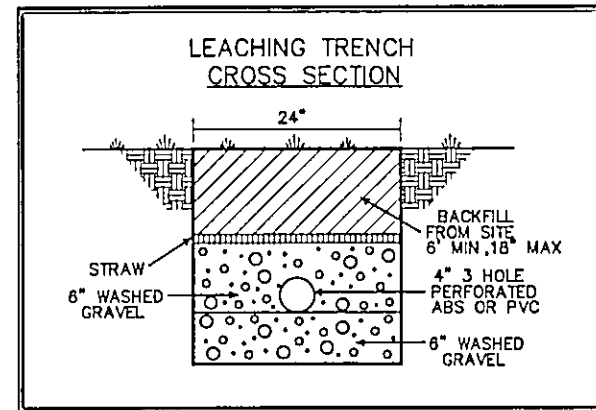


REVIEWED AND ACCEPTED
LAKE COUNTY GENERAL
HEALTH DISTRICT

Date 8/25/05 BY *[Signature]*

SEWAGE DISPOSAL PERMIT MUST BE
OBTAINED BY LAKE COUNTY HEALTH
DISTRICT BEFORE INSTALLATION IN
ST. 4.01.0

EXIST HSE
FF 688.91

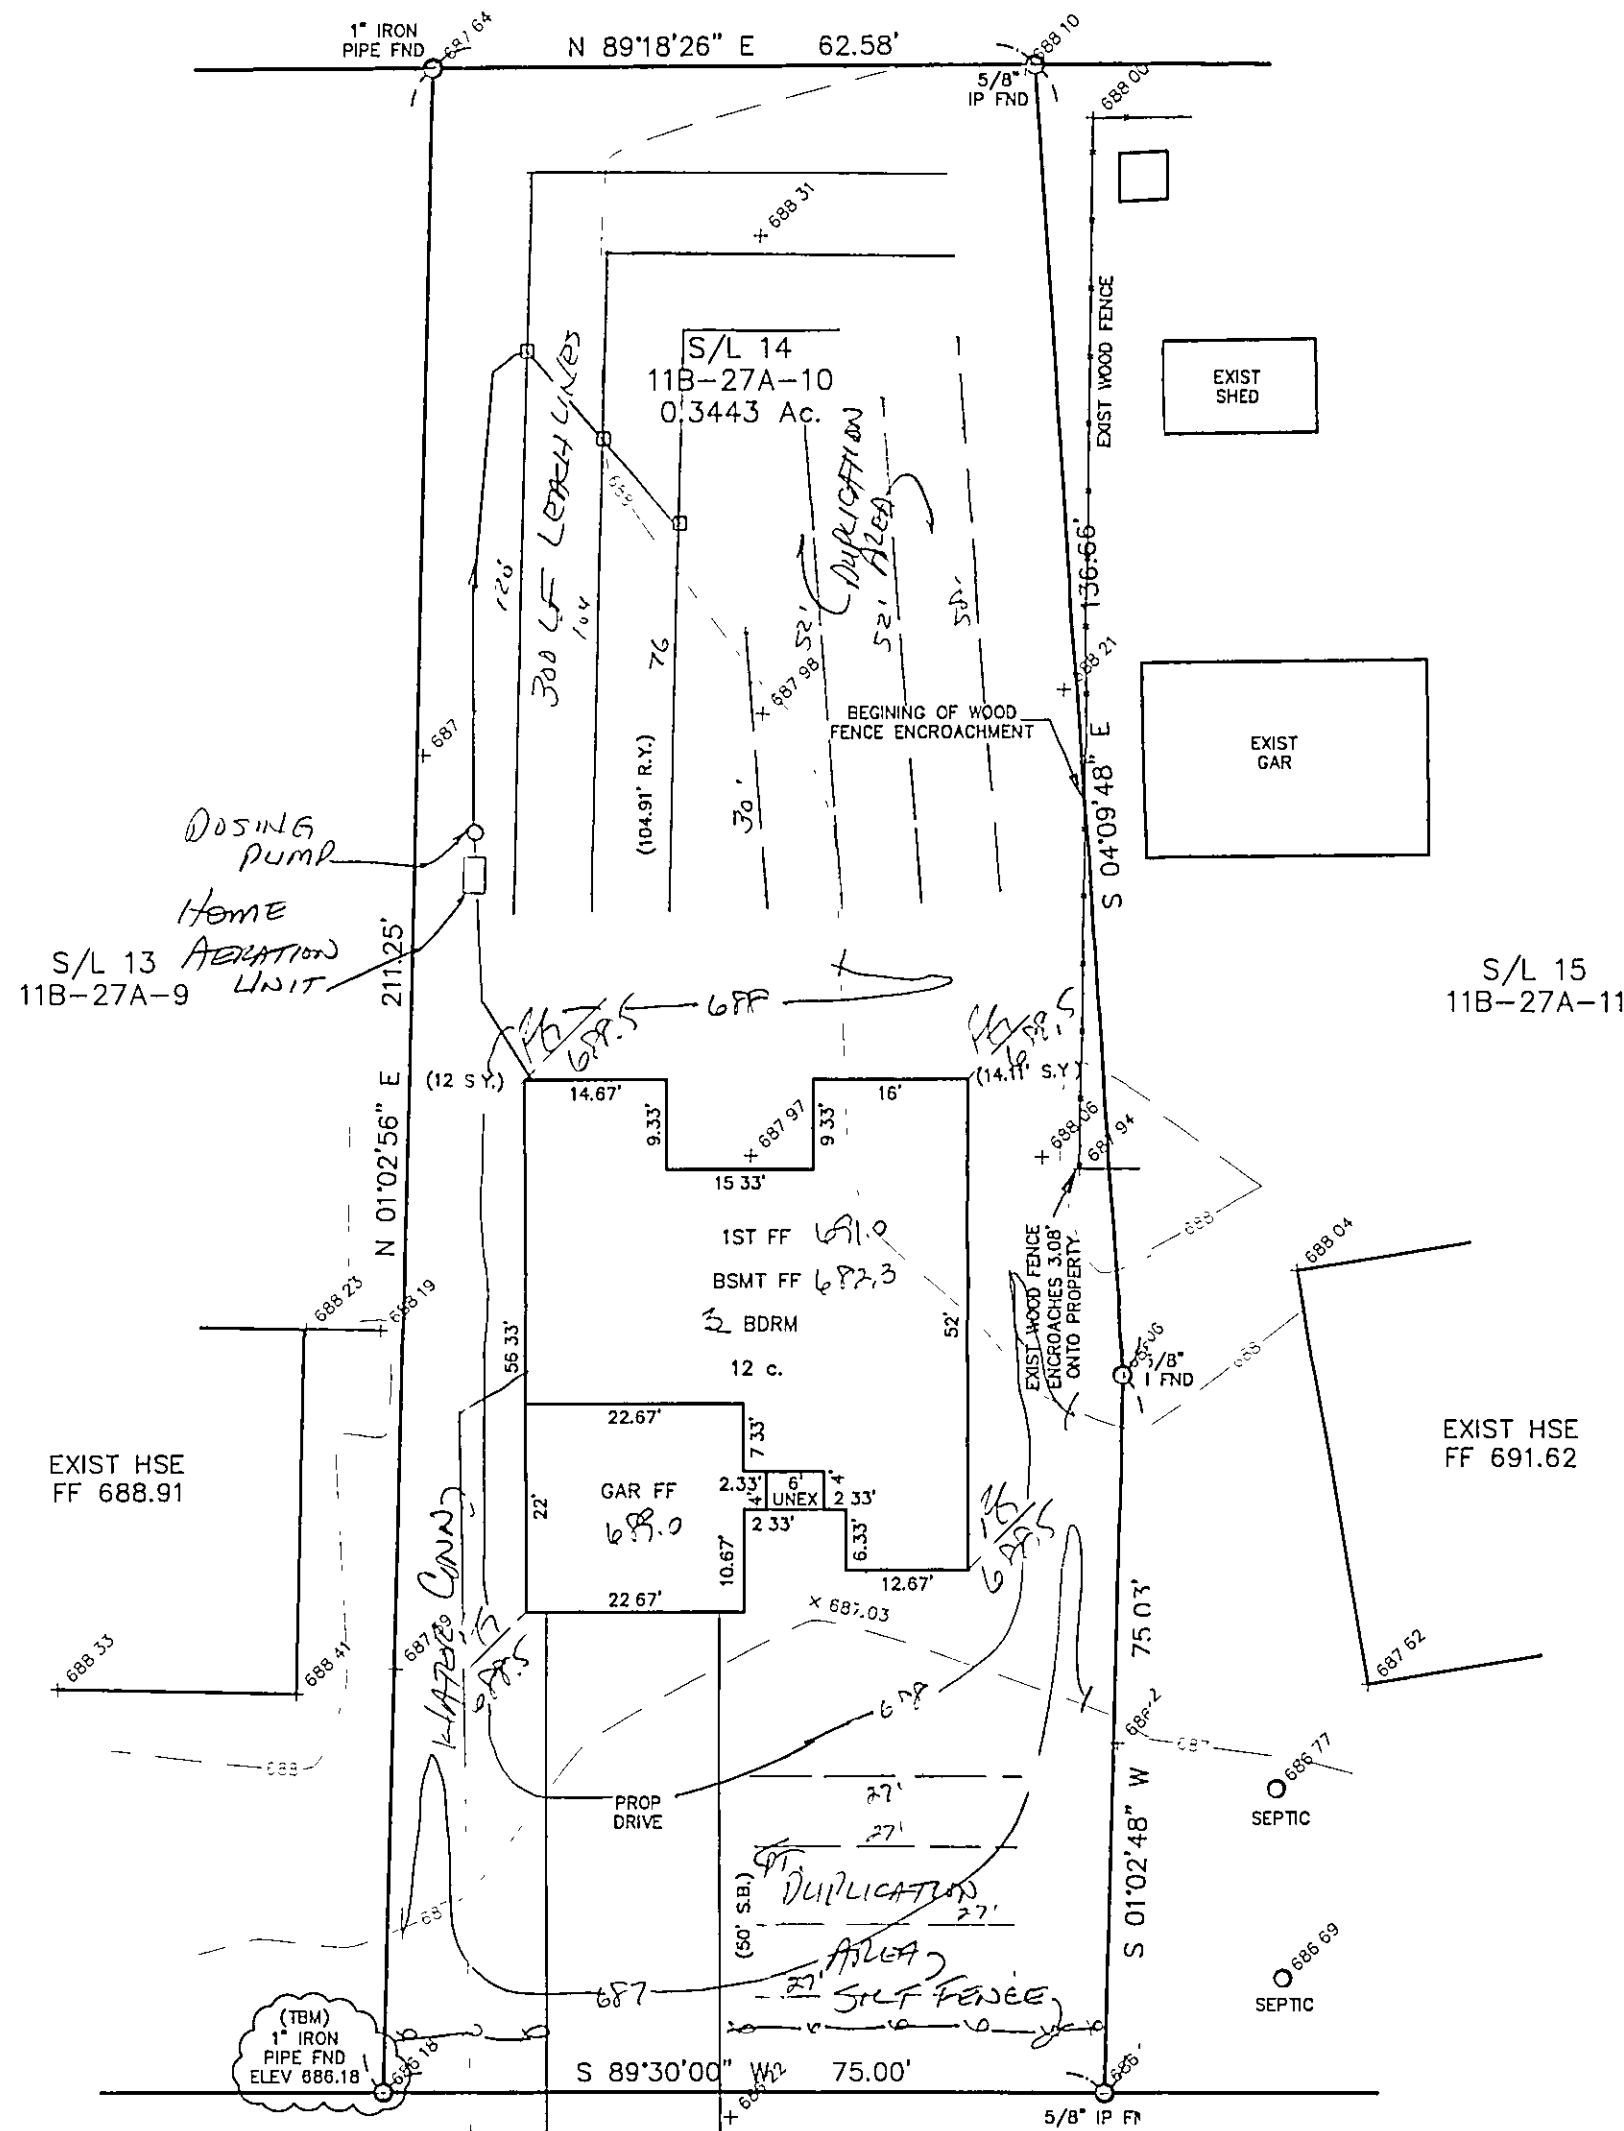

HAND-DRAWN PROFILE
NOT TO SCALE

BRANCH AVENUE - 66'

Sanitary Management Plan
Approved as shown and/or noted
JAMES R. GILLIS, P.E.
County Drainage Engineer
Date 9/1/05

1/2

SITE PLAN

PAINESVILLE TWP., LAKE COUNTY, OHIO

for: JOHN CUTLIP

CLIENT	OWNER		
ADDRESS	STREET	CITY	ZIP
BRANCH SURVEY		TRACT	
SUBDIVISION	A-77	NAME	STREET
VOL-PG.	14 PT.	LOT	11B-27A-10
SUBLOT NO.	BRANCH AVE	VOL-PG.	PERM. PARCEL NO.

LEGEND

SANITARY MANHOLE	---○---	EXIST. ELEV. 100.0	PROP. ELEV. 100.0
STORM MANHOLE	---□---	AS BUILT ELEVATION	
INLET OR CATCH BASIN	---○---	INDICATES	
HYDRANT	---○---	DIRECTION OF	
EXISTING CONTOURS	---○---	SURFACE DRAINAGE	
PROPOSED CONTOURS	---○---		

REMARKS

ALL BOUNDARY DATA SHOWN WAS OBTAINED FROM (DEEDS, RECORDED
SUBDIVISION PLAT OR OTHER PUBLIC RECORDS)

LOCATIONS AS SHOWN OF ADJACENT WELLS AND SEPTIC TANKS OBTAINED FROM
LAKE COUNTY HEALTH DEPARTMENT

DESIGN CERTIFICATION

THIS PLAT WAS PREPARED BY ME, AND IS CORRECT
TO THE BEST OF MY KNOWLEDGE AND BELIEF.

NAME *[Signature]* SURVEYOR REGISTRATION NO. #6343

CHECK LIST

NO. OF BEDROOMS	WATER MAIN SIZE, LOCATION
DIMENSIONS	SAN. SEWER SIZE & GR. LOC.
BEARINGS	SAN. MH. CAST. ELEV. INV. ELEV.
TIE TO NEAREST STREET	SAN. CONN. SIZE, LOC. DEPTH
SUBLOT NO. PARCEL NO.	STORM SEWER SIZE & GR. LOC.
SURROUNDING OWNERS	STORM MH. CAST. ELEV. INV. ELEV.
BLDG. DIMENSIONS FIN GR.	FAV'T TYPE GRADE CURBS
BLDG. TIES FL'R. GRADES	GAS LINE LOC. SIZE PRESSURE
APRON TYPE WIDTH THICKNESS	SEPTIC TANK LOCATION & DUPLICATION AREA
SIDEWALK TYPE WIDTH THICKNESS	WELL LOCATION
CULVERT TYPE DIA., LENGTH	ISOLATION RADIUS FROM WELL
ROCK OUTCROPPINGS	

REVISIONS

NO.	DATE	BY
1	8/8/05	H.J.
2	8/12/05	H.J.
3	8/18/05	B.P.
4	8/24/05	H.J.
5		

PLAN PREPARED BY:
BABCOCK · JONES & ASSOCIATES, INC.
PAINESVILLE, OHIO

DRAWN BY	B.P.	SCALE	1"=20'	PHONE NO.	440-357-1811
CHK'D.	H.J.	DATE	8/2/05	DRAWING NO.	05-162
CREW CHIEF	W.B.	APP'D	H.J.		

"AS BUILT" CERTIFICATION

I, HEREBY CERTIFY THAT THE CIRCLED GRADES ARE EXISTING
FINISH GRADES CHECKED IN THE FIELD ON 8/2/05,
AND ARE CORRECT TO THE BEST OF MY KNOWLEDGE AND BELIEF.

REGISTERED SURVEYOR REG. NO.

TBM - 1" IRON PIPE FND
ELEV - 686.18

APPROVED
Painesville Township
Zoning Department
2005294
8/24/05

IB.
RIM 684.52
INV. 680.62

EXISTING UTILITIES NOTE:
THE SIZE AND LOCATION, BOTH HORIZONTAL AND VERTICAL
OF THE UNDERGROUND UTILITIES SHOWN HEREON, HAVE BEEN
OBTAINED BY A SEARCH OF AVAILABLE RECORDS.
VERIFICATION BY FIELD OBSERVATION HAS BEEN CONDUCTED
WHERE PRACTICAL, HOWEVER, BABCOCK, JONES AND ASSOCIATES
INC. DOES NOT GUARANTEE THE COMPLETENESS NOR ACCURACY
THEREOF.

