
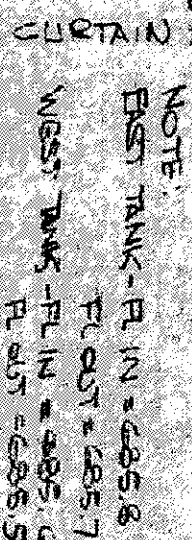


NON-STOP

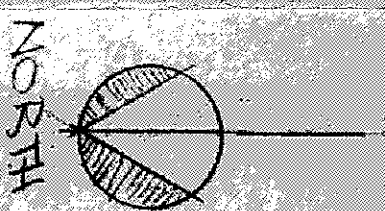

Profile
SCALE: H = 20' HORIZ
V = 21' VERT

EXISTING CONTROLS
PROPOSED CONTROLS

THIS PLAT WAS PREPARED BY ME AND IS CORRECT
TO THE BEST OF MY KNOWLEDGE.

BEING KNOWN AS SUBLOT 7 IN THE REYNOLDS
SURVEY AS RECORDED IN VOLUME A PAGE 77,
LAKE COUNTY RECORDS OF PARTS

654 _____ Date 7/5/89

Deputy Assistant Inspector



WILSON, BOYD O. ROSS, JR. THE MAXELL

DRAWING NUMBER
88-134-