


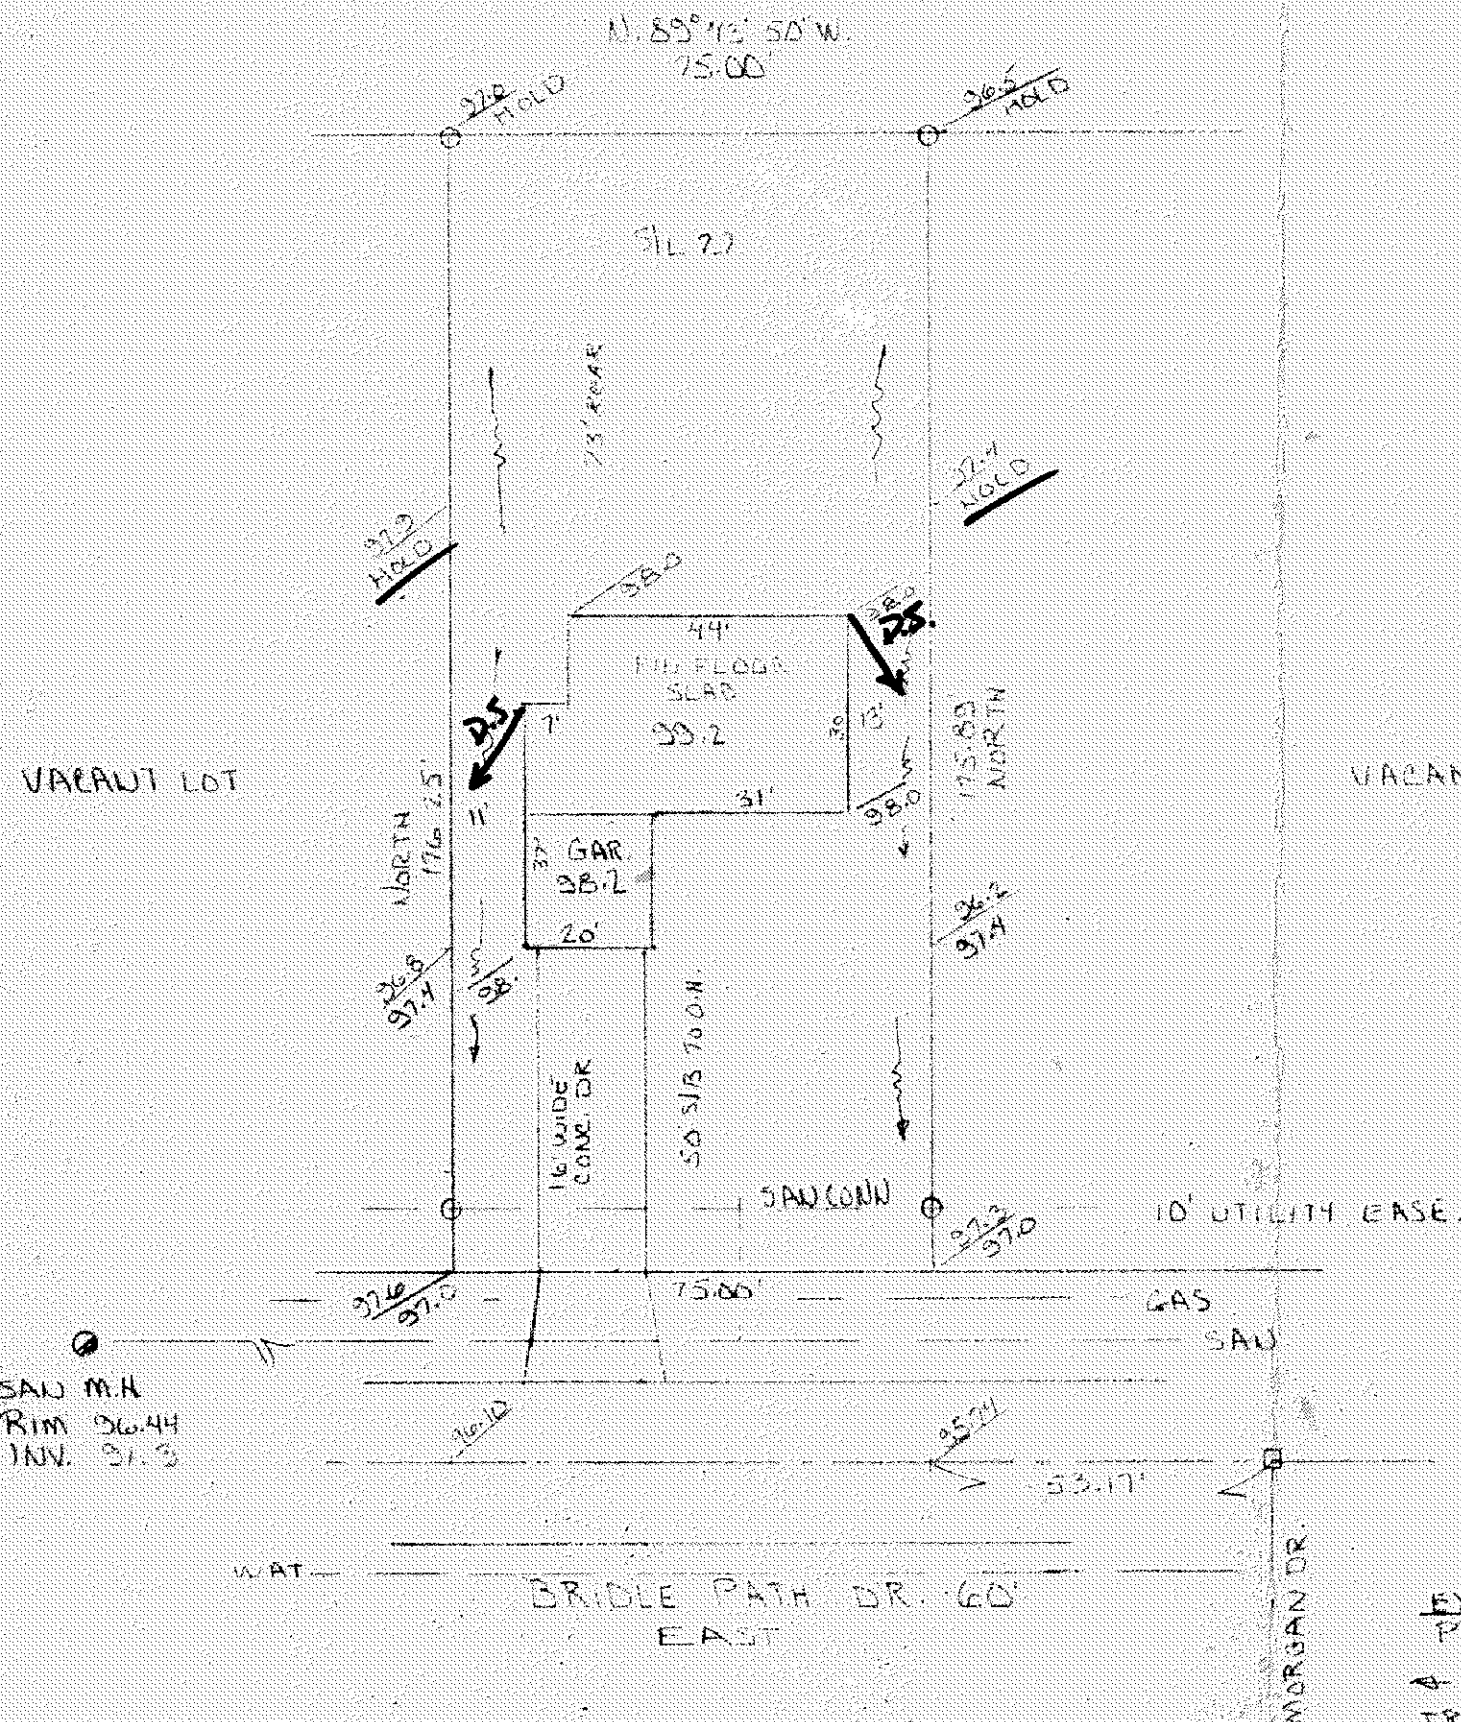

Grading as shown
 THOMAS P. C.
 Lake County Engineer
 Date 6-14-82

I CERTIFY THAT THIS PLAN WAS
 PREPARED BY ME AND IS
 CORRECT TO THE BEST OF MY
 KNOWLEDGE AND BELIEF.

John C. Skanieczny
 REG SURVEYOR 6756
 JOHN C. SKANIECZNY
 7739 VIEWMOUNT DR.
 PAINESVILLE OHIO 44077

This Permit Expires
 JUN 7 1993
 PAINESVILLE TOWNSHIP
 ZONING APPROVED
 # 5531
 R. M. Hark
 Zoning Inspector 6/2/82

EXISTING GRADES
 PROP
 SWALE
 IRON PINS TO BE
 SET AT ALL CORNERS

SITE PLAN for IDEAL AMERICAN HOMES		
SCALE: 1"=30'	APPROVED BY	DRAWN BY J.C.S.
DATE: MAY 82		
SIL 22 BRIDLE PATH DR. PAINESVILLE TOWNSHIP		VOL. 4 P. 4-2 LAKE COUNTY, OHIO
DRAWING NUMBER		