

SITE PLAN

PAINESVILLE TOWNSHIP, LAKE COUNTY, OHIO


for: **ROBERT ZUREK** 352-4531
 4683 BREEZEWOOD DR PAINESVILLE
 ADDRESS STREET CITY ZIP

SUBDIVISION	NAME	LOT	TRACT
VOL. - PG.		2	321
SUBLOT NO.	STREET	VOLUME	PAGE
		1344	14
		4683 BREEZEWOOD DR	PAINESVILLE

LEGEND	
SANITARY MANHOLE	WATER VALVE (GAS)
STORM MANHOLE	WATER METER (GAS)
INLET OR CATCH BASIN	AS BUILT ELEVATION
HYDRANT	INDICATES DIRECTION OF SURFACE DRAINAGE
EXISTING CONTOURS	
PROPOSED CONTOURS	
EXIST. ELEV.	100.0
PROP. ELEV.	100.0

REMARKS
 ALL BOUNDARY DATA SHOWN WAS OBTAINED FROM (DEEDS, RECORDED SUBDIVISION PLAT OR OTHER PUBLIC RECORDS)
 LOCATIONS AS SHOWN OF ADJACENT WELLS AND SEPTIC TANKS OBTAINED FROM LAKE COUNTY HEALTH DEPARTMENT

DESIGN CERTIFICATION
 THIS PLAT WAS PREPARED BY ME, AND IS CORRECT TO THE BEST OF MY KNOWLEDGE AND BELIEF.
 NAME SURVEYOR REGISTRATION NO. 24343

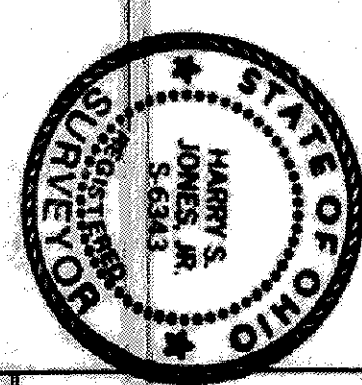


CHECK LIST	
NO. OF BEDROOMS	WATER MAIN SIZE, LOCATION
DIMENSIONS	SAN. SEWER SIZE & OR LOC.
BEARINGS	SAN. MAN. CAST ELEV. INV. ELEV.
TIE TO NEAREST STREET	SAN. CORR. SIZE, LOC. DEPTH
SUBLOT NO. PARCEL NO.	STORM SEWER SIZE & OR LOC.
SURROUNDING OWNERS	STORM MAN. CAST ELEV. INV. ELEV.
BLDG. DIMENSIONS FIN. OR	STORM TYPE GRADE CURVES
BLDG. TIE PLY. GRADES	GAS LINE LOC. SIZE PRESSURE
SEWER TYPE WIDTH THICKNESS	SEPTIC TANK LOCATION & DUPLICATION AREA
SEWER TYPE DIA. LENGTH	WELL LOCATION
ROCK OUTCROPPINGS	ISOLATION RADII FROM WELL

PLAN PREPARED BY:	
BABCOCK • JONES & ASSOCIATES, INC.	
PAINESVILLE, OHIO	
NO.	DATE
1	BY
2	
3	
4	
5	
6	

"AS BUILT" CERTIFICATION
 I, HEREBY CERTIFY THAT THE CIRCLED GRADES ARE EXISTING FINISH GRADES CHECKED IN THE FIELD ON 19____, AND ARE CORRECT TO THE BEST OF MY KNOWLEDGE AND BELIEF.

REGISTERED SURVEYOR REG. NO. 24343

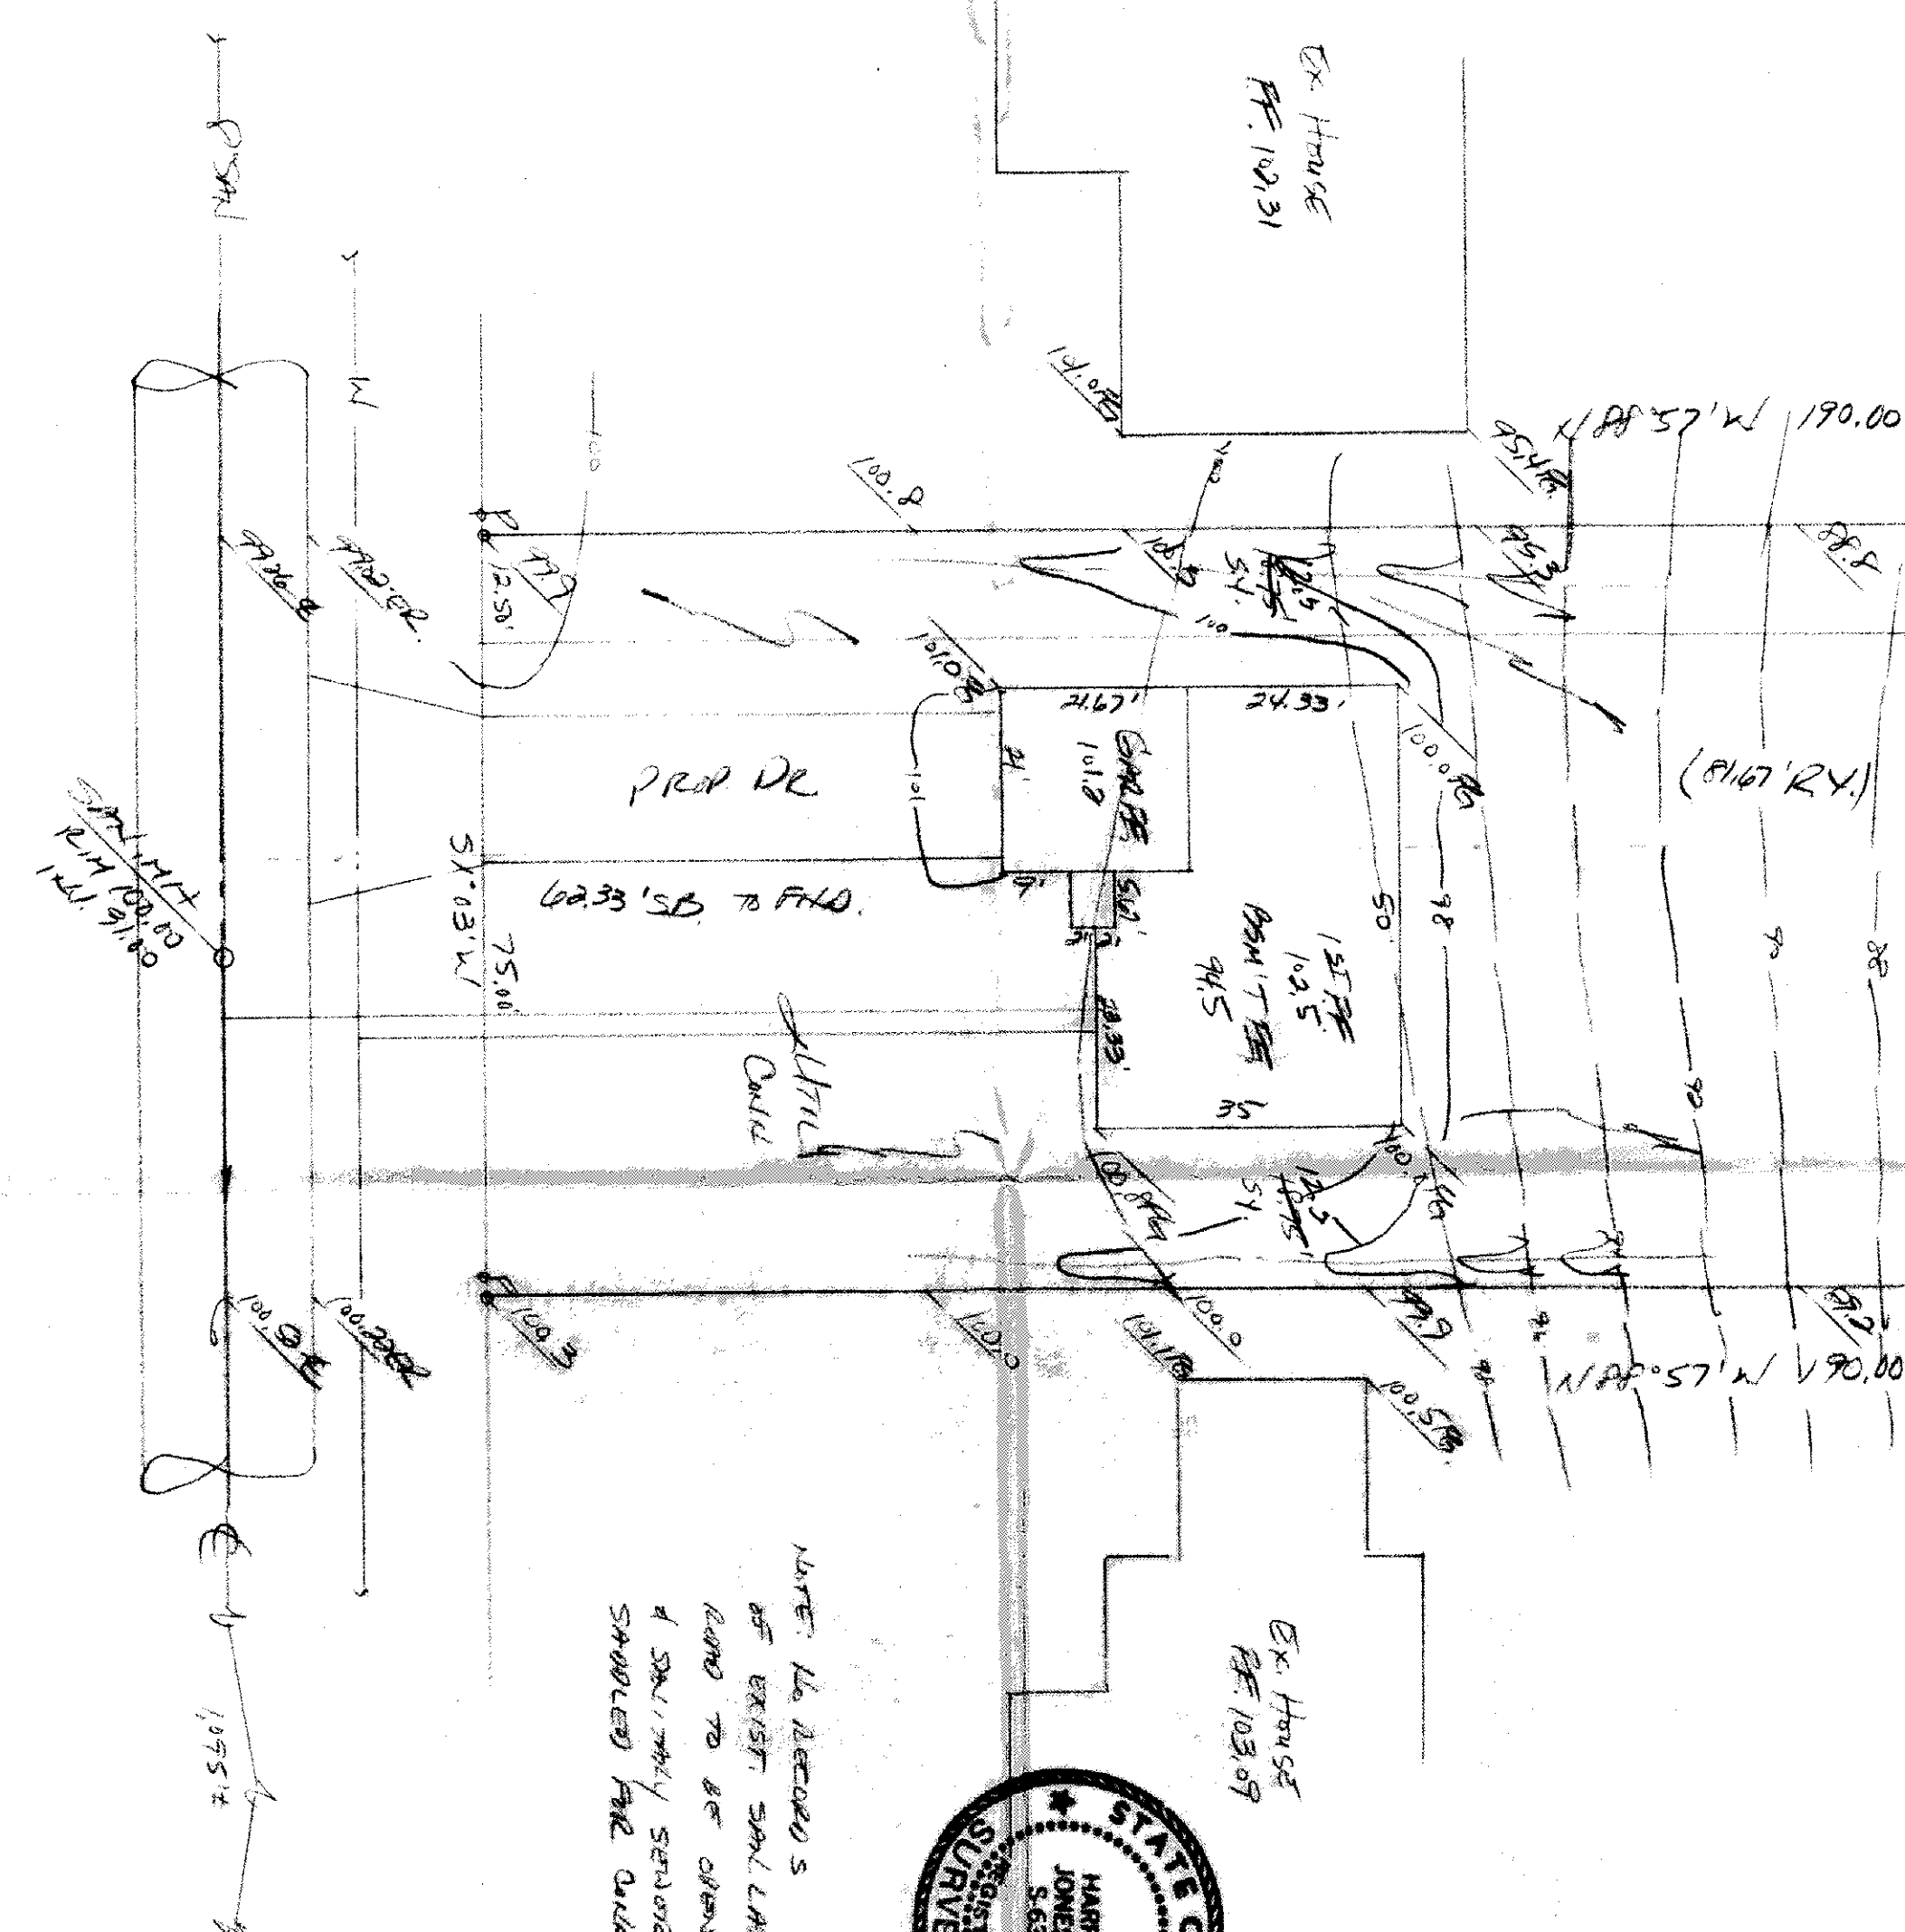

BRILL MAWRE DRIVE - 60'

Grading Plan Approved as shown and/or noted THOMAS P. GILLES, P.E. Lake County Engineer
 Date 5-18-89

This Permit Expires 5-10-90
 PAINESVILLE TOWNSHIP ZONING APPROVED
 # 7216
 Zoning Inspector 5/10/89