

SITE PLAN

PAINESVILLE TOWNSHIP LAKE COUNTY, OHIO

for:

DANIEL HUNTER

CLIENT OWNER

212 LINDEN DRIVE PAINESVILLE 44077

ADDRESS CITY ZIP

SUBDIVISION NAME STREET

SUBLOT NO. VOL. - PG. TRACT

PERMIT NO. PAGE

PERMIT NO. PAGE




PERMIT NO. PAGE

PERMIT NO. PAGE

Grading Plan Approved
as shown on plan noted
T-100-700-00, P.E.
L. J. H. L. J. H. L. J. H. L.

By: *AM* Date: *11/10*

STATE ROUTE No. 44

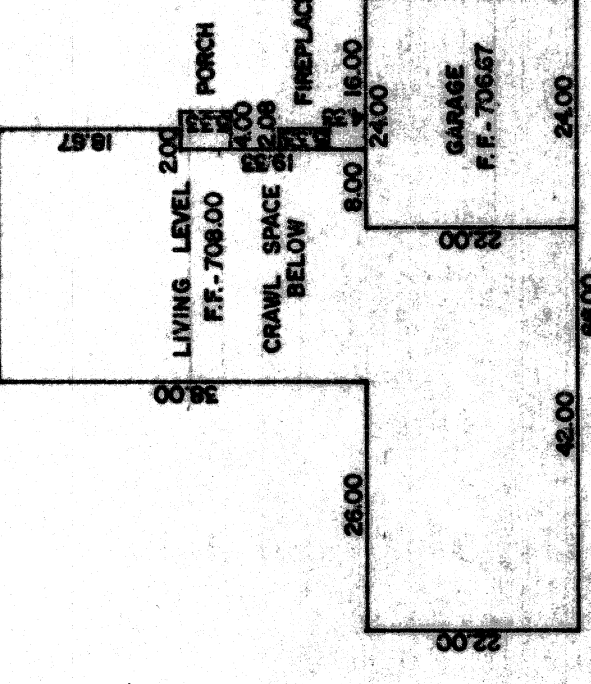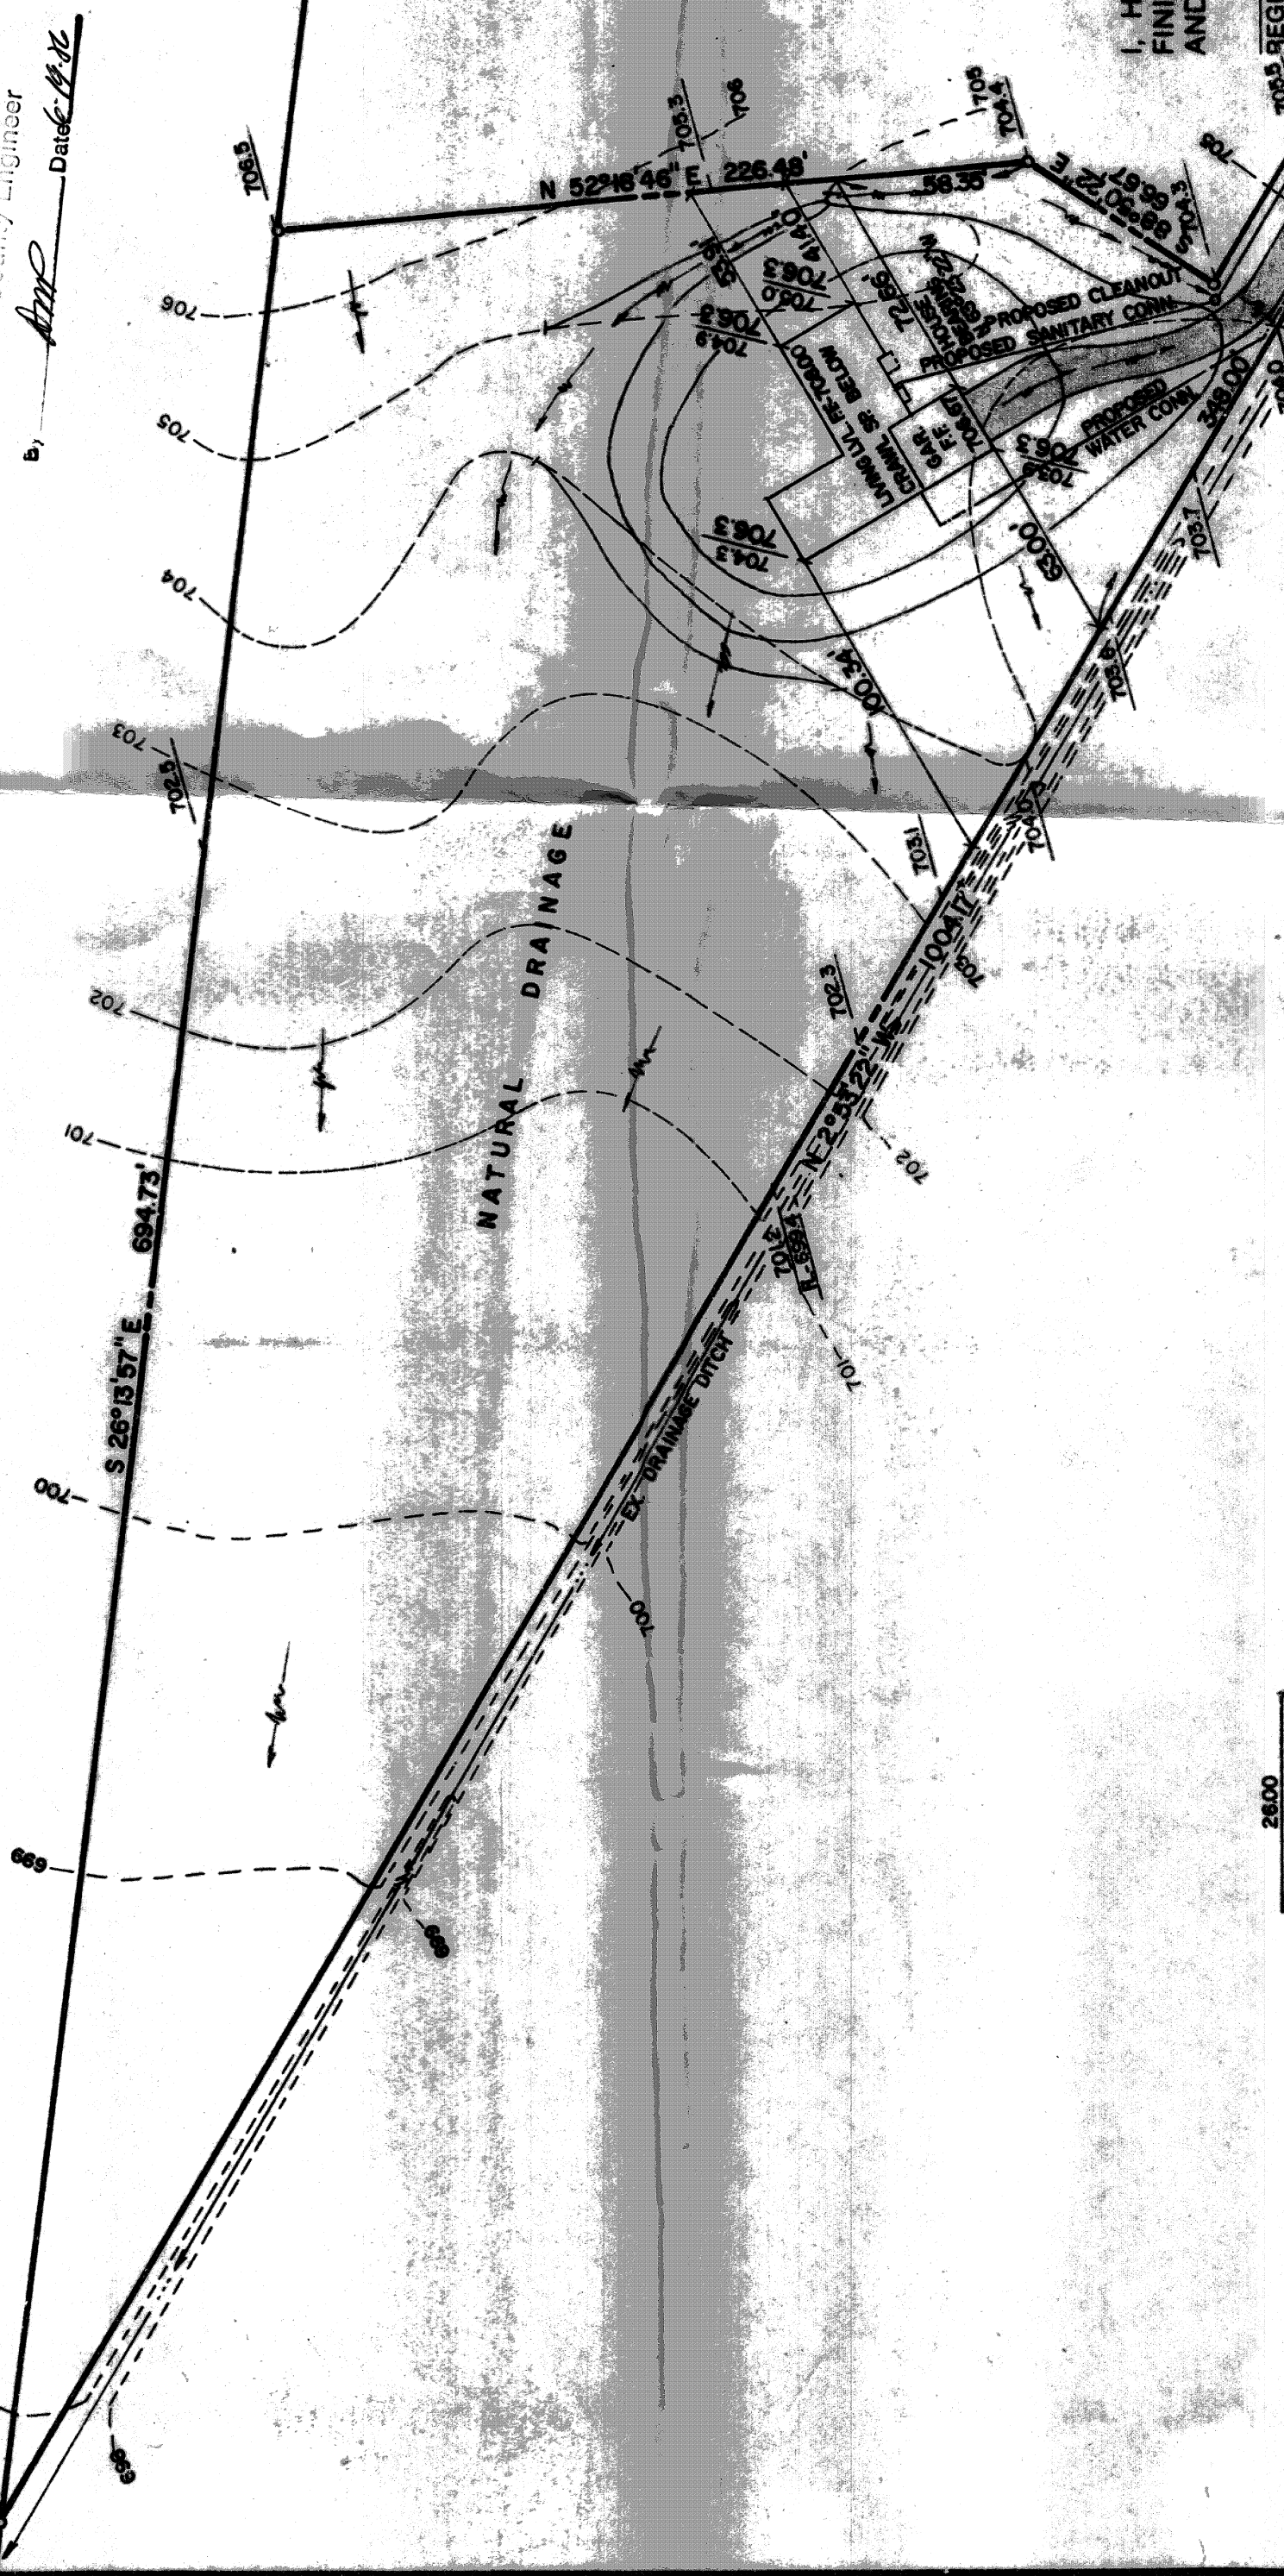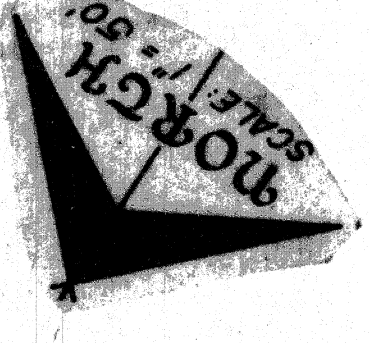

HOUSE DETAIL
SCALE - 1" = 20'

CHECK LIST

NO. OF BEDROOMS
DIMENSIONS
TIE TO NEAREST STREET
SURROUNDING OWNERS
BLDG. DIMENSIONS FIN. GR.
APPROX. TYPE WIDTH THICKNESS
SIDEWALK TYPE DIA. LENGTH
POCK OUTCROPPINGS
WATER MAIN SIZE, LOCATION
SAN. MAIN SIZE, LOC.
SAN. MH. CAST. ELEV. INV. ELEV.
STORM MAIN SIZE, LOC. ELEV.
STORM MH. CAST. ELEV. INV. ELEV.
PAV'T TYPE GRADE CURBS
GAS LINE LOC. SIZE PRESSURE
SEPTIC TANK LOCATION & DUPLICATION AREA
WELL LOCATION
ISOLATION RADIUS FROM WELL

DESIGN CERTIFICATION

THIS PLAN WAS PREPARED BY ME, AND IS CORRECT
TO THE BEST OF MY KNOWLEDGE AND BELIEF


PLAN PREPARED BY:
DEBEVEC • SALO & ASSOCIATES, INC.

125 E. ERIE ST. PAINESVILLE, OHIO

PHONE NO. 352-9250
SCALE 1" = 50'
DATE JUNE 1986
DRAWING NO. 6423.2

"AS BUILT" CERTIFICATION
I, HEREBY CERTIFY THAT THE CIRCLED GRADES ARE EXISTING
FINISH GRADES CHECKED IN THE FIELD ON 19
AND ARE CORRECT TO THE BEST OF MY KNOWLEDGE AND BELIEF.

REG. NO.

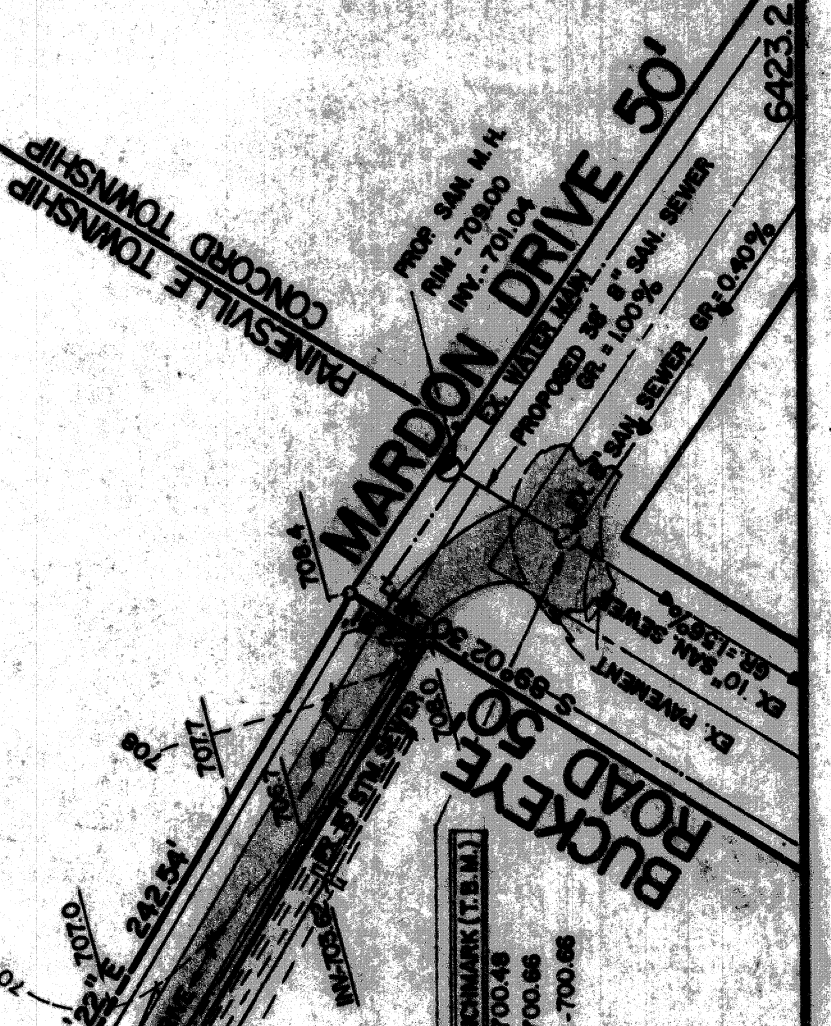

EX SAN M.H.
RIM-700.07 BENCHMARK (T.B.M.)
EX 10" INV. W. - 700.48
EX 8" INV. S. - 700.66
PROP 8" INV. E. - 700.68