

SITE PLAN

PAINESVILLE TOWNSHIP LAKE COUNTY, OHIO

FOR M.M. BOGART DEVELOPMENT CORP.

I HEREBY CERTIFY THAT THIS PLAN IS AN
ACCURATE AND TRUE REPRESENTATION OF SAID
PROPERTY.


David K. Mostoller R.S. #6949

I HEREBY CERTIFY THAT THE CIRCLED GRADES
ARE EXISTING FINISH GRADES CHECKED IN THE
FIELD ON 19, AND ARE
CORRECT TO THE BEST OF MY KNOWLEDGE AND
BELIEF.

David K. Mostoller R.S. #6949

LEGEND

- SANITARY MANHOLE
- STORM MANHOLE
- INLET OR CATCH BASIN
- HYDRANT
- - - EXISTING CONTOUR
- - - PROPOSED CONTOUR
- EXIST. ELEV. --- PROP. ELEV.
- 100.0 AS BUILT ELEVATION
- 100.0 DIRECTION OF DRAINAGE

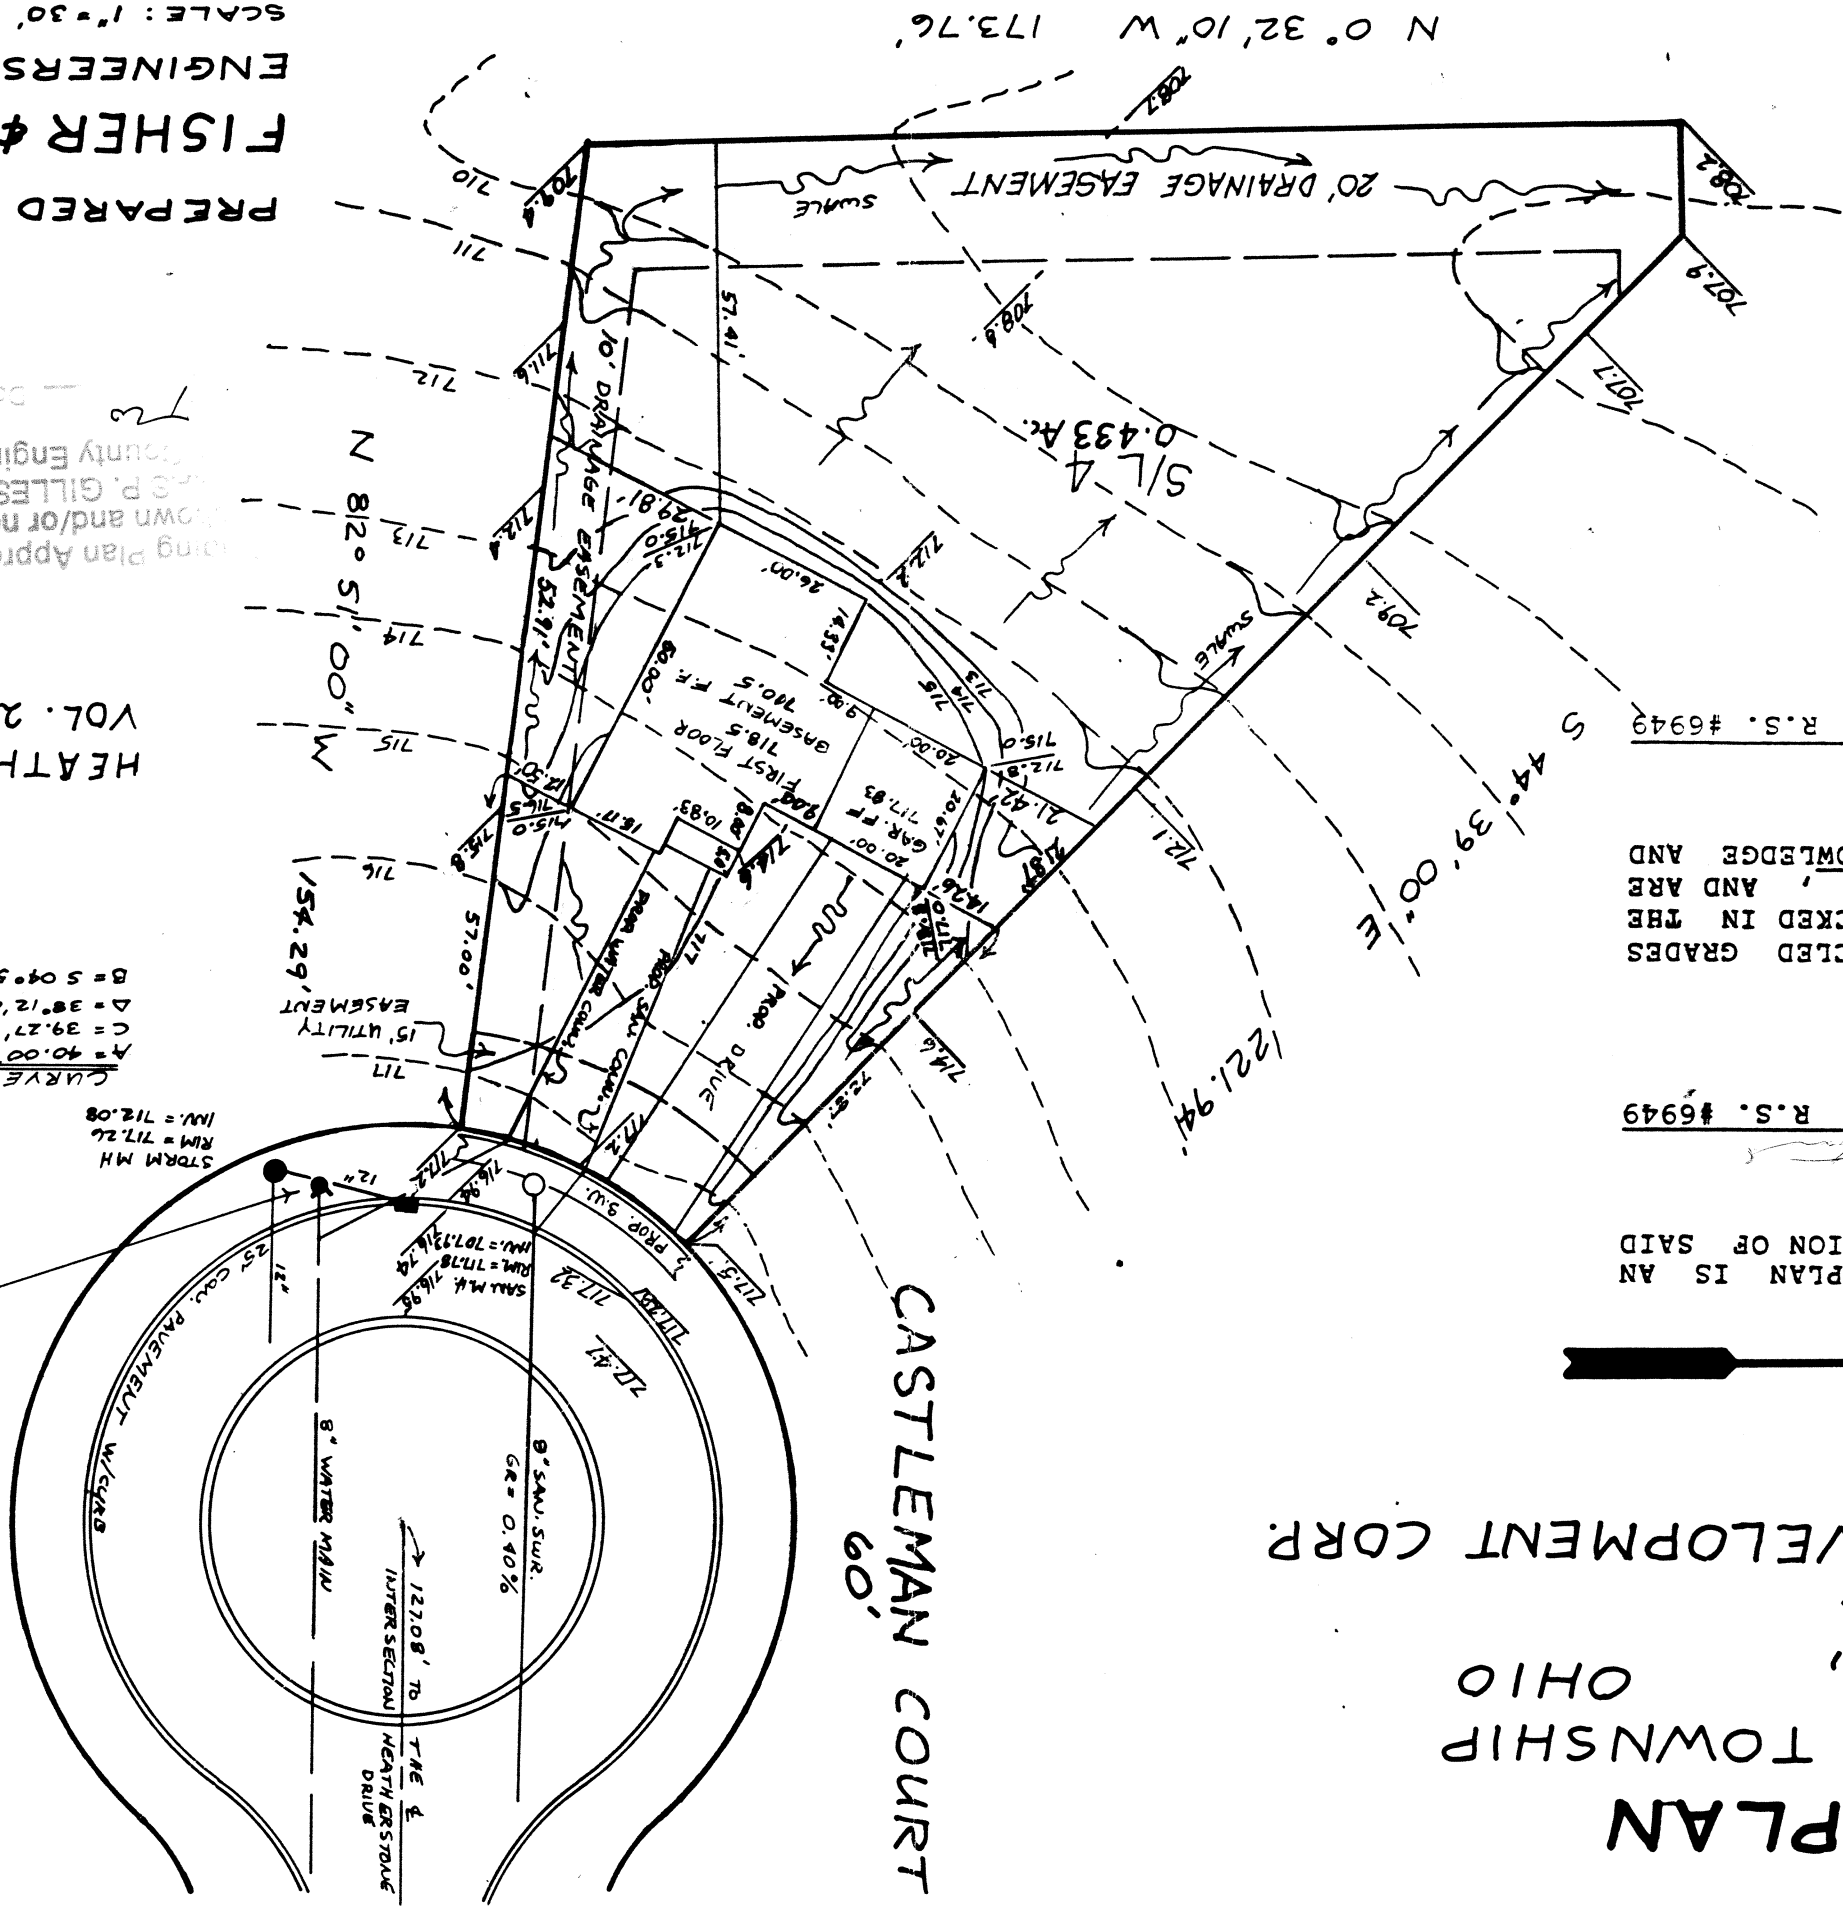

CURVE DATA
A = 40.00'
C = 39.27'
D = 38°12'00"
B = 50°58'00" W

STORM MH
RM = 717.26
INV. = 712.08

B.M. TOP OF HYD.
ELEV. = 720.50

HEATHERSTONE SUBD.
VOL. 2-35 PG. 2

This Permit Expires 3-10-88
PAINESVILLE TOWNSHIP
ZONING APPROVED
County Engineer
S.P. GILLES, P.E.
Date 3-13-87

PREPARED BY:

FISHER & ASSOCIATES INC.
ENGINEERS AND CONSULTANTS
SCALE: 1" = 30'
DATE: MARCH, 1987