

SITE PLAN

PAINESVILLE TOWNSHIP
LAKE COUNTY, OHIO

FOR
M.M. BOGART
DEVELOPMENT
CORP.

153.82'
N 0° 32' 10" W

LEGEND


- SANITARY MANHOLE
- STORM MANHOLE
- INLET OR CATCH BASIN
- HYDRANT
- EXISTING CONTOUR
- PROPOSED CONTOUR
- EXIST. ELEV. 100.0
- PROP. ELEV. 100.0
- AS BUILT ELEVATION
- DIRECTION OF DRAINAGE

I HEREBY CERTIFY THAT THE CIRCLE GRADES
ARE EXISTING FINISH GRADES CHECKED IN THE
FIELD ON 19 , AND ARE
CORRECT TO THE BEST OF MY KNOWLEDGE AND
BELIEF.

David K. Mostoller R.S. #6949

I HEREBY CERTIFY THAT THIS PLAN IS AN
ACCURATE AND TRUE REPRESENTATION OF SAID
PROPERTY.

David K. Mostoller R.S. #6949

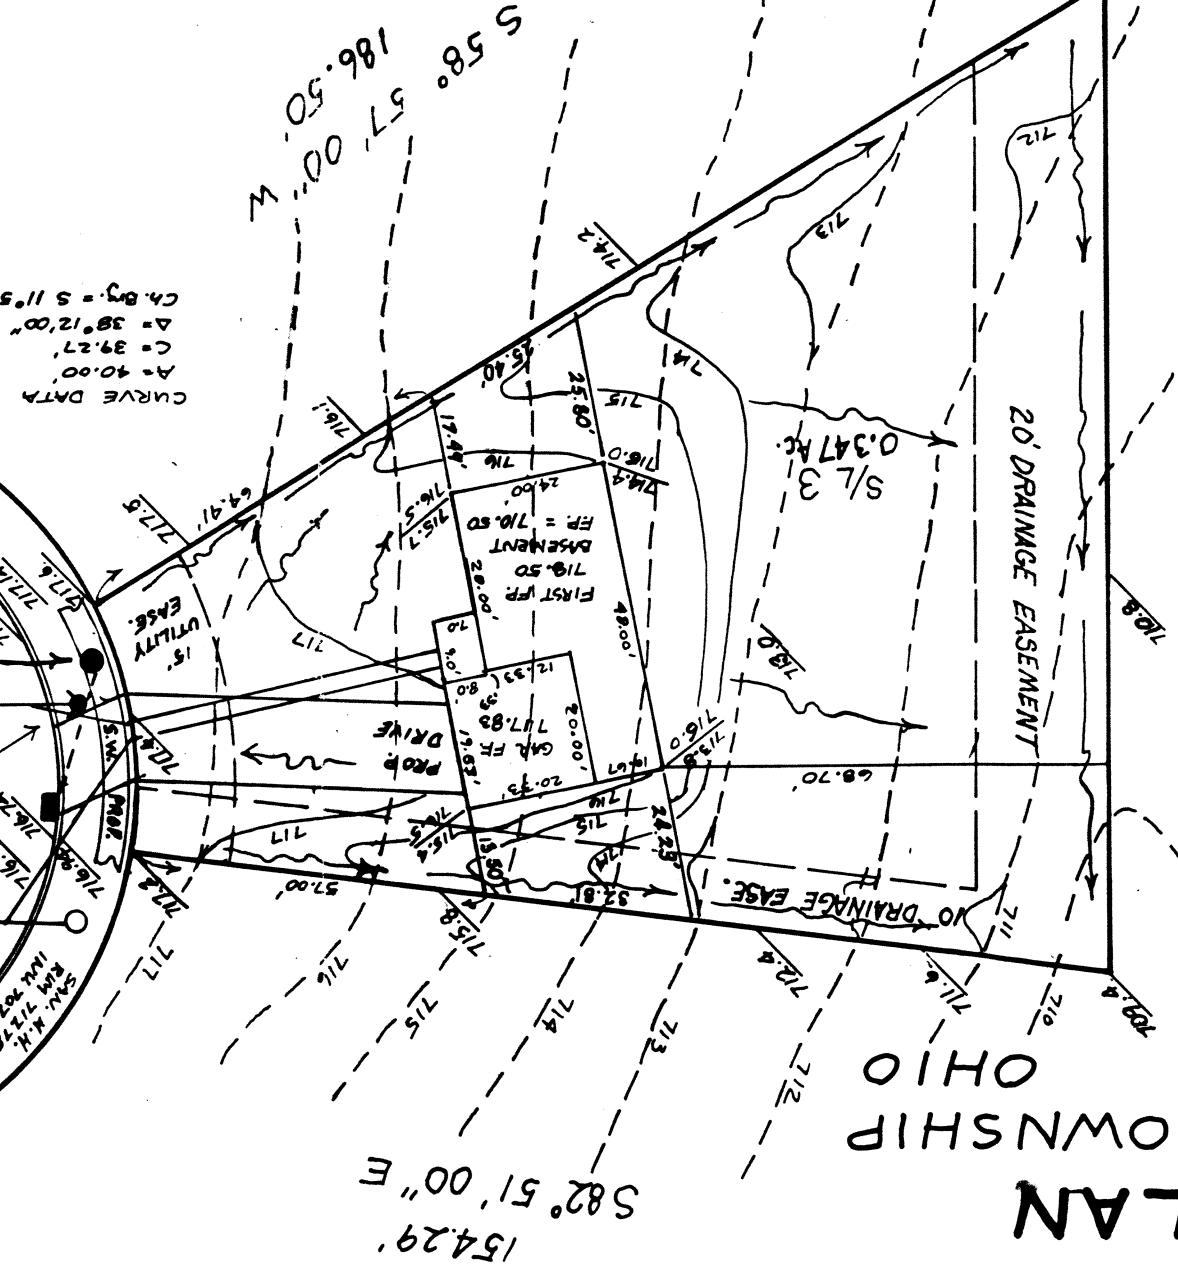

CURVE DATA
A = 40.00'
C = 39.27'
Δ = 38° 12' 00"
CH. BY = S 11° 57' 00" E

Grading Plan Approved
as shown and/or noted
THOMAS P. GILLES, P.E.
County Engineer

HEATHERSTONE SUBD.
VOL. 2-35 PG. 2
3-13-87

This Permit Expires
3-10-88
PAINESVILLE TOWNSHIP
ZONING APPROVED
6628
County Zoning Inspector

FISHER & ASSOCIATES INC.
ENGINEERS AND CONSULTANTS
SCALE: 1" = 30'
DATE: MARCH 1987

HEATHERSTONE DRIVE

CASTLEMAN CT. 60'

BM TOP OF HYD.
ELEV. = 720.50

STM MAN.
RIM 717.26

INV. 712.08

8" WATER MAIN

8" SAN. SEWER