


Cedar Creek Court - 60'

R.W. Sidley, Inc.
Vol. 590 — Pg. 796 O.R.

The topography, indicated by 1' contours, and elevations shown hereon represent an actual field survey made by Foresight Engineering Group, Inc. on October 10, 1986. The elevations were taken at appropriate intervals and as of the above date they existed as indicated hereon.

Franklin D. Swadlow P.E. 10/14/86


Foresight Engineering Group, Inc.

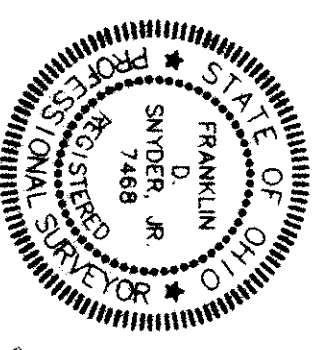

Grading Plan Approved
as shown and/or noted
THOMAS P. GILLES, P.E.
Lake County Engineer

By 6/14 Date 11.17.91
Lover F6's to 6912

SYMBOL LEGEND	
	Iron Pin Found
	Monnaie
	Curb Inlet
	Water Valve
	Cable TV Box
	Electrical Box
	Telephone Soc Box
	Tree & Size
	Tree To Be Removed

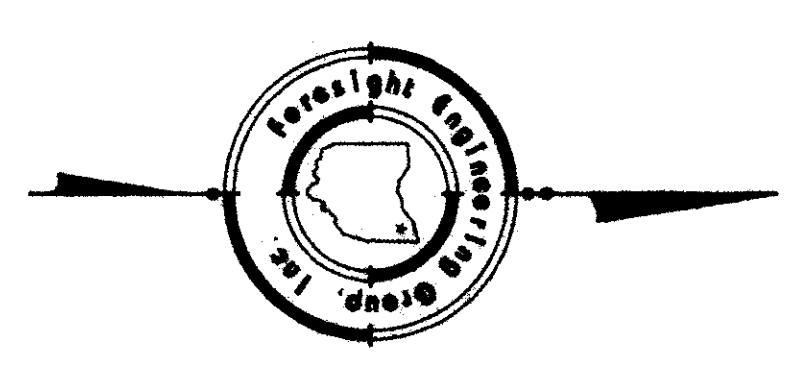

1360 Cedar Creek G

REVISIONS:	SCALE : Horz. 1" = 20' Vert. NONE
	FILE NAME: I:\RLM19605\SL-96
	DATE : Oct. 14, 1996

R.L. MOORE HOMES, INC.
Cedar Glenn Subdivision - S/L 96
Painesville Twp. - Lake County - Ohio
Site Plan

Foresight Engineering Group
216.286-1010
216.286-1034 fax
320 Center Street, Unit F
Garden, Ohio 44024

**Engineers &
Surveyors**