


Grading Plan Approved
as shown and/or noted
THOMAS P. GILLES, P.E.
Lake County Engineer

By TAM Date 10/1/00
Lower F.G. and swale as shown
Note 100 yr Flood zone

ROOF DRAINS
SHALL DISCHARGE
TO SPLASH BLOCKS.

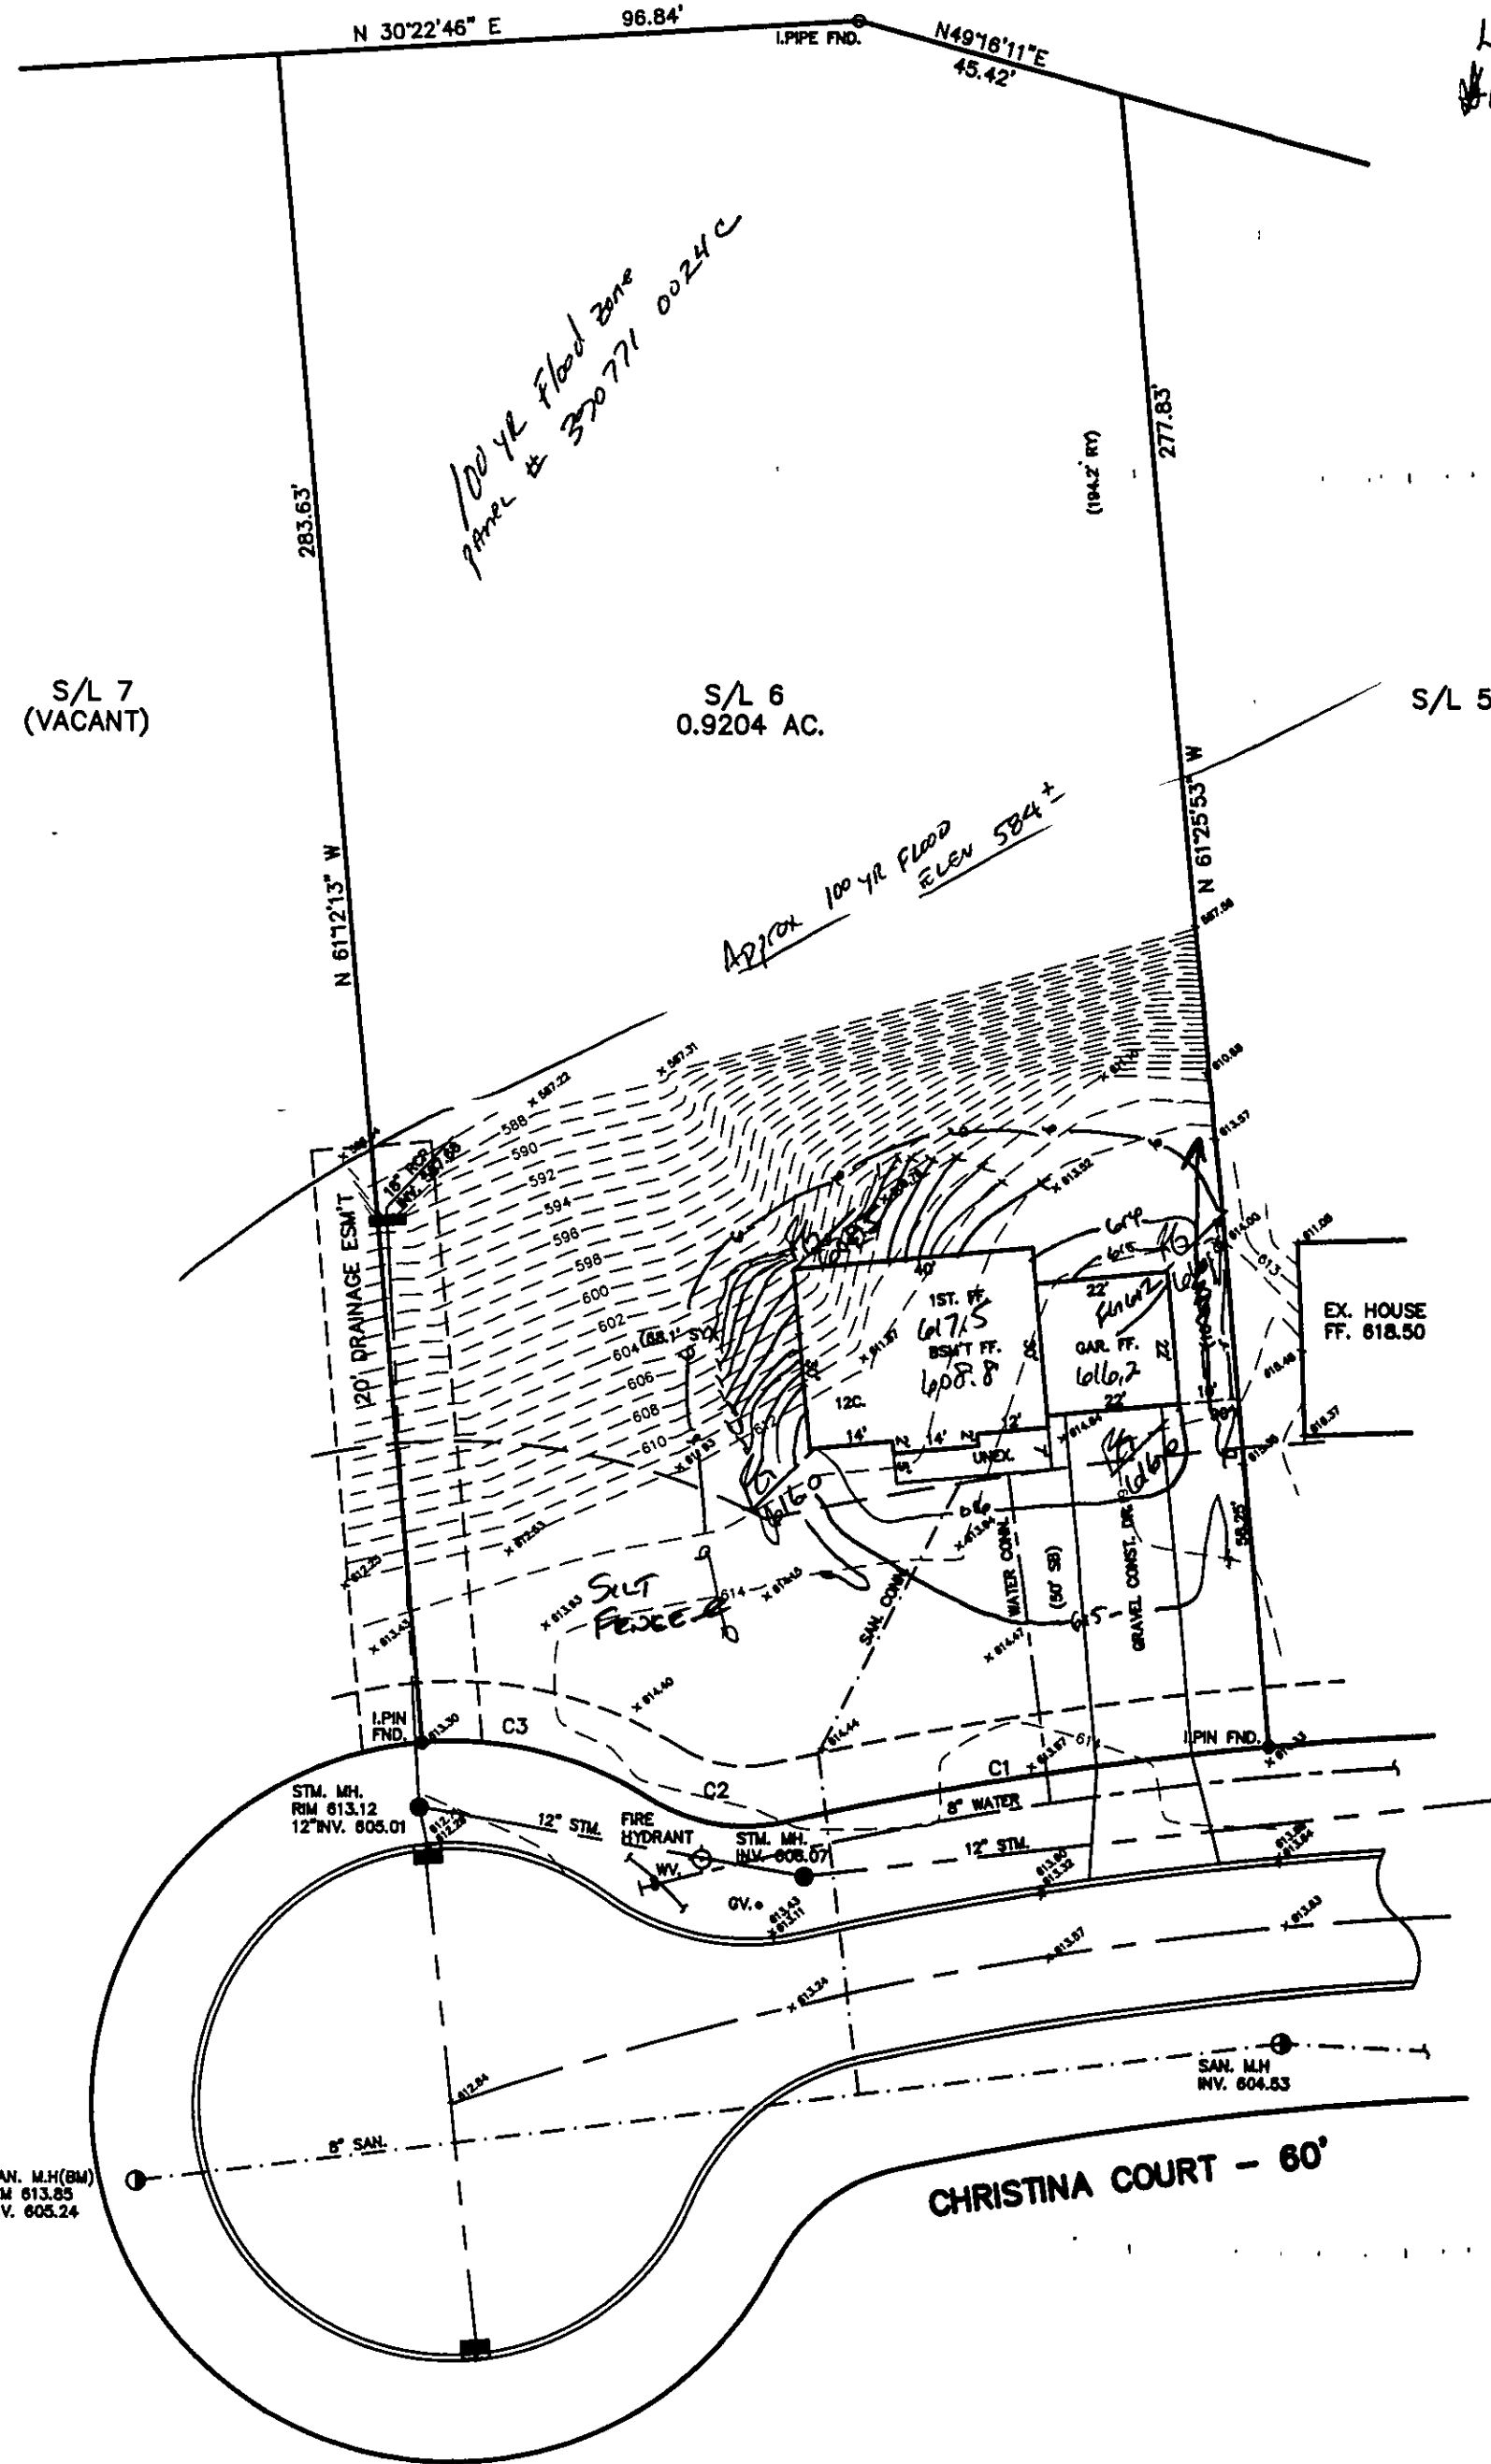

SITE PLAN

PAINESVILLE TWP., LAKE COUNTY, OHIO

for: MATOUSEK

CLIENT		OWNER	
ADDRESS	STREET	CITY	ZIP
TIBER CREEK		TRACT	
SUBDIVISION	NAME	LOT	STREET
34-15	CHRISTINA CRT.		
6	SUBLOT NO.	VOL-PG.	PERM. PARCEL NO.

LEGEND

SANITARY MANHOLE	---○---	EXIST. ELEV. ---	100.0	PROP. ELEV.
STORM MANHOLE	---●---	AS BUILT ELEVATION		
INLET OR CATCH BASIN	---■---	INDICATES		
HYDRANT	---◇---	DIRECTION OF		
EXISTING CONTOURS	---○---	SURFACE DRAINAGE		
PROPOSED CONTOURS	---○---			

REMARKS

ALL BOUNDARY DATA SHOWN WAS OBTAINED FROM (DEEDS, RECORDED
SUBDIVISION PLAT OR OTHER PUBLIC RECORDS)

LOCATIONS AS SHOWN OF ADJACENT WELLS AND SEPTIC TANKS OBTAINED FROM
LAKE COUNTY HEALTH DEPARTMENT

DESIGN CERTIFICATION

THIS PLAT WAS PREPARED BY ME, AND IS CORRECT
TO THE BEST OF MY KNOWLEDGE AND BELIEF.

NAME Harry S. Jones, Jr. REGISTRATION NO. 6343

CHECK LIST

NO. OF BEDROOMS	WATER MAIN SIZE, LOCATION
DIMENSIONS	SAN. SEWER SIZE & GR. LOC.
BEARINGS	SAN. MH. CAST. ELEV. INV. ELEV.
TIE TO NEAREST STREET	SAN. CONN. SIZE, LOC. DEPTH
SUBLOT NO. PARCEL NO.	STORM SEWER SIZE & GR. LOC.
SURROUNDING OWNERS	STORM MH. CAST. ELEV. INV. ELEV.
BLDG. DIMENSIONS FIN OR.	PWTY TYPE GRADE CURBS
BLDG. TIES FLTR. GRADES	GAS LINE LOC. SIZE PRESSURE
APRON TYPE WIDTH THICKNESS	SEPTIC TANK LOCATION & DUPLICATION AREA
SIDEWALK TYPE WIDTH THICKNESS	WELL LOCATION
CULVERT TYPE DIA., LENGTH	ISOLATION RADIUS FROM WELL
ROCK OUTCROPPINGS	

REVISIONS			PLAN PREPARED BY:		
NO.	DATE	BY	BABCOCK · JONES & ASSOCIATES, INC.		
1			PAINESVILLE, OHIO		
2			DRAWN BY T.R.	SCALE 1"=30'	PHONE NO. 440-367-1811
3			CHK'D. H.J.	DATE 9/25/00	DRAWING NO.
4			CREW CHIEF K.J.	APP'D H.J.	95-010-06

"AS BUILT" CERTIFICATION
I, HEREBY CERTIFY THAT THE CIRCLED GRADES ARE EXISTING
FINISH GRADES CHECKED IN THE FIELD ON _____, 20____
AND ARE CORRECT TO THE BEST OF MY KNOWLEDGE AND BELIEF.

REGISTERED SURVEYOR			REG. NO.
C1: R=631.11' L=81.85' T=40.98' D=07°25'51" C=81.79' N24°51'18"E	C2: R=30.00' L=23.67' T=12.49' D=45°12'45" C=23.06' S43°44'45"W	C3: R=60.00' L=39.33' T=20.40' D=37°33'28" C=38.63' N47°34'24"E	

BM-SANITARY MH.

RIM=613.85

BM-SANITARY MH.
RIM=613.85

NOTE: TEMPORARY SEEDING REQUIRED
IN DISTURBED AREAS.

APPROVED
PAINESVILLE TOWNSHIP
ZONING DEPARTMENT
2000342
D. Rust

