


W:\2002\02063\02063-32.dwg, 01/03/03 08:09:32 AM, Copyright Barrington Consulting Group

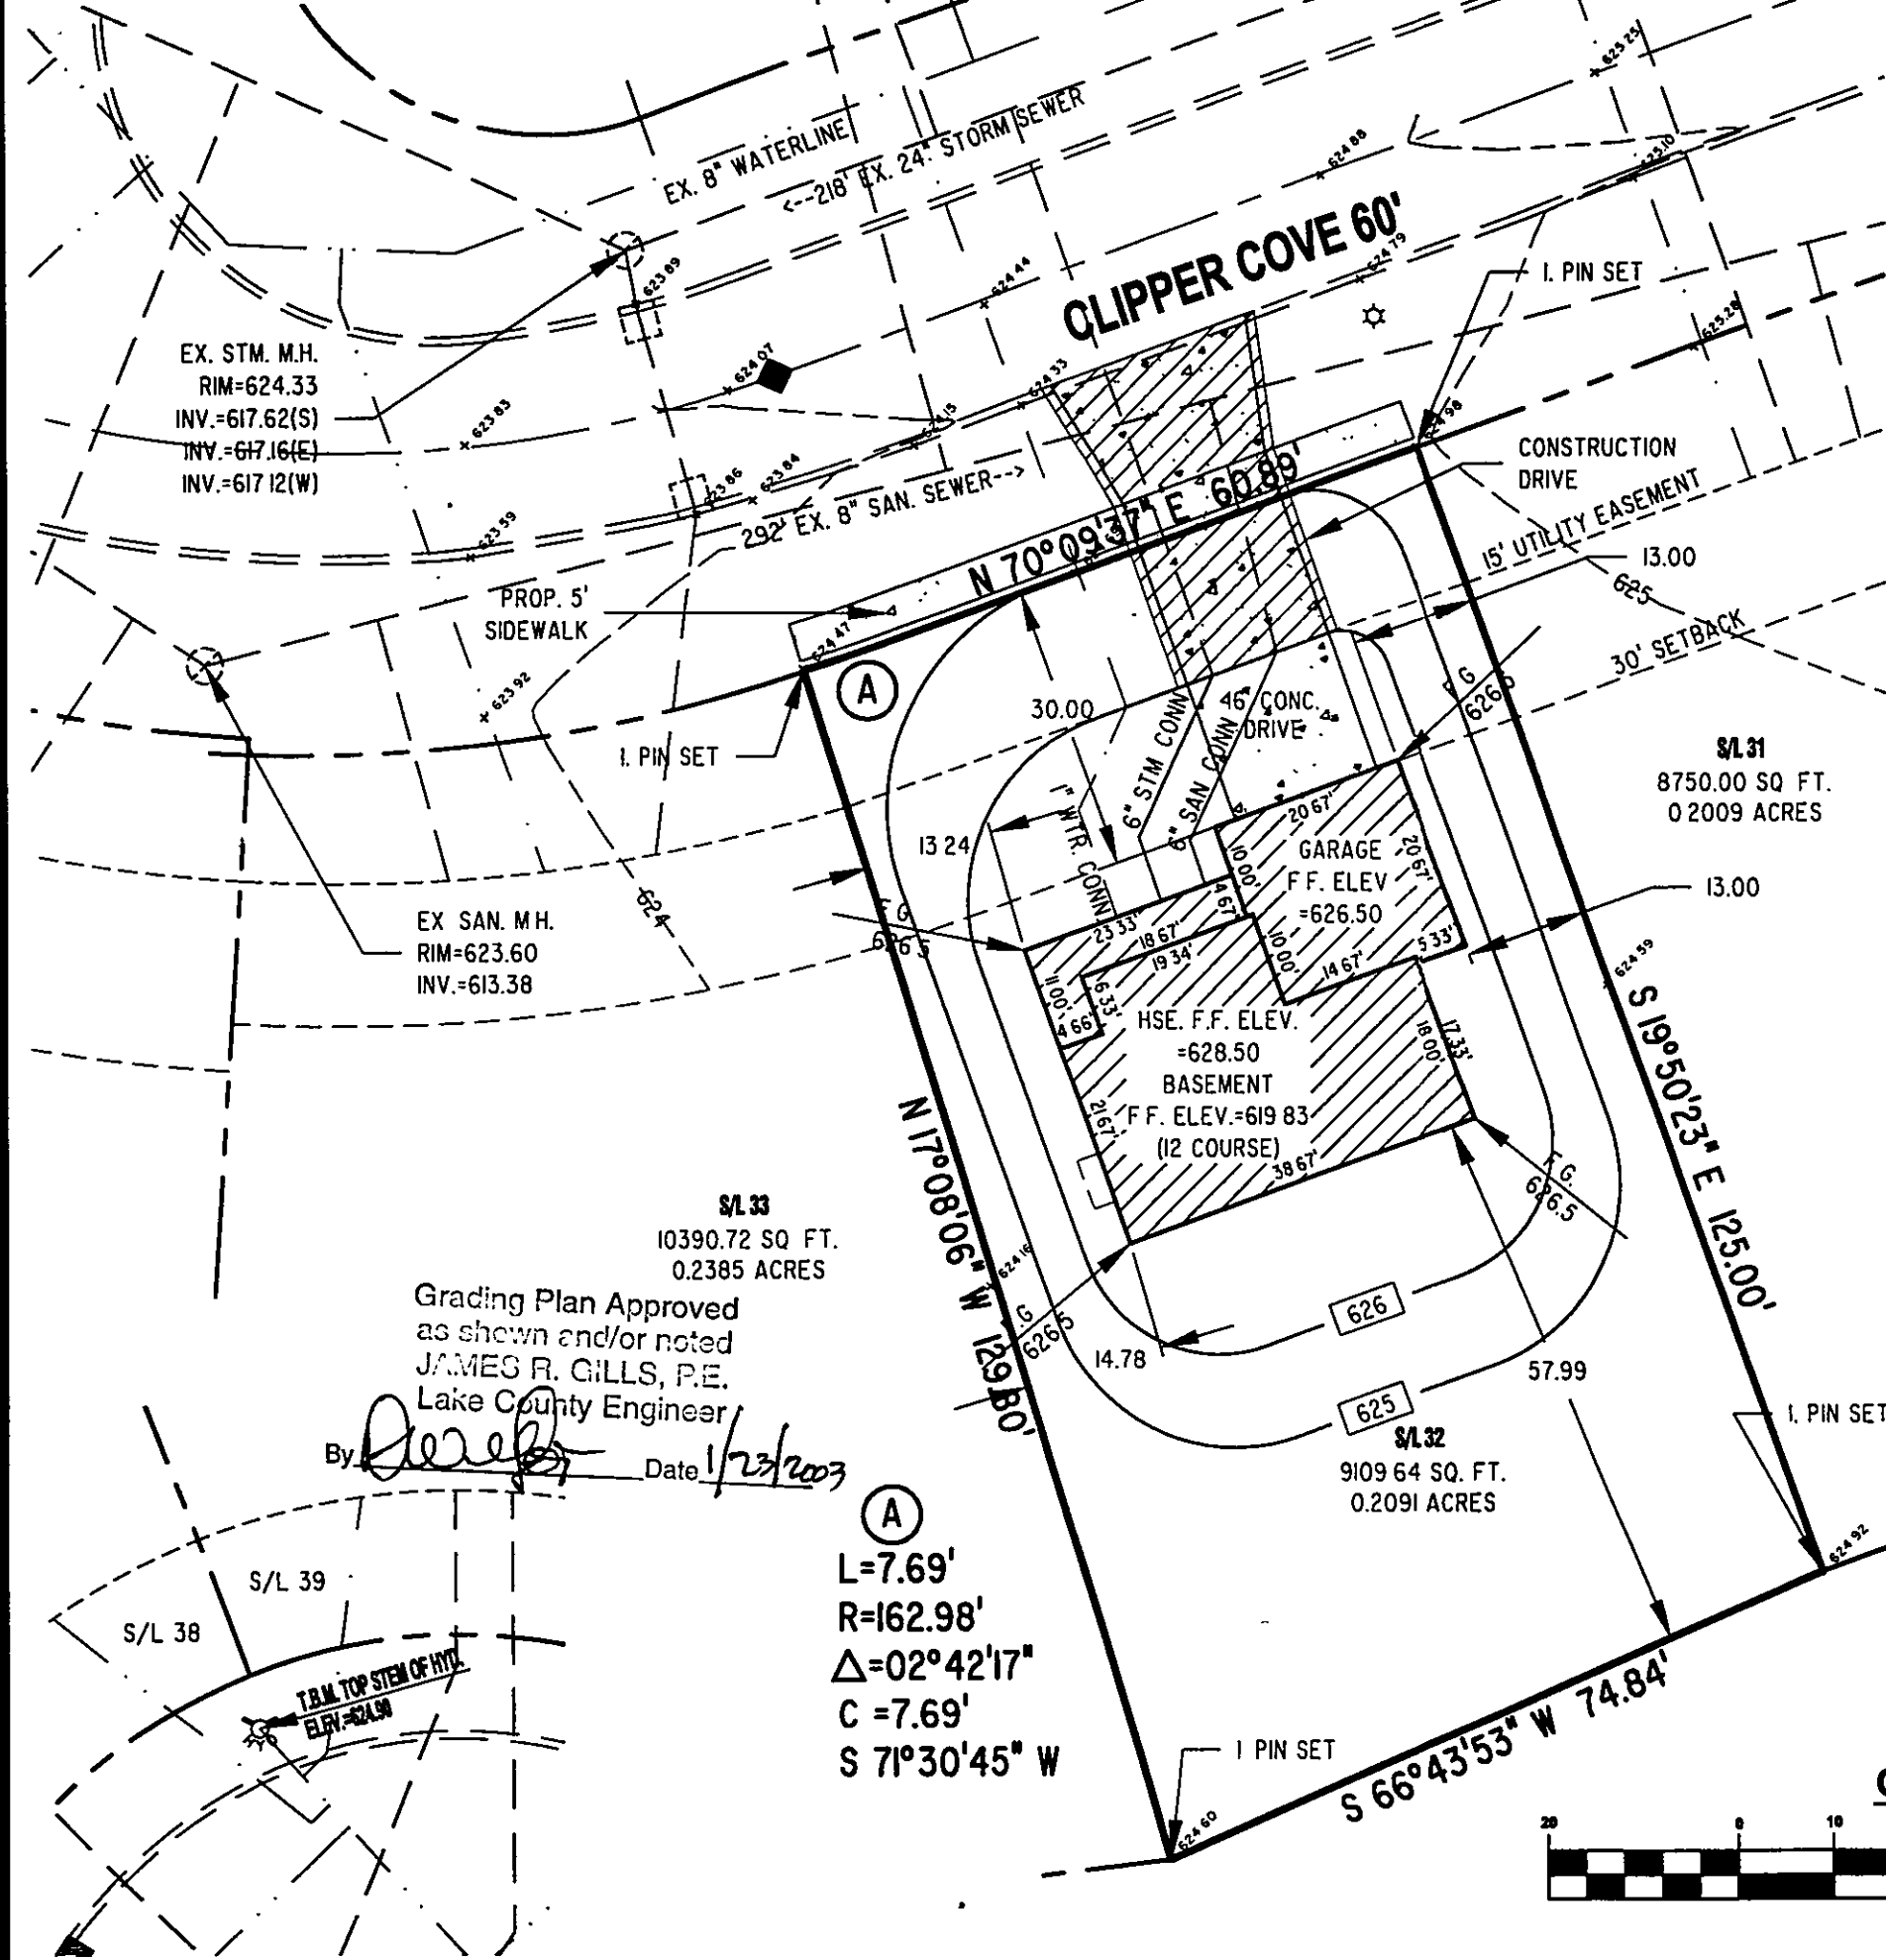

**GENERAL NOTES:**

1. BENCHMARK - TOP STEM OF EXISTING FIRE HYDRANT LOCATED IN FRONT OF SUBLOT 38, ELEVATION = 624.90.
2. DRIVEWAY APRON TO BE 6" THICK CONCRETE.
3. ALL DOWNSPOUTS TO BE OUTLETTED TO SPLASH BLOCKS.
4. CONTRACTOR RESPONSIBLE FOR CONTACTING THE OHIO UTILITY PROTECTION SERVICE (1.800.362.2764) AND ALL UTILITY COMPANIES A MINIMUM OF 48 HOURS PRIOR TO CONSTRUCTION.
5. THE LOCATION BOTH HORIZONTAL AND VERTICAL OF EXISTING UNDERGROUND UTILITIES SHOWN HEREON, HAVE BEEN OBTAINED BY A DILIGENT AND COMPREHENSIVE SEARCH OF AVAILABLE RECORDS. VERIFICATION BY FIELD OBSERVATION HAS BEEN CONDUCTED WHERE PRACTICAL, HOWEVER, BARRINGTON CONSULTING GROUP, INC. DOES NOT GUARANTEE THE COMPLETENESS, NOR ACCURACY THEREOF.
6. CONTRACTOR SHALL VERIFY ELEVATIONS OF LATREAL INVERTS IN THE FIELD PRIOR TO FOUNDATION EXCAVATION.
7. EROSION AND SEDIMENT-CONTROL PRACTICES TO BE INSTALLED AS DESCRIBED IN THE RAIN WATER LAND DEVELOPMENT MANUAL AS DIRECTED BY THE LAKE COUNTY SOIL AND WATER CONSERVATION DISTRICT.
8. TEMPORARY SEEDING SHALL BE APPLIED ON ALL DISTURBED SOIL THAT WILL NOT BE REWORKED FOR WITHIN 30 DAYS. THESE IDLE AREAS TO BE SEEDED WITHIN 7 DAYS.


**CERTIFICATION :**

**"I THE UNDERSIGNED HEREBY CERTIFIES THAT THIS TOPOGRAPHY INDICATED BY 1 FOOT CONTOURS AND ELEVATION SHOWN HEREON REPRESENTS AN ACTUAL SURVEY MADE BY ME ON THE 18th DAY OF DECEMBER, 2002 AND THE ELEVATIONS WERE TAKEN AT AN APPROPRIATE INTERVAL AND AS OF THAT DAY THEY EXISTED AS INDICATED HEREON.**

**"I HEREBY CERTIFY THAT THIS PLAN WAS PREPARED BY ME AND IS  
CORRECT TO THE BEST OF MY KNOWLEDGE AND BELIEF"**


DAVID W. NOVAK, P.S. No. 7507

**CERT-1.DWG**

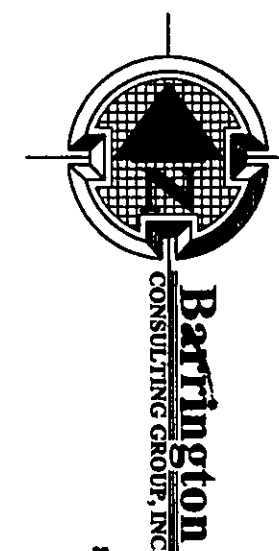

APPROVED  
PAINESVILLE TOWNSHIP  
ENGINEERING DEPARTMENT

### GRAPHIC SCALE

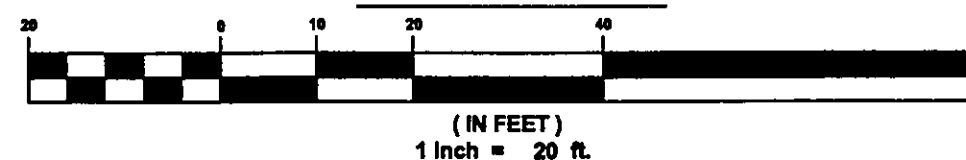

02063-32

[illegible]

**Barrington**  
CONSULTING GROUP, INC.  
35342 WESTERN PARKWAY, SUITE 10  
WILLOUGHBY, OHIO 44094  
PHONE 440 946 1761 FAX 440 918 0486



**SITE PLAN**  
SIL 32 CLIPPER COVE, PAINESVILLE TWP. OHIO 44077  
LAKE ERIE SHORES PHASE 1

**CANTERBURY HOMES**

DRAWN  
 WSO  
 CHECKED  
 DWN  
 DATE  
 DEC. 23, 2002  
 SCALE  
 1" = 20'  
 JOB NO  
 02063-32  
 SHEET  
 1/1  
 OF SHEETS