


B.M. - RIM SAN. M.H.
ASSUMED EL. 100.00

DOAN AVENUE 50'

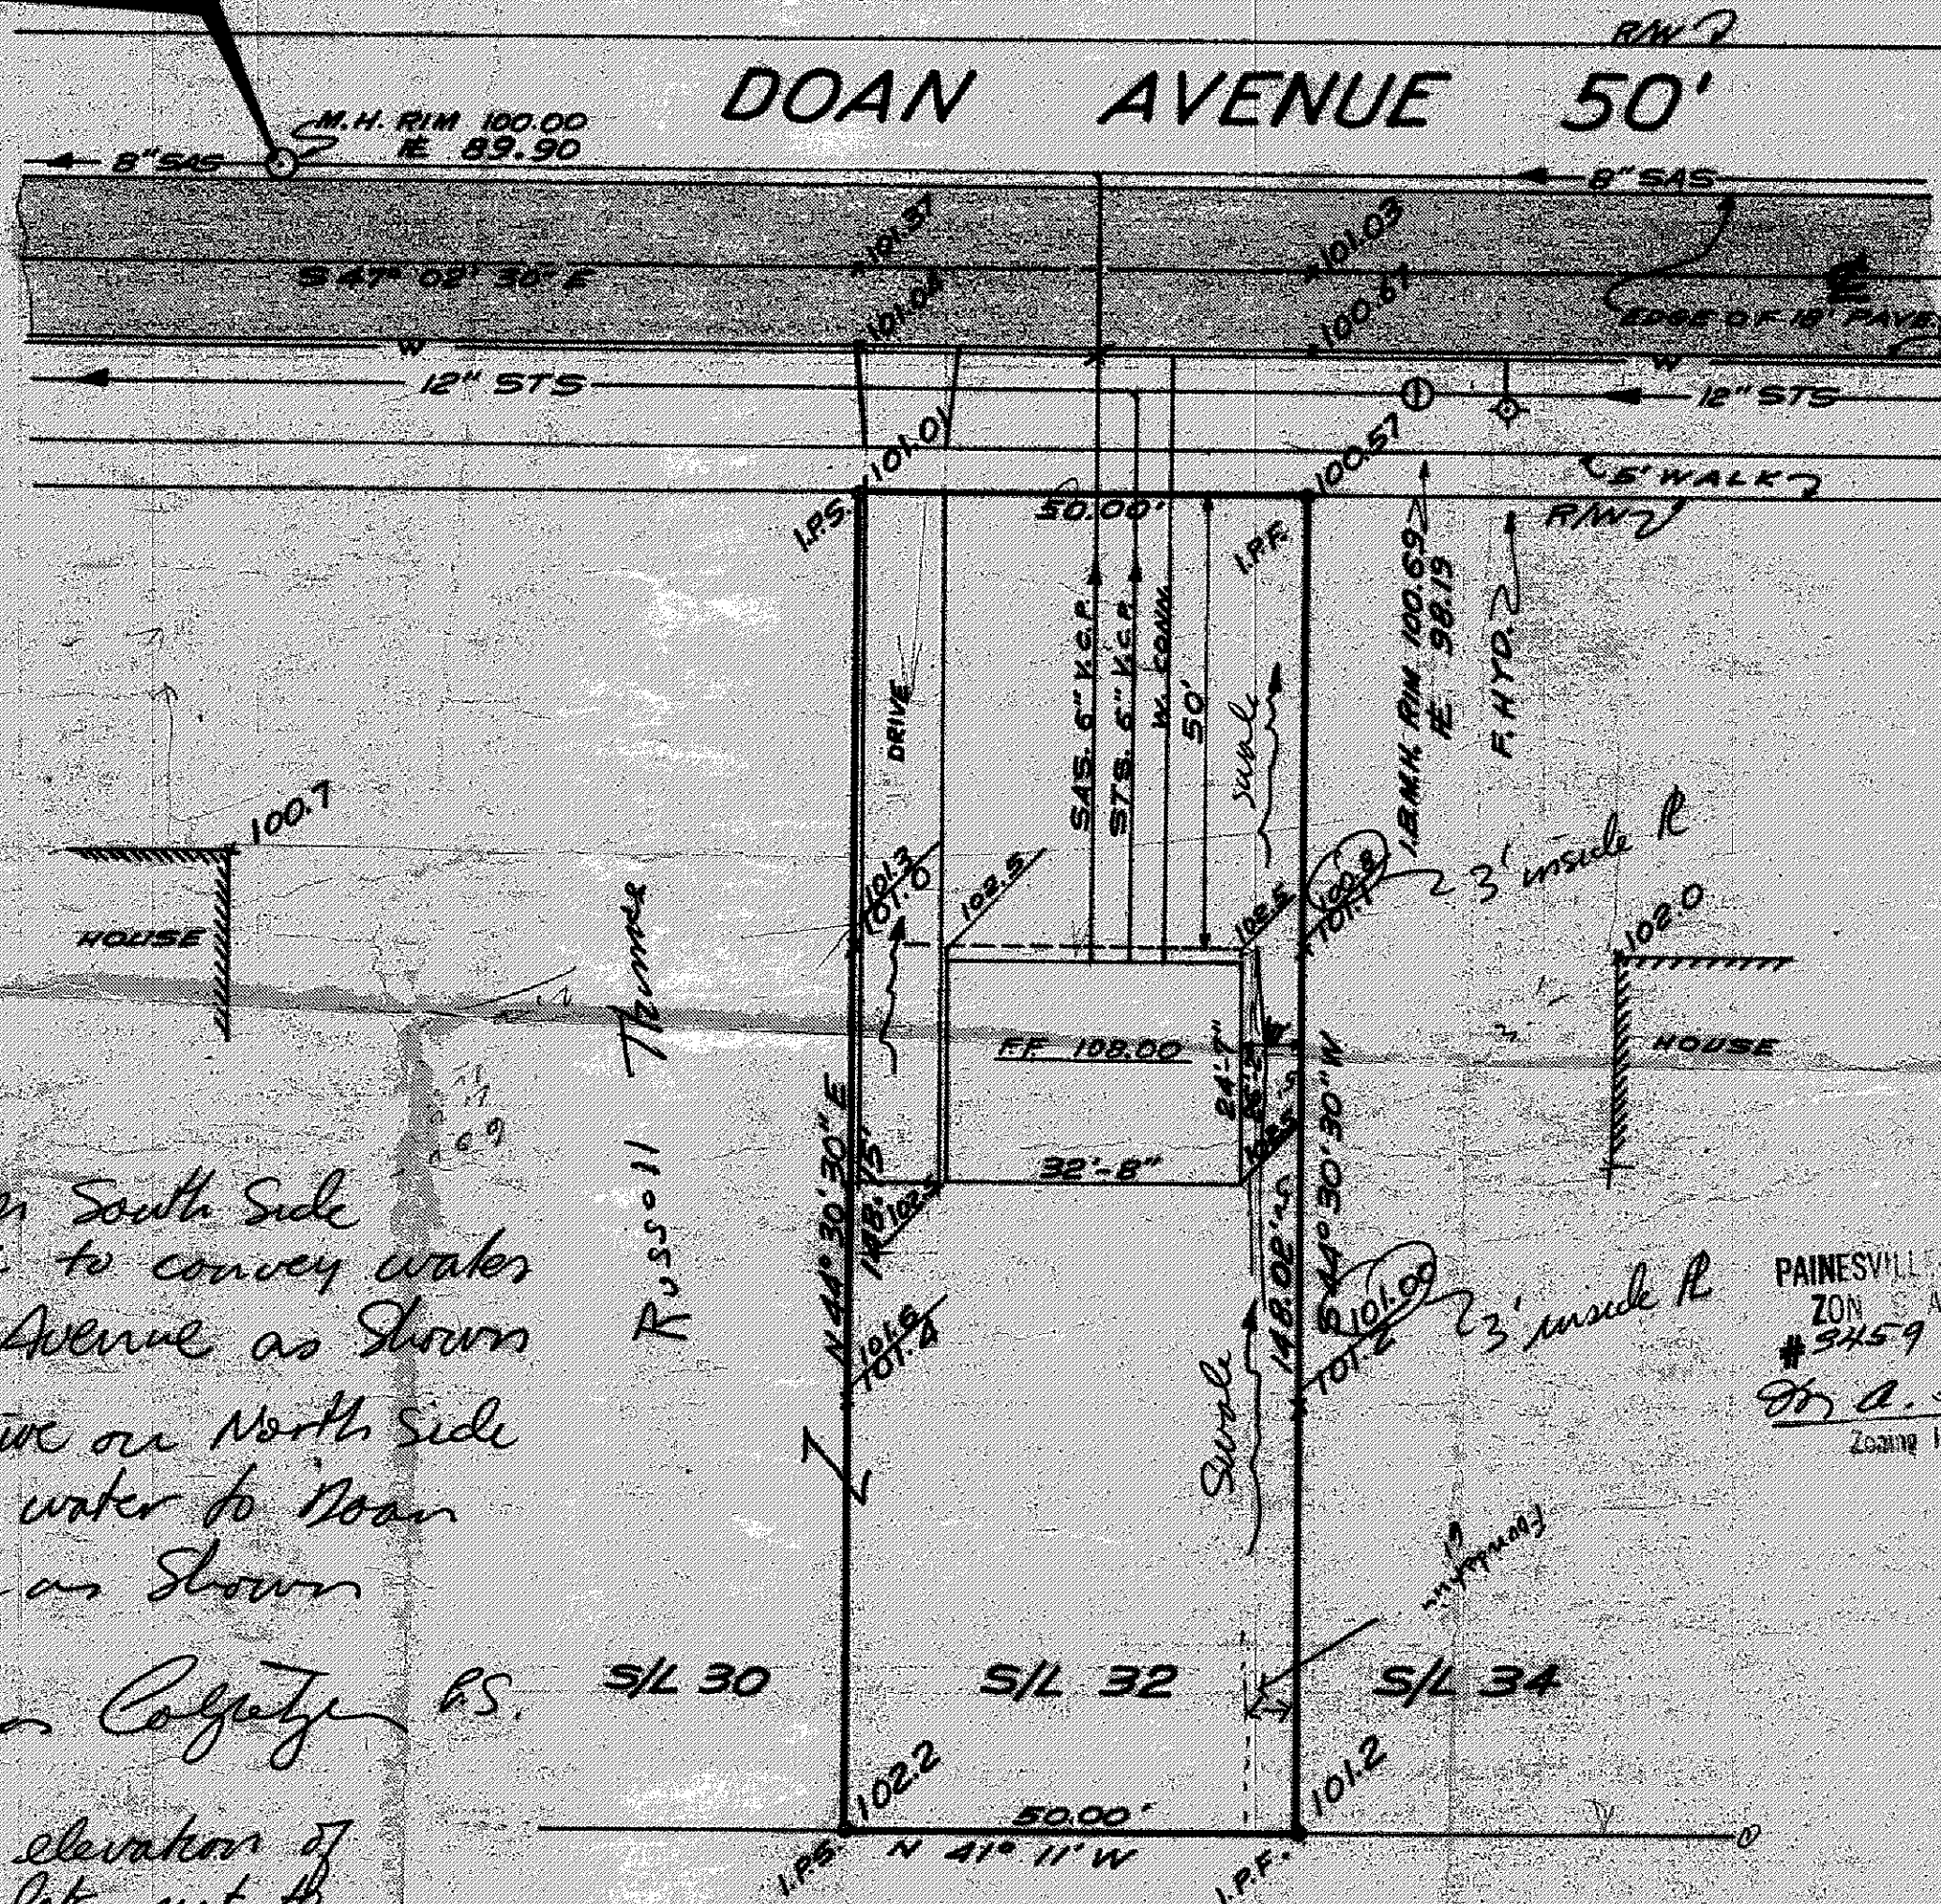

1. Swale on South Side of S/L 32 to convey water to Doan Avenue as shown
2. Slope drive on North Side to convey water to Doan Avenue as shown

Thomas Colpetzer P.E.

3. Existing elevation of adjacent lots not to be disturbed
4. Revised grades apply 3' inside property line.

Grading Plan Approved
as shown and/or noted
THOMAS P. GILLES, P.E.
Lake County Engineer

By J.W.K. Date 6-7-74

NOTE:- UNDERLINED ELEV. ARE PROPOSED FINISH GRADE.

PAINESVILLE TOWNSHIP
ZONING APPROVED
#3459 6-28-74
By A. Neidner
Zoning Inspector

"AS BUILT" CERTIFICATION
I, HEREBY CERTIFY THAT THE CIRCLED GRADES ARE EXISTING
FINISH GRADES CHECKED IN FIELD ON 12
SURVEY IS CORRECT TO THE BEST OF MY KNOWLEDGE AND BELIEF

REGISTERED SURVEYOR No.

74-124

GRADING PLAN
FOR
RUSSELL THOMAS
STANLEY ALLOT. S/L 32, PAINESVILLE TWP., LAKE COUNTY, OHIO
Colpetzer • Woods Consultants, Inc.
CONSULTING ENGINEERS AND SURVEYORS
PAINESVILLE, OHIO 44077

DATE 5-10-74
SCALE 1"=20'
DRAWN BY SAL
CHECKED BY J.W.K.
P.E. 255-74