


June 1963

Grading Plan Approved
as shown and/or noted
THOMAS P. GILLES, P.E.
Lake County Engineer

S 83°50'00"E 100.00'

By JWK Date 2-11-74

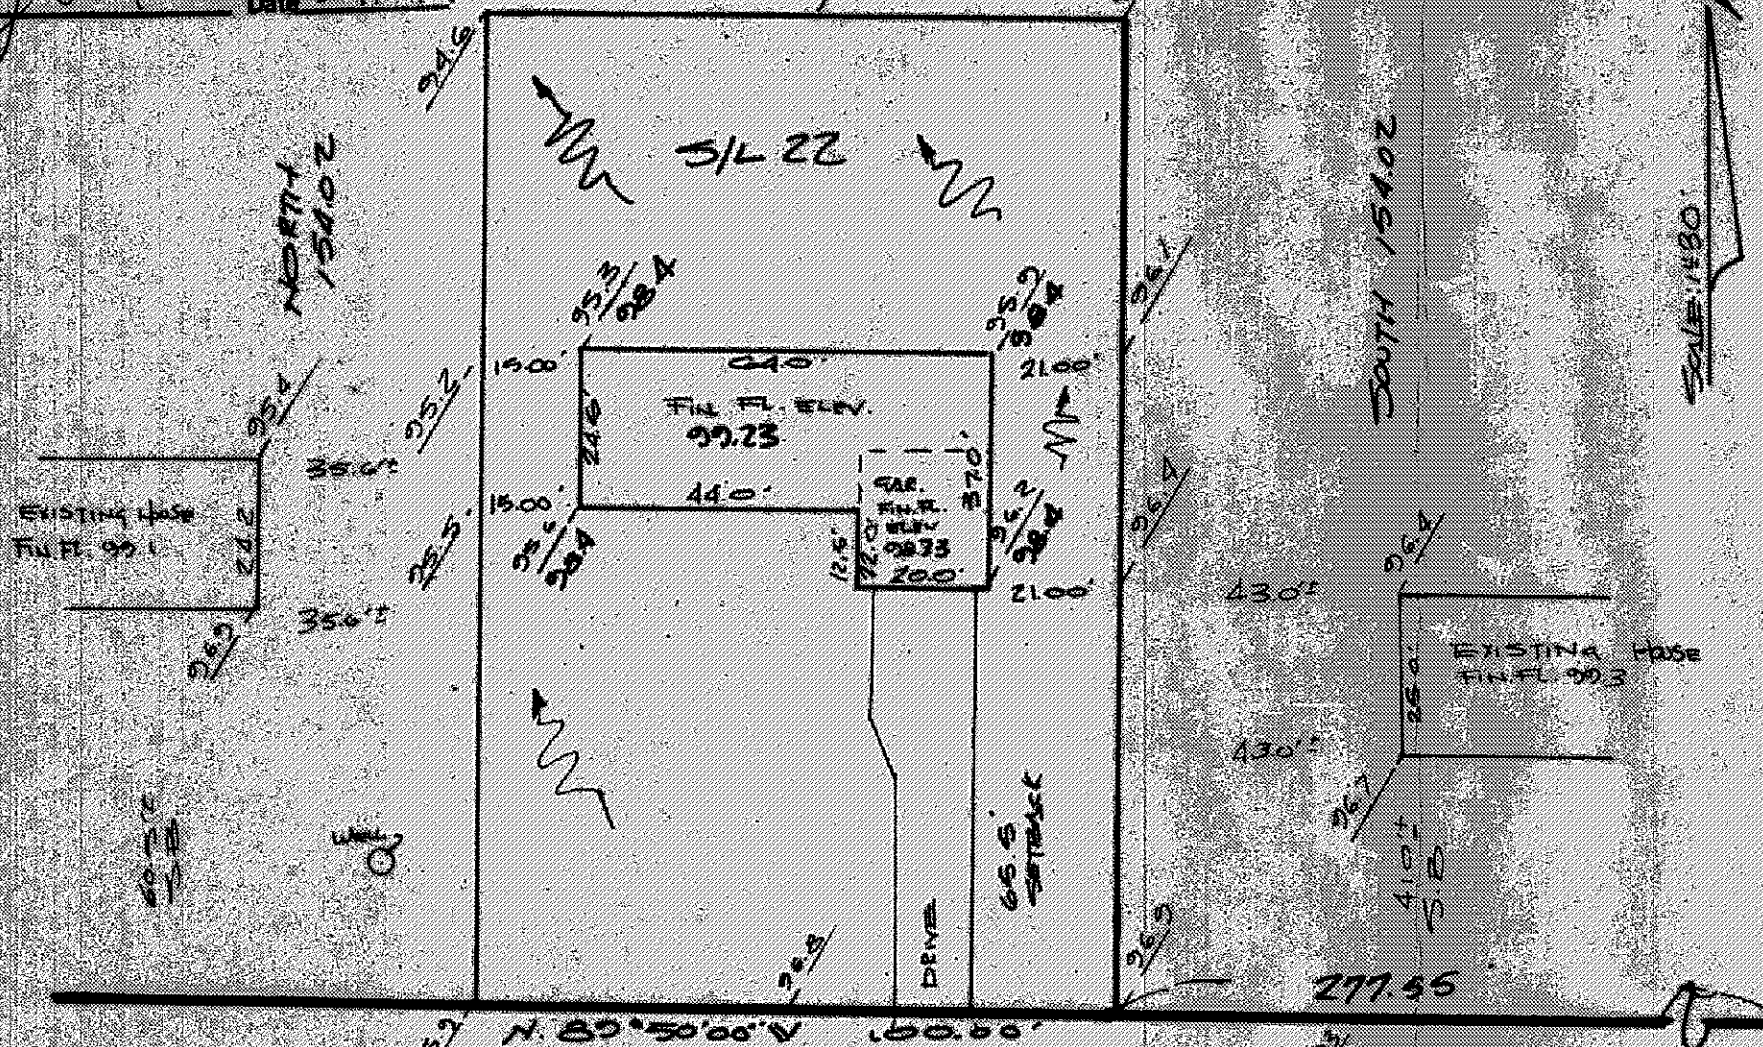

MORGAN DR. 40'

SITE PLAN

PAINESVILLE TWP. LAKE COUNTY, OHIO

for INTERLINE HOMES
CLIENT OWNER

ADDRESS STREET CITY ZIP

AB BARTO SUBD.
SUBDIVISION 11-18 NAME
#22 VOL. PB
SUBLOT NO. DORCHESTER STREET

LOT TRACT
VOLUME PAGE
PERM. PARCEL # STREET

LEGEND

SANITARY MANHOLE WATER VALVE (GAS)
STORM MANHOLE WATER METER (GAS)
INLET OR CATCH BASIN AS BUILT ELEVATION
HYDRANT INDICATES
EXISTING CONTOURS DIRECTION OF
PROPOSED CONTOURS SURFACE DRAINAGE
EXIST. ELEV. 100.0 PROP. ELEV. 100.0

REMARKS

ALL BOUNDARY DATA SHOWN WAS OBTAINED FROM (DEEDS RECORDED
SUBDIVISION PLAT OR OTHER PUBLIC RECORDS.)

DESIGN CERTIFICATION

THIS PLAN WAS PREPARED BY ME, AND IS CORRECT
TO THE BEST OF MY KNOWLEDGE AND BELIEF TS #5244

NAME SURVEYOR REGISTRATION NO.

CHECK LIST

DIMENSIONS
BEARINGS
TIE TO NEAREST STREET
SUBLOT NO. PARCEL NO.
SURROUNDING OWNERS
BLDG DIMENSIONS FIN. GR.
BLDG TIES FLR GRADES
APRON TYPE WIDTH THICKNESS
SIDEWALK TYPE WIDTH THICKNESS
CULVERT TYPE DIA. LENGTH

WATER MAIN SIZE LOCATION
SAN SEWER SIZE % GR. LOC.
SAN MH CAST ELEV. INV. ELEV.
SAN CONN. SIZE LOC. DEPTH
STORM SEWER SIZE % GR. LOC.
STORM MH CAST ELEV. INV. ELEV.
PAVT TYPE GRADE CURBS
GAS LINE LOC. SIZE PRESSURE
SEPTIC TANK SIZE LOC.
WELL LOCATION

REVISIONS

NO.	DATE	BY
1		
2		
3		
4		
5		

PLAN PREPARED BY

DEBEVEC SALO & ASSOC, INC.

130 EAST JACKSON ST. PAINESVILLE

DRAWN BY VB SCALE 1"=30' PHONE NO.
CHK'D DATE 2-6-74 DRAWING NO.
CREW APPD 3002-22

"AS BUILT" CERTIFICATION

I, HEREBY CERTIFY THAT THE CIRCLED GRADES ARE EXISTING FINISH
GRADES CHECKED IN FIELD ON 2-11-74 BY
SURVEYING AND ARE CORRECT TO THE BEST OF MY KNOWLEDGE AND BELIEF

REGISTERED SURVEYOR

REG. NO.

PAINESVILLE TOWNSHIP
ZONING APPROVED

3403 2-11-74

Dr. A. Neudorfer
Zoning Inspector