

This Permit Expires

MAY 1 1980

PAINESVILLE TOWNSHIP

ZONING APPROVED

#4769

R.M. Haul

Zoning Inspector

5/2/79

I.R.C. FIBER CO.

V.728 P.442

NOTE: DOWN SPOUTS TO
EMPTY INTO SWALE ALONG
PROPERTY LINES.


BENCH MARK TOP OF
HYD. IN FRONT OF S/L 24.
ELEV. 634.38

UNDERLINED ELEVATIONS
ARE PROPOSED FINISHED
GRADES.

S/L 25

S/L 26
0.293 Ac.

S/L 27

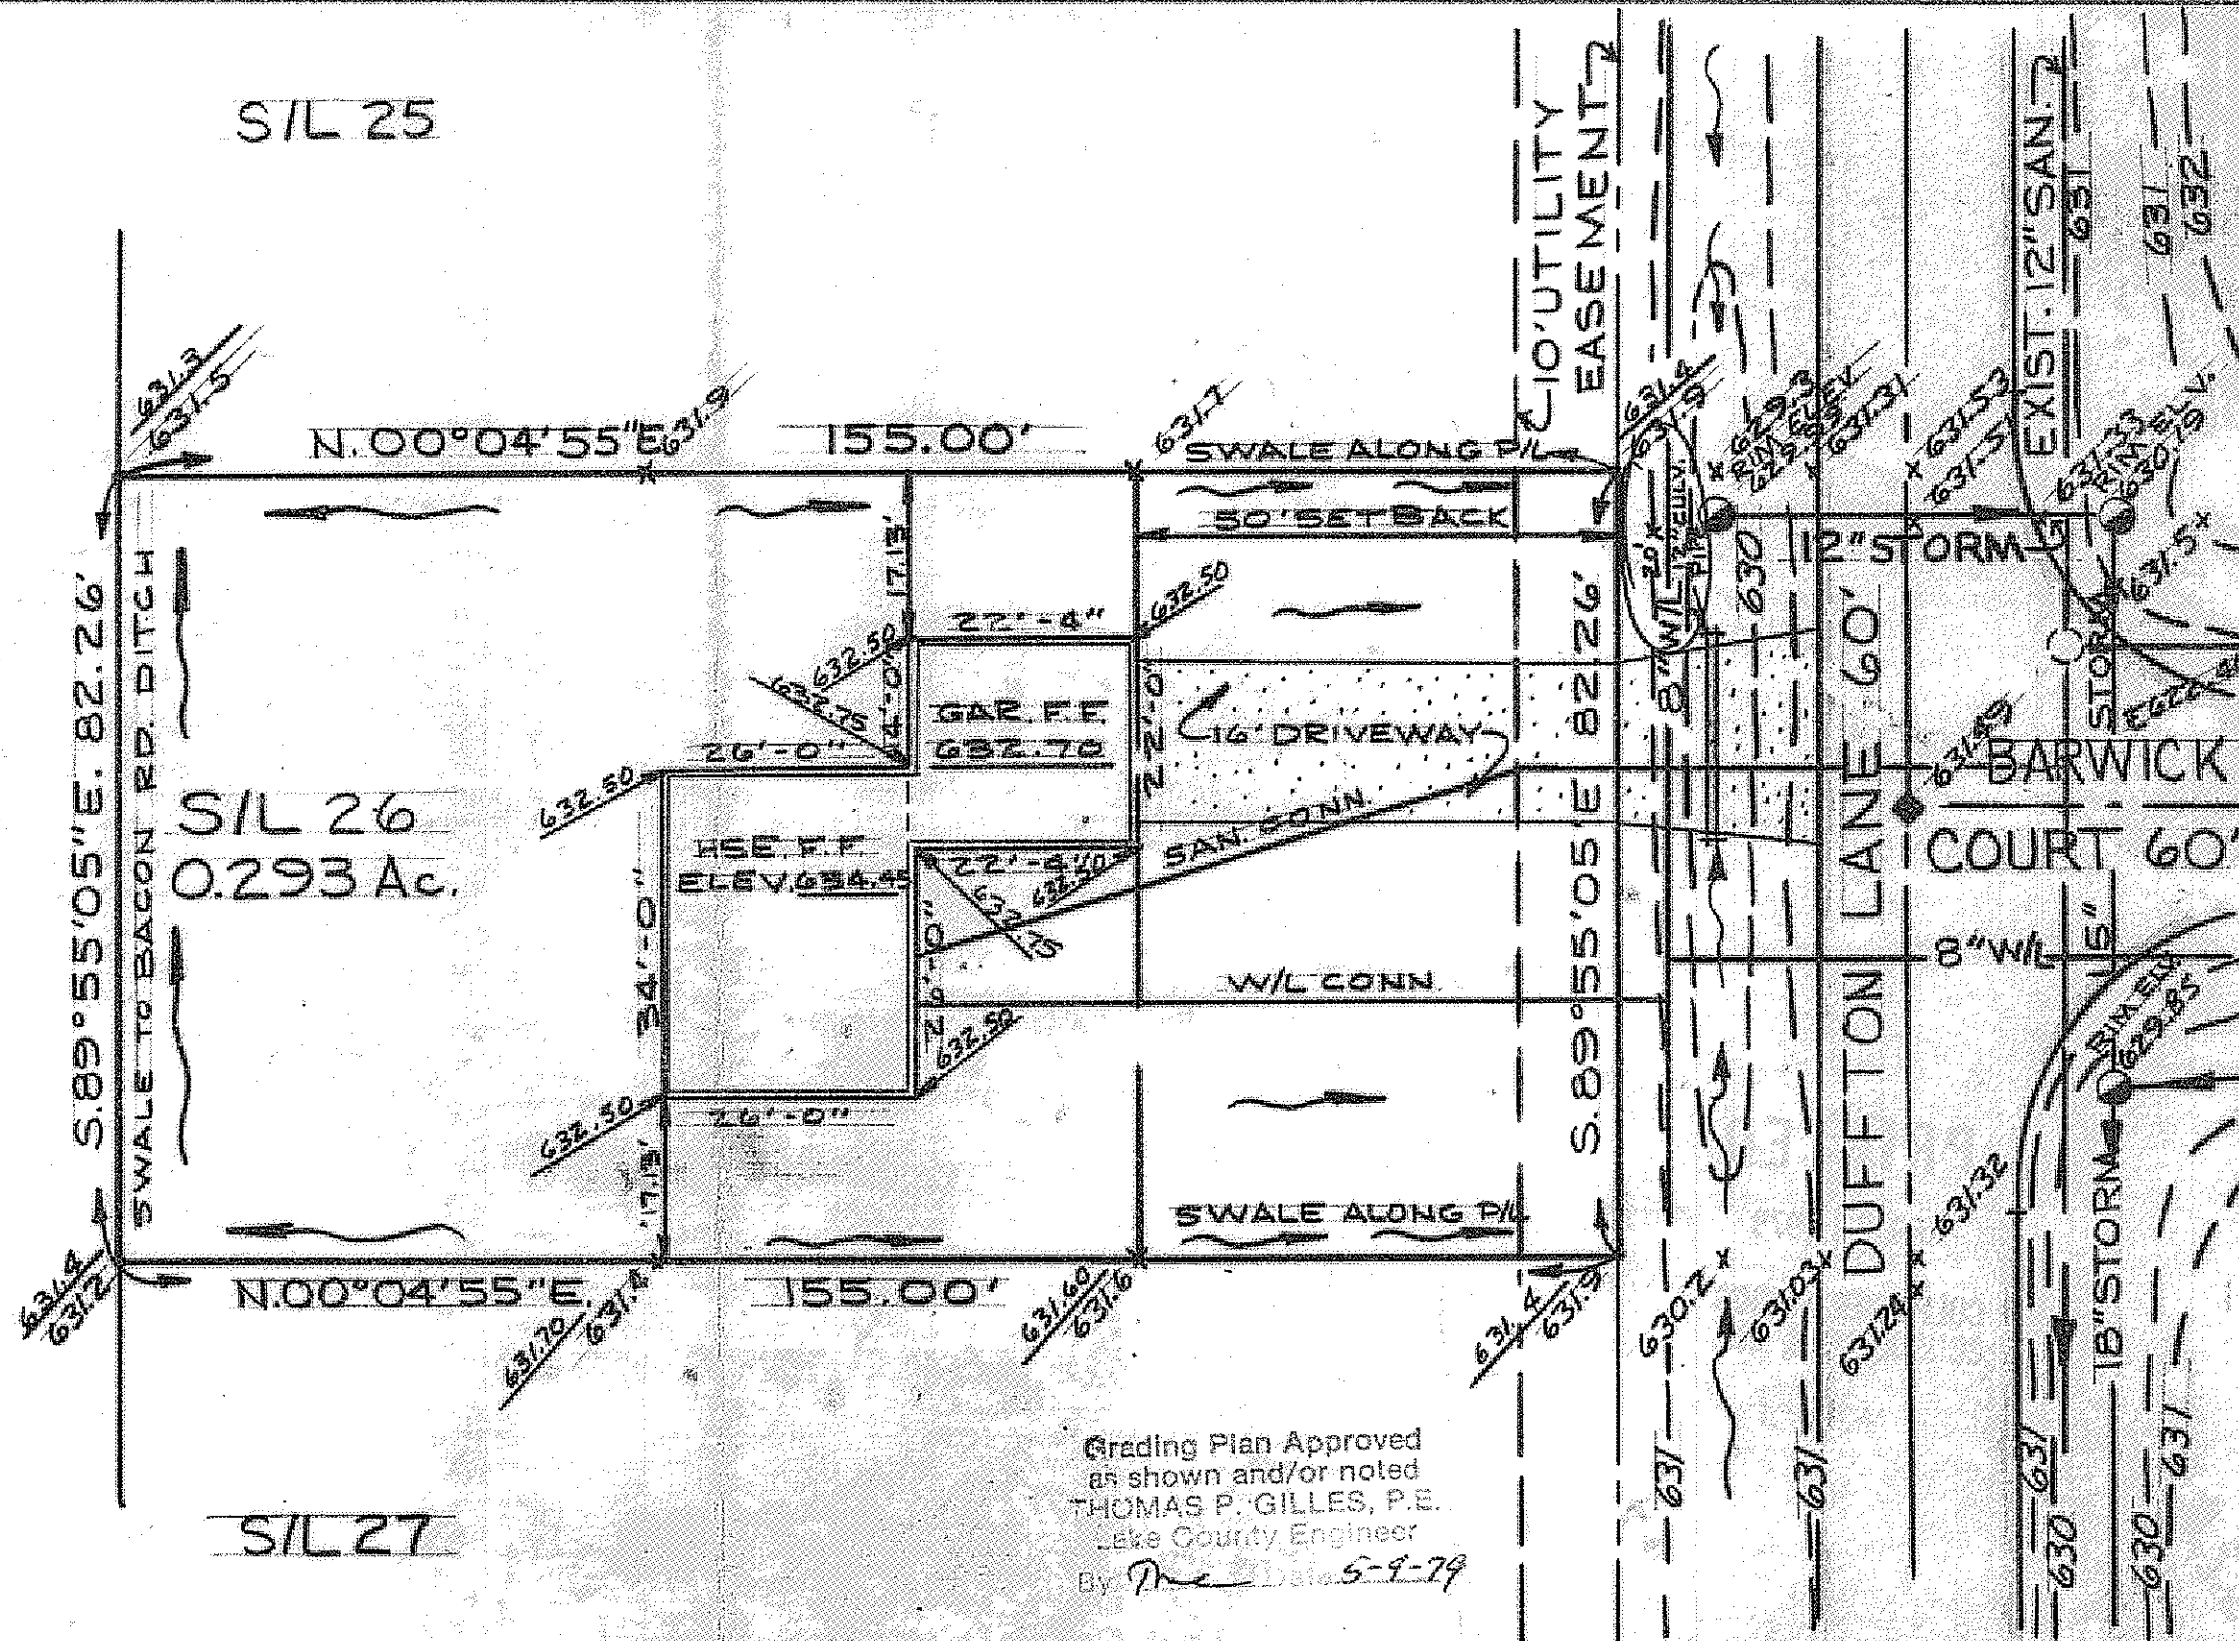

Grading Plan Approved
as shown and/or noted
THOMAS P. GILLES, P.E.
Lake County Engineer
By *Thomas P. Gilles* Date 5-9-79

DESIGN CERTIFICATION

THIS PLAT WAS PREPARED BY ME,
AND IS CORRECT TO THE BEST OF
MY KNOWLEDGE AND BELIEF.

Clippie
REG. SURVEYOR NO. 4785

AS BUILT CERTIFICATION

I HEREBY CERTIFY THAT THE CIRCLED GRADES
ARE EXISTING FINISH GRADES CHECKED IN THE
FIELD ON _____ AND THAT
SURVEY IS CORRECT TO THE BEST OF MY
KNOWLEDGE AND BELIEF.

REG. SURVEYOR NO. _____



COLPETZER WOODS
CONSULTANTS, INC.

(216) 357-7569

DATE 3/9/79

SCALE 1"=20'

DRAWN BY J.E.

CHKD BY

JOB NO. 76/156

REG. SURVEYOR NO. _____

SITE PLAN FOR
EDWARD H. TRESGER INC.
8100 DEEPWOOD BLVD. MENTOR
OHIO S/L 26 IN THE PINES
SUBD. NO. 2, PAINESVILLE OHIO