


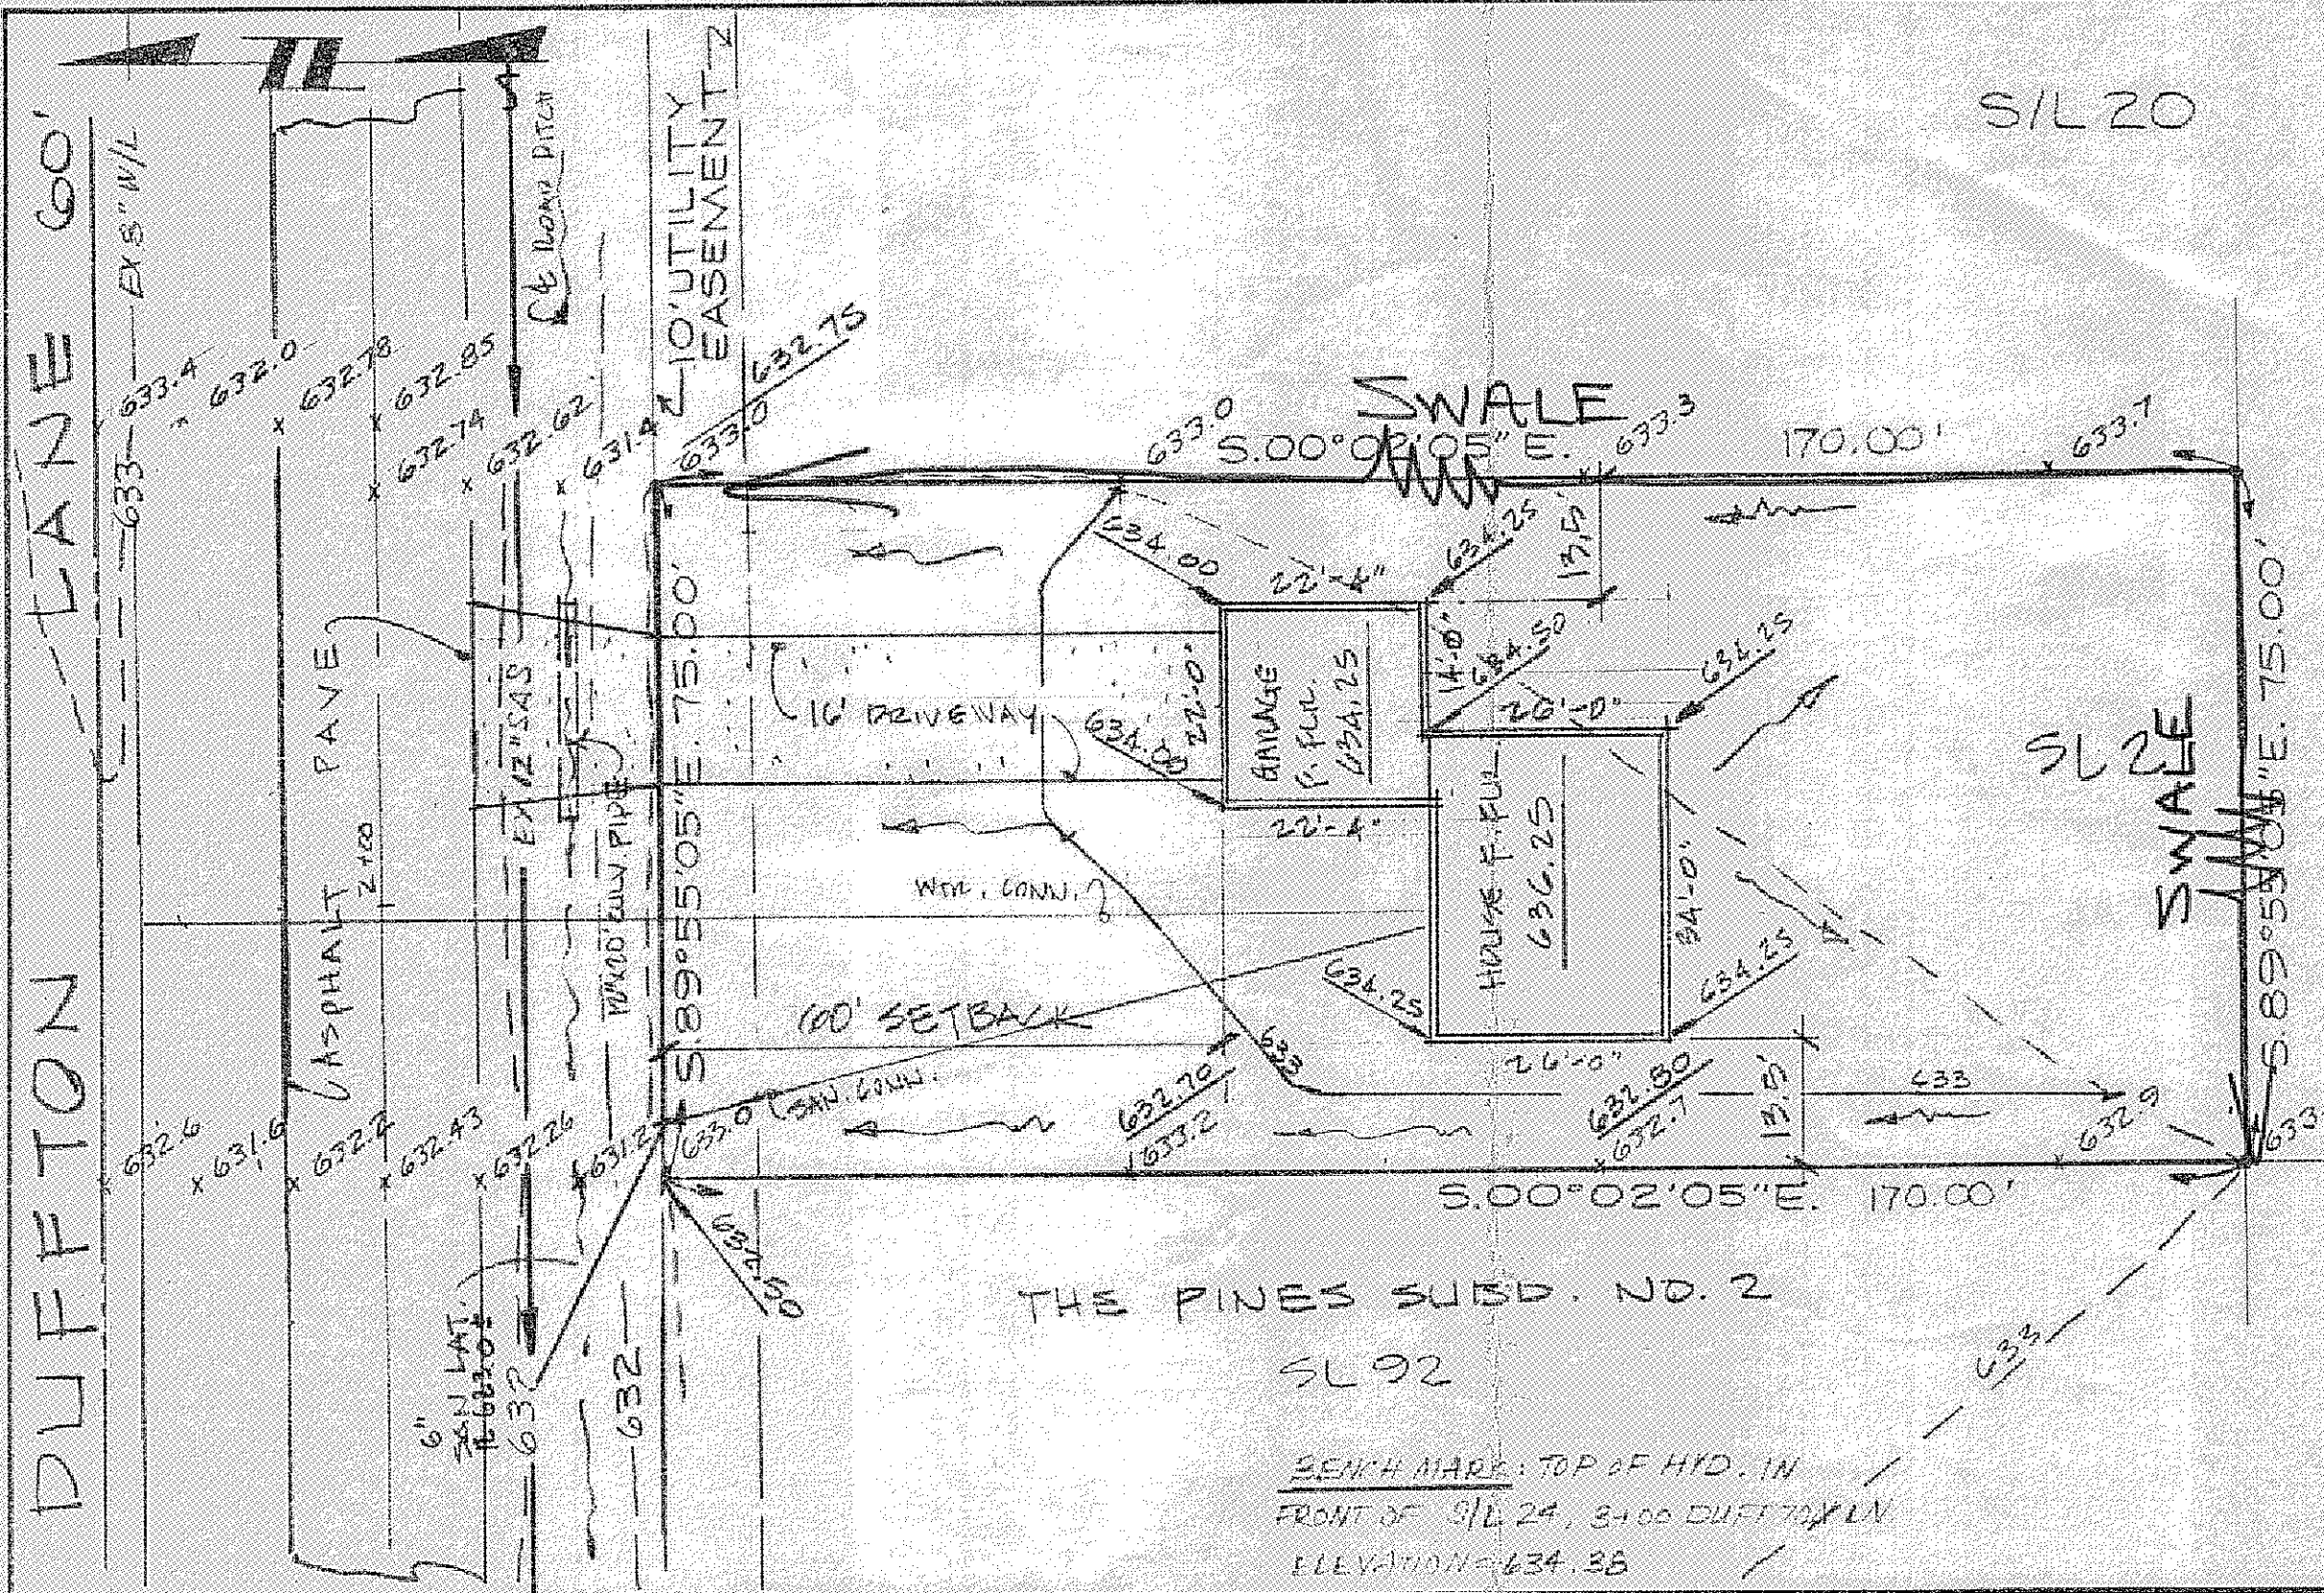

PAINESVILLE TOWNSHIP  
ZONING APPROVED  
# 4714  
R.M. Haul  
Zoning Inspector  
3/23/79

Grading Plan Approved  
as shown and/or noted  
THOMAS P. GILLES, P.E.  
Lake County Engineer  
Date 3-23-79  
BY RMC SL 19

UNDERLINED ELEVATIONS  
ARE PROPOSED  
FINISHED GRADES

|                                                                                                                                                                                      |                                                                                                                                                                                                                                                 |                                                                          |                                                                                                           |                                                                                                                                                        |
|--------------------------------------------------------------------------------------------------------------------------------------------------------------------------------------|-------------------------------------------------------------------------------------------------------------------------------------------------------------------------------------------------------------------------------------------------|--------------------------------------------------------------------------|-----------------------------------------------------------------------------------------------------------|--------------------------------------------------------------------------------------------------------------------------------------------------------|
| <p><b>DESIGN CERTIFICATION</b></p> <p>THIS PLAT WAS PREPARED BY ME, AND IS CORRECT TO THE BEST OF MY KNOWLEDGE AND BELIEF.</p> <p><u>Chris Gilles</u><br/>REG. SURVEYOR NO. 4785</p> | <p><b>AS BUILT CERTIFICATION</b></p> <p>I HEREBY CERTIFY THAT THE CIRCLED GRADES ARE EXISTING FINISH GRADES CHECKED IN THE FIELD ON _____ AND THAT SURVEY IS CORRECT TO THE BEST OF MY KNOWLEDGE AND BELIEF.</p> <p>REG. SURVEYOR NO. _____</p> | <p><b>COLPETZER - WOODS</b><br/>CONSULTANTS, INC.<br/>(216) 357-7569</p> | <p>DATE 3/13/79<br/>SCALE 1"=20'<br/>DRWN BY J.E.<br/>CHKD BY _____<br/>JOB NO. 78/156<br/>FB 332 Apg</p> | <p><b>SITE PLAN FOR</b><br/>EDWARD H. TRESGER INC.<br/>8100 DEEPWOOD BLVD. MENTOR<br/>OHIO. S/L#21 IN THE PINES<br/>SUBD. NO. 1. PAINESVILLE, OHIO</p> |
|--------------------------------------------------------------------------------------------------------------------------------------------------------------------------------------|-------------------------------------------------------------------------------------------------------------------------------------------------------------------------------------------------------------------------------------------------|--------------------------------------------------------------------------|-----------------------------------------------------------------------------------------------------------|--------------------------------------------------------------------------------------------------------------------------------------------------------|