

FOR

Planning Plan Approved
as shown and/or noted
THOMAS P. GILLES, P.E.
Lake County Engineer

Amount of work done 5/20/88
Amount of pump required

Ed. J. Pratt

DAVID K. MOSTOLLER R.S. #6949



- SANITARY MANHOLE
- STORM MANHOLE
- INLET OR CATCH BASIN
- ▲ HYDRANT

EXISTING CONTOUR
PROPOSED CONTOUR

EXIST. ELEV. - 100.0
100.0 PROP. ELEV

AS BUILT ELEVATION 1000.0

DIRECTION OF DRAINAGE

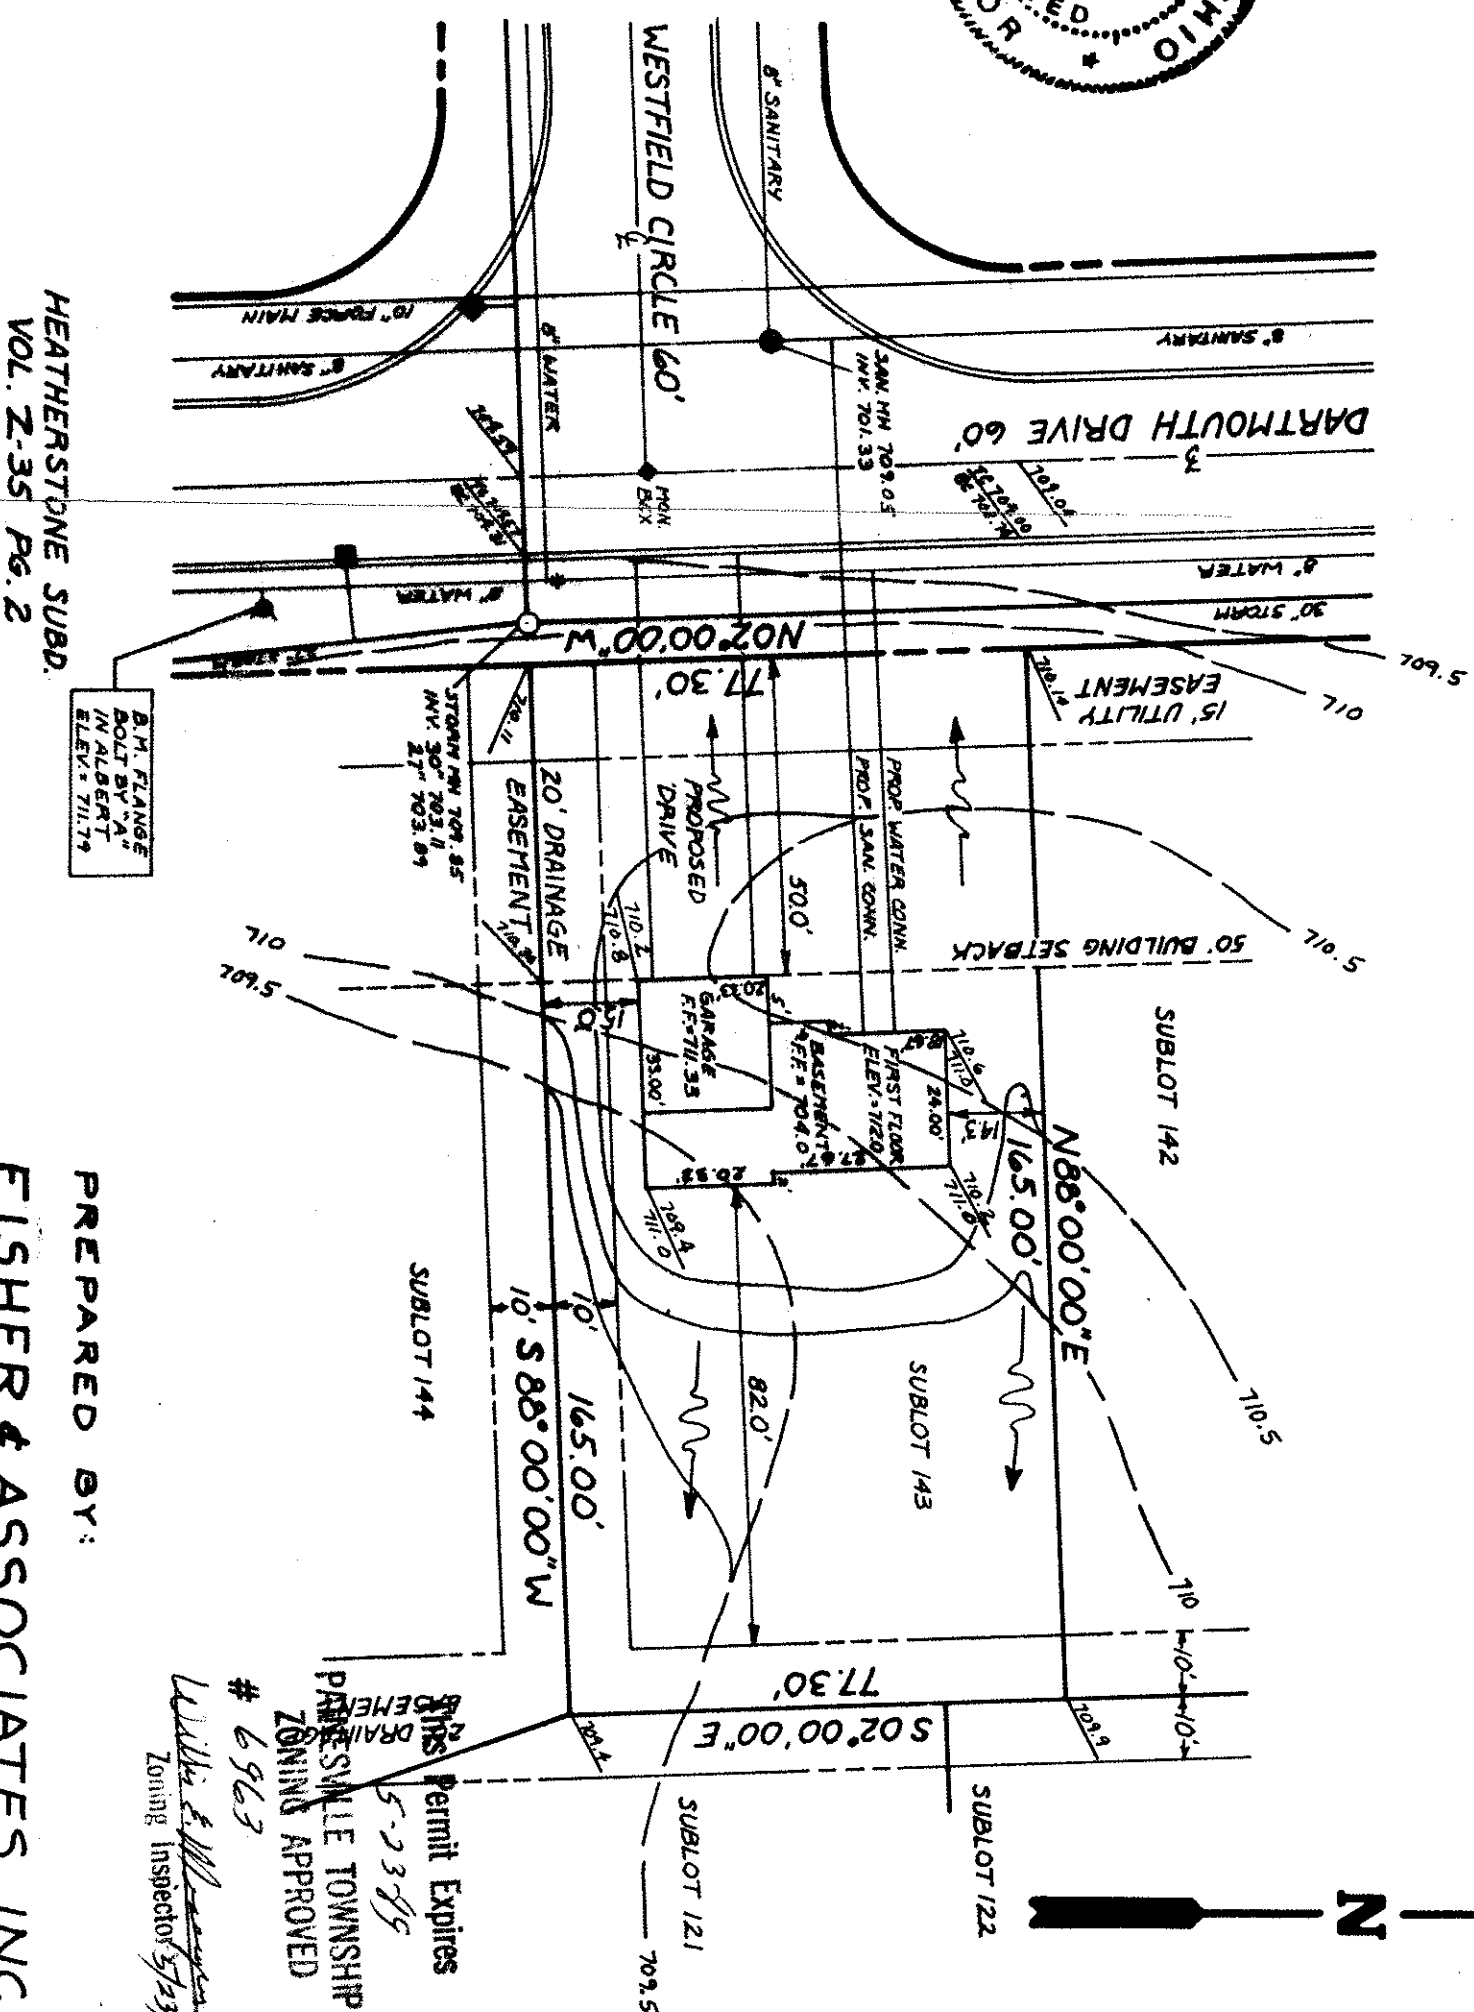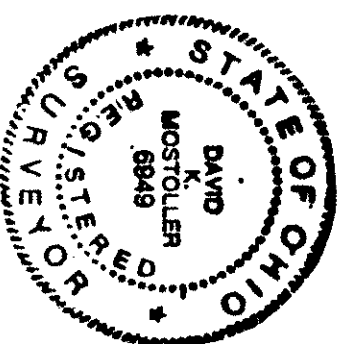

**FISHER & ASSOCIATES INC.
ENGINEERS AND CONSULTANTS**

SCALE: 1"=30'
DATE: MAY, 1988