


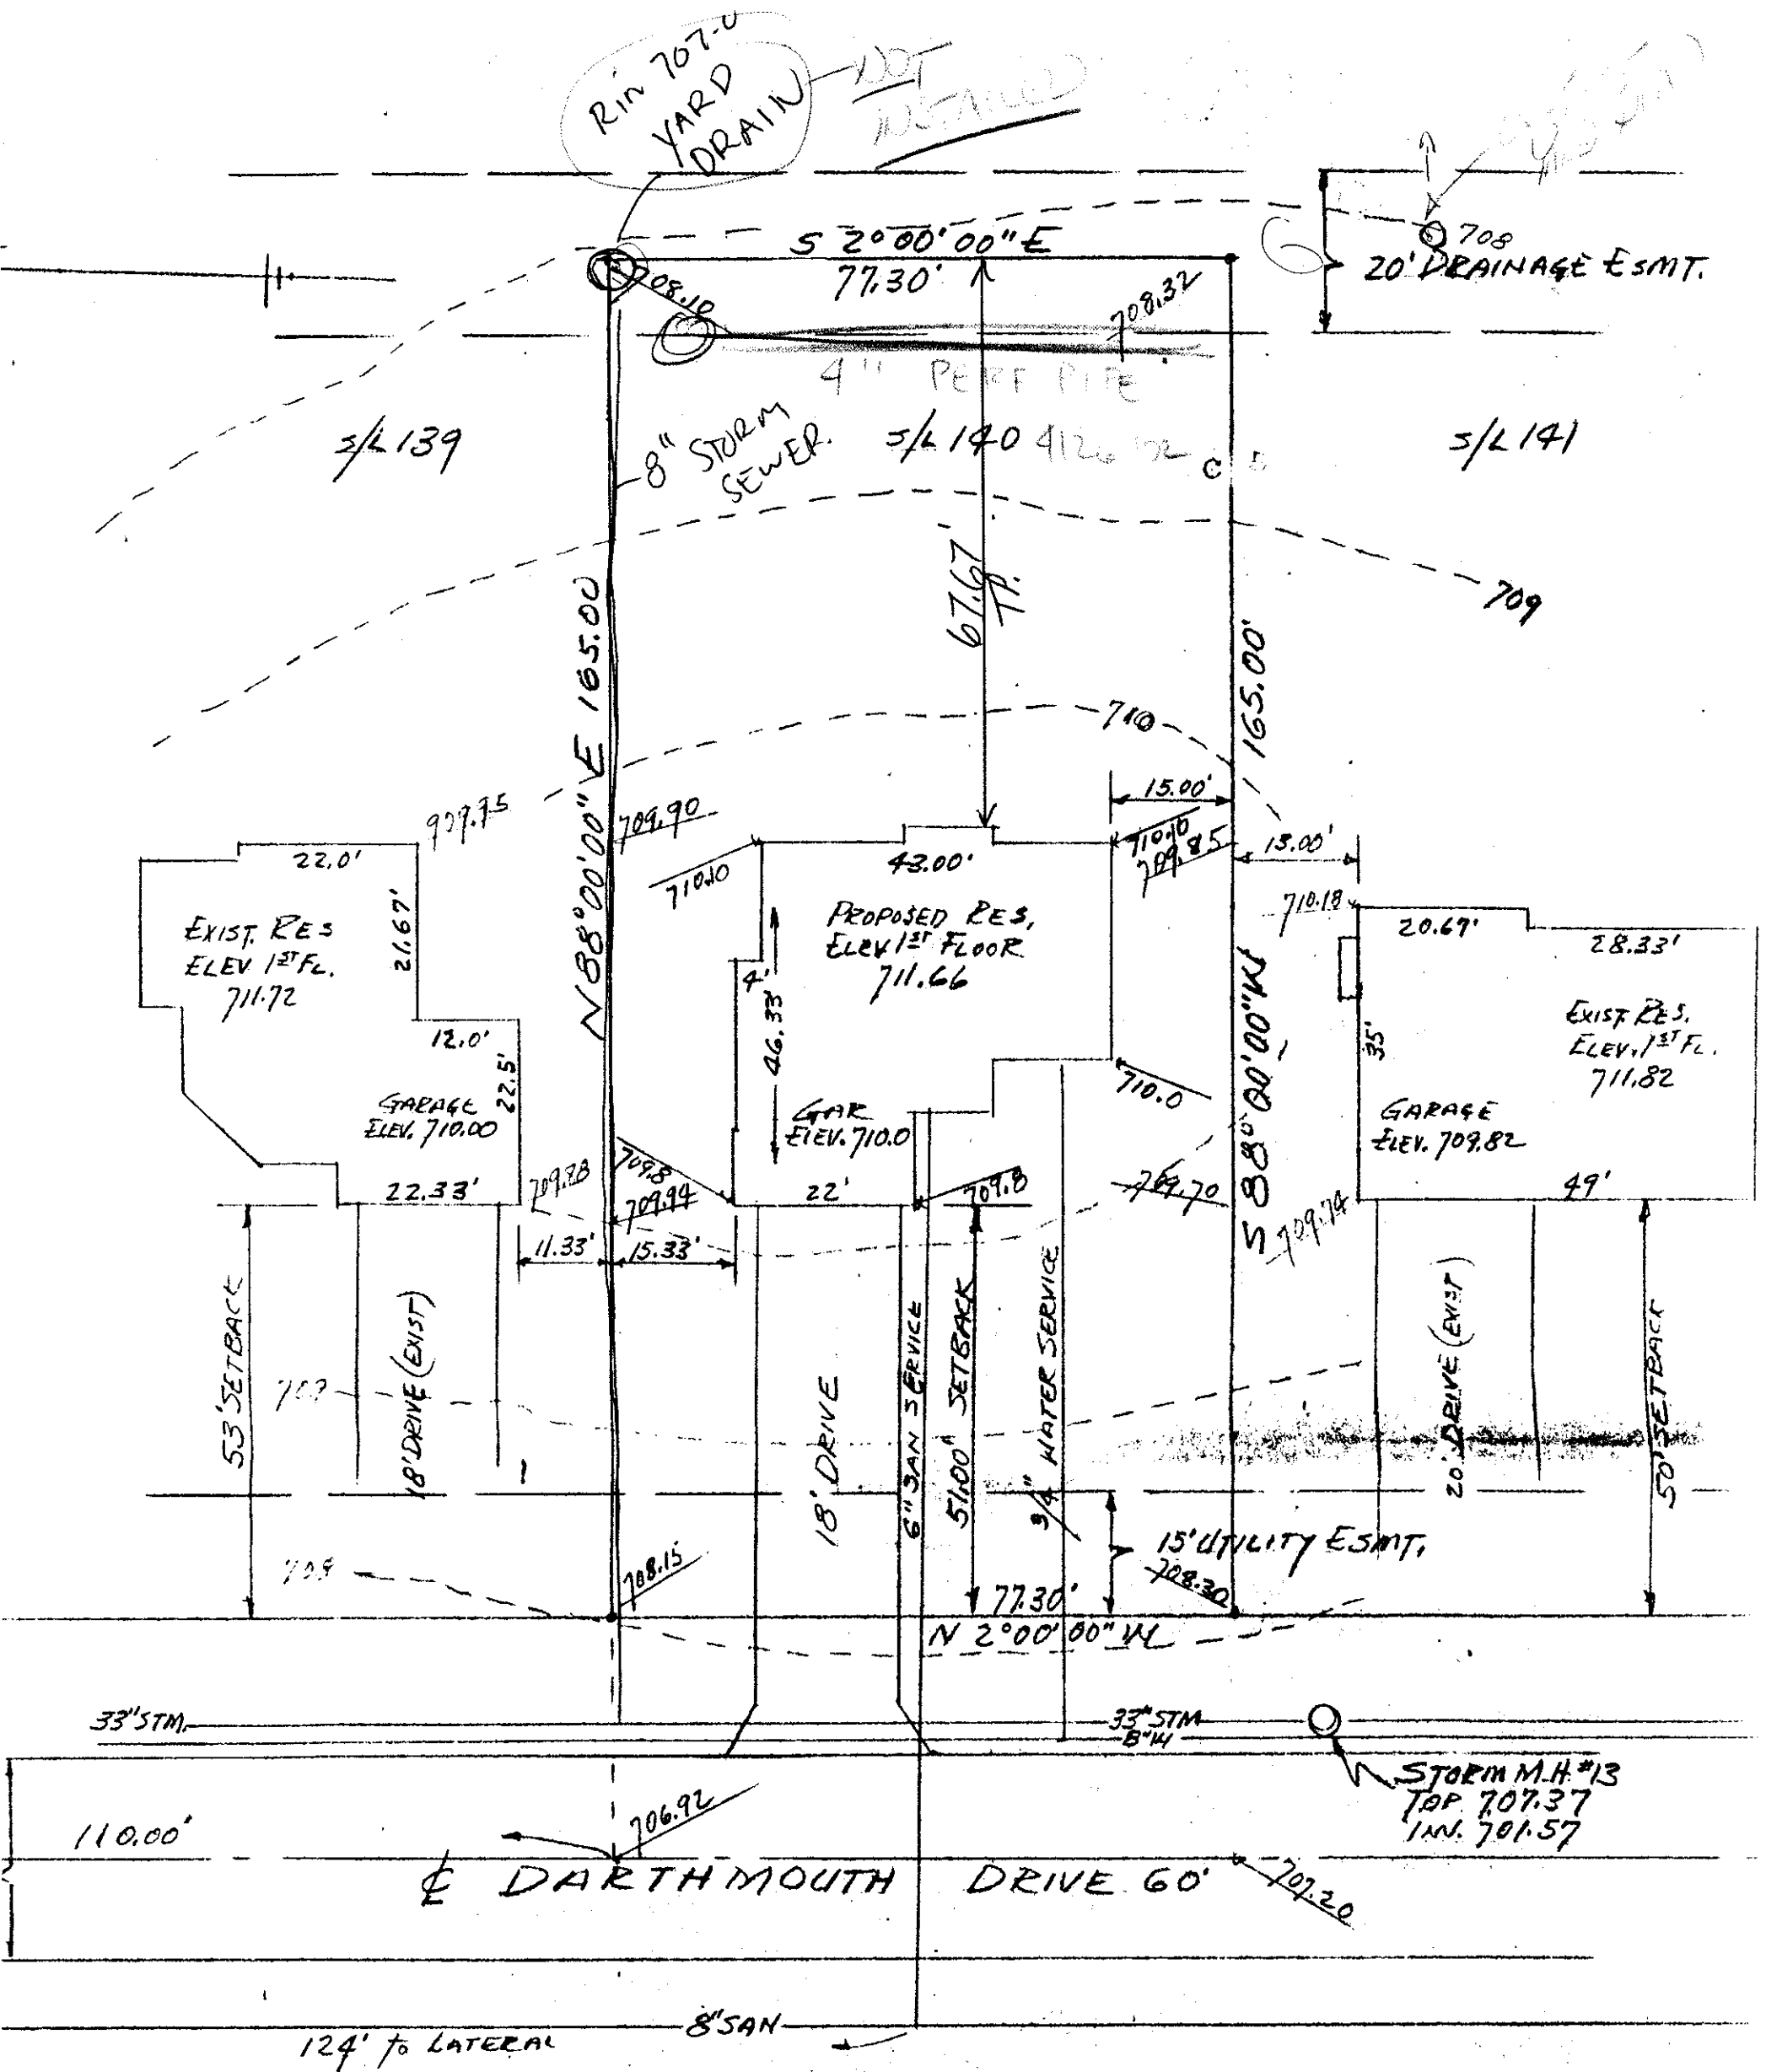

TOPOGRAPHIC
FOR P.E.
SUBLOT #140 HEATHE
PAINESVILLE TOW
SCALE 1"=20'

Pat
PAT SALLI

SAN M.H. #44
TOP 706.91
INV. 699.59

4/10/91

STORM SEWER
DRAIN AS