

NORTH

SITE PLAN

PAINESVILLE TOWNSHIP, LAKE COUNTY, OHIO

for: Don Bowling OWNER


ADDRESS _____ STREET _____ CITY _____ ZIP _____

LOT _____ TRACT _____
VOLUME _____ PAGE _____
PERM. PARCEL NO. _____ STREET _____

LEGEND
SANITARY MANHOLE (S) ---
STORM MANHOLE (SM) ---
INLET OR CATCH BASIN (CB) ---
HYDRANT (H) ---
EXISTING CONTOURS ---
PROPOSED CONTOURS ---
EXIST. ELEV. ---
PROP. ELEV. ---
WATER VALVE (GV) ---
WATER METER (GM) ---
AS BUILT ELEVATION ---
INDICATES DIRECTION OF SURFACE DRAINAGE

REMARKS
ALL BOUNDARY DATA SHOWN WAS OBTAINED FROM (DEEDS, RECORDED SUBDIVISION PLAT OR OTHER PUBLIC RECORDS)
LOCATIONS AS SHOWN OF ADJACENT WELLS AND SEPTIC TANKS OBTAINED FROM LAKE COUNTY HEALTH DEPARTMENT

DESIGN CERTIFICATION
THIS PLAT WAS PREPARED BY ME, AND IS CORRECT TO THE BEST OF MY KNOWLEDGE AND BELIEF.
NAME _____ SURVEYOR REGISTRATION NO. _____

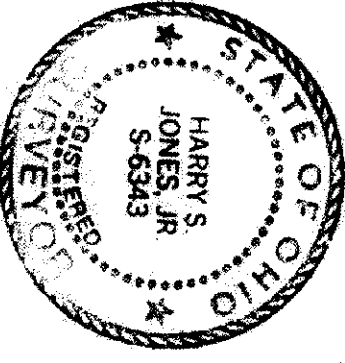

CHECK LIST
NO. OF BEDROOMS _____
DIMENSIONS _____
BEARINGS _____
TIE TO NEAREST STREET _____
SUBLOT NO. PARCEL NO. _____
SURROUNDING OWNERS _____
BLDG. DIMENSIONS FIN. GR. _____
BLDG. TIES PLT. GR. _____
PAV'T TYPE GRADE CURBS _____
ACTION TYPE WIDTH THICKNESS _____
SIDEWALK TYPE DIA. LENGTH _____
CULVERT TYPE DIA. LENGTH _____
ROCK OUTCROPPINGS _____
WATER MAIN SIZE, LOCATION _____
SAN. SEWER SIZE & GR. LOC. _____
SAN. MH. CAST. ELEV. INV. ELEV. _____
SAN. CONN. SIZE, LOC. DEPTH _____
STORM SEWER SIZE & GR. LOC. _____
STORM MH. CAST ELEV. INV. ELEV. _____
PAV'T TYPE GRADE CURBS _____
GAS LINE LOC. SIZE PRESSURE _____
SEPTIC TANK LOCATION & DUPLICATION AREA _____
WELL LOCATION _____
ISOLATION RADIUS FROM WELL _____

REVISIONS		PLAN PREPARED BY:	
NO.	DATE	BY	
1			
2			
3			
4			
5			
		DRAWN BY <u>12</u>	SCALE 1" = 20'
		CHECKED <u>HT</u>	DATE <u>8-27-90</u>
		CREW CHIEF <u>HT</u>	APP'D. <u>HT</u>
			PHONE NO. 357-1811
			DRAWING NO. 80-004-139

"AS BUILT" CERTIFICATION
I, HEREBY CERTIFY THAT THE CIRCLED GRADES ARE EXISTING FINISH GRADES CHECKED IN THE FIELD ON 19__
AND ARE CORRECT TO THE BEST OF MY KNOWLEDGE AND BELIEF.

REGISTERED SURVEYOR REG. NO. _____

TBM: SAN MH ELEV. = 707.09

Grading Plan Approved as shown and/or noted
THOMAS P. GILLES, P.E.
Lake County Engineer
By GJH Date 2/5/90
1. Connect Sump pump to CATCH BASIN.
This Permit Expires 8/24/91
ZONING APPROVED
#1603
Zoning Inspector

DARTMOUTH DRIVE - 60'

FANWOOD DRIVE - 60'

