
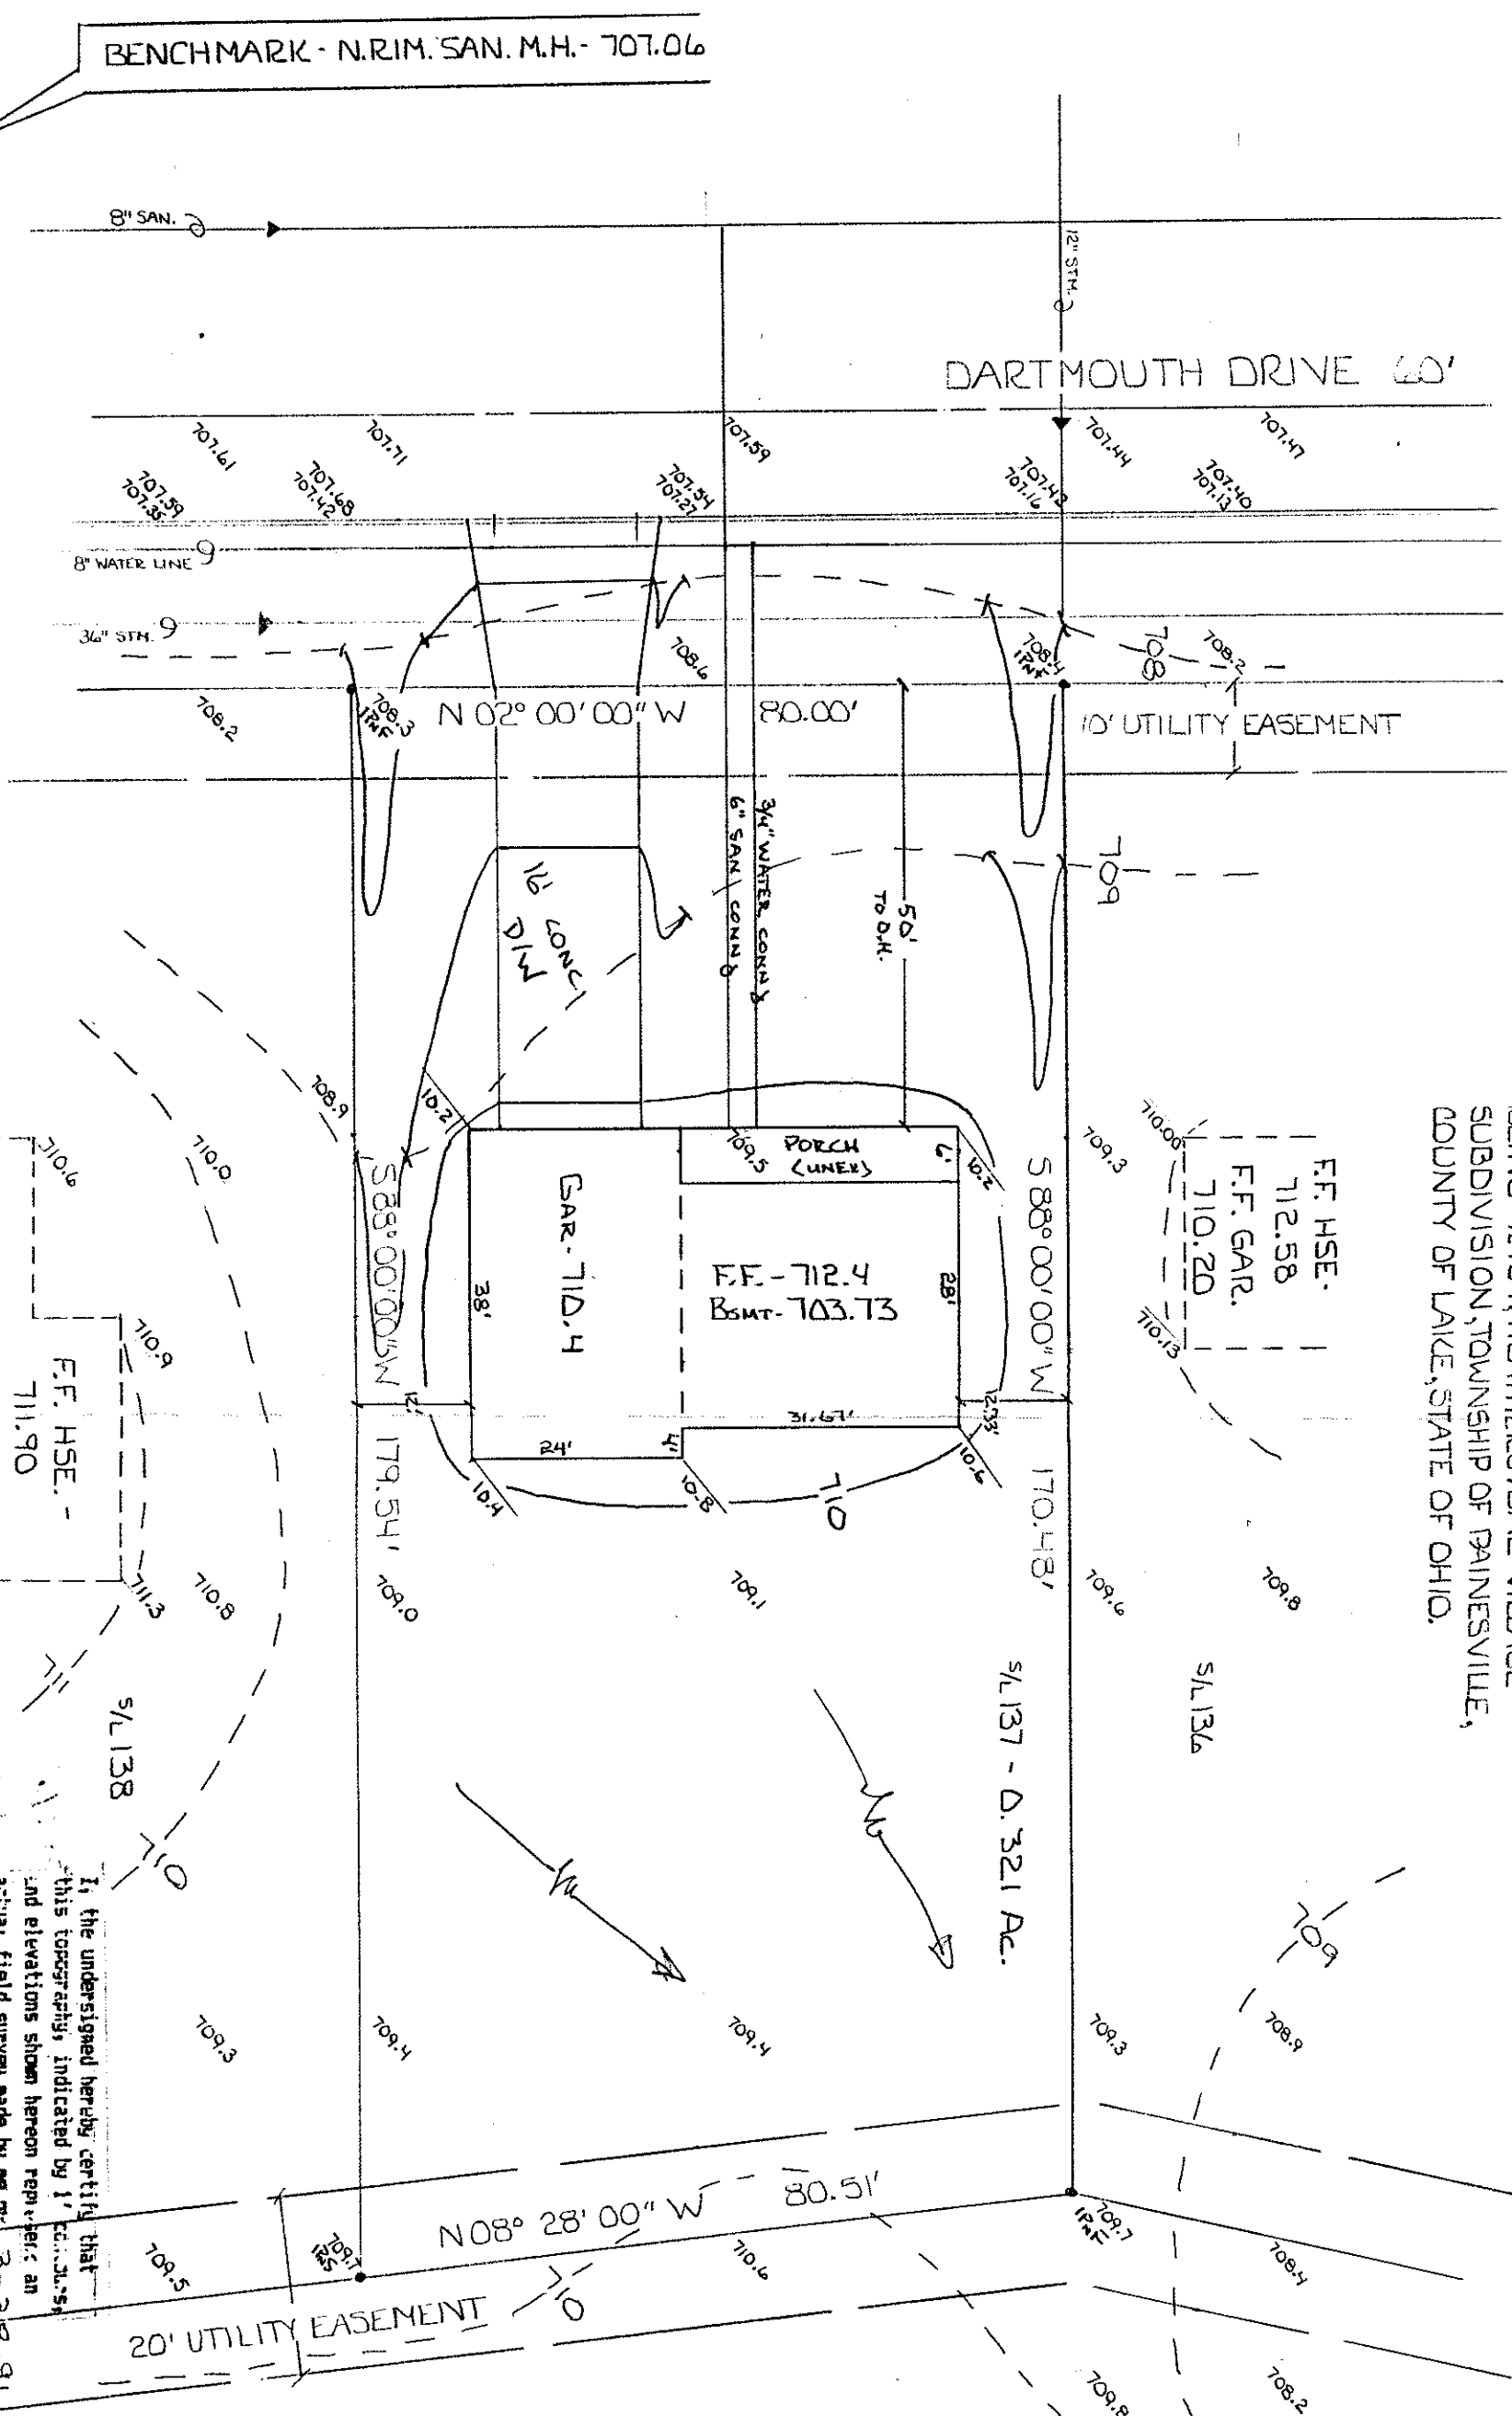


SITE PLAN

FOR

R.C. REED CONST.


BEING 1/4 137, HEATHERSTONE VILLAGE
SUBDIVISION, TOWNSHIP OF PAINESVILLE,
COUNTY OF LAKE, STATE OF OHIO.

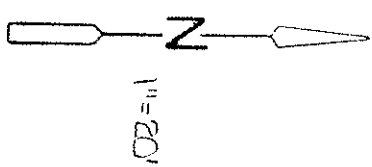

Grading Plan Approved
shown and/or noted
JAS P. GILL
County Engineer
By GJH Date 4/28/21
Discharge Sump pump
to 36\"/>

This Record Expires
4-23-42
#7762-17435
Zoning Inspector

I, the undersigned hereby certify that
this topography, indicated by 1\"/>

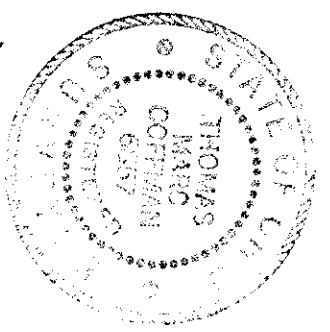

VILLAGE SURVEYING CO.
202 THIRD STREET, FAIRPORT HARBOR, OHIO 44077
(216) 357-1359