



SYMBOL LEGEND	
■	Monument Box W/ Pin
◆	Drill Hole Found
○	Manhole
⊙	Iron Pin Found
⊗	Water Shutoff Valve
☐	Telephone SAC Box
□	Catch Basin
□	Cable TV Box

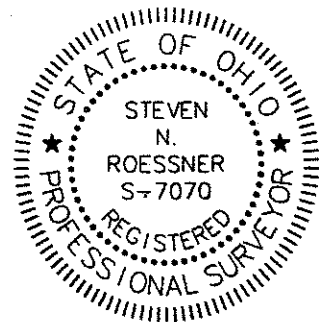


The topography, indicated by 1' contours, and elevations shown hereon represent an actual field survey made by me on February 26, 1996. The elevations were taken at appropriate intervals and as of the above date they existed as indicated hereon.

Steven N. Roessner 3/5/96
 Steven N. Roessner No. 7070
 Foresight Engineering Group, Inc.

BENCHMARK: Sanitary Manhole @ Intersection of Dartmouth Dr. & Radley Dr.
 Rim Elev. = 705.88.

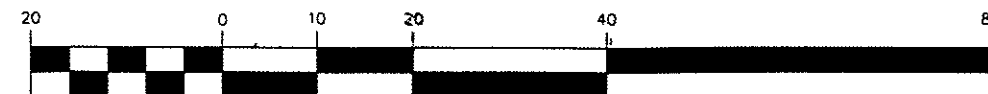

(IN FEET)
 1 inch = 20 ft.

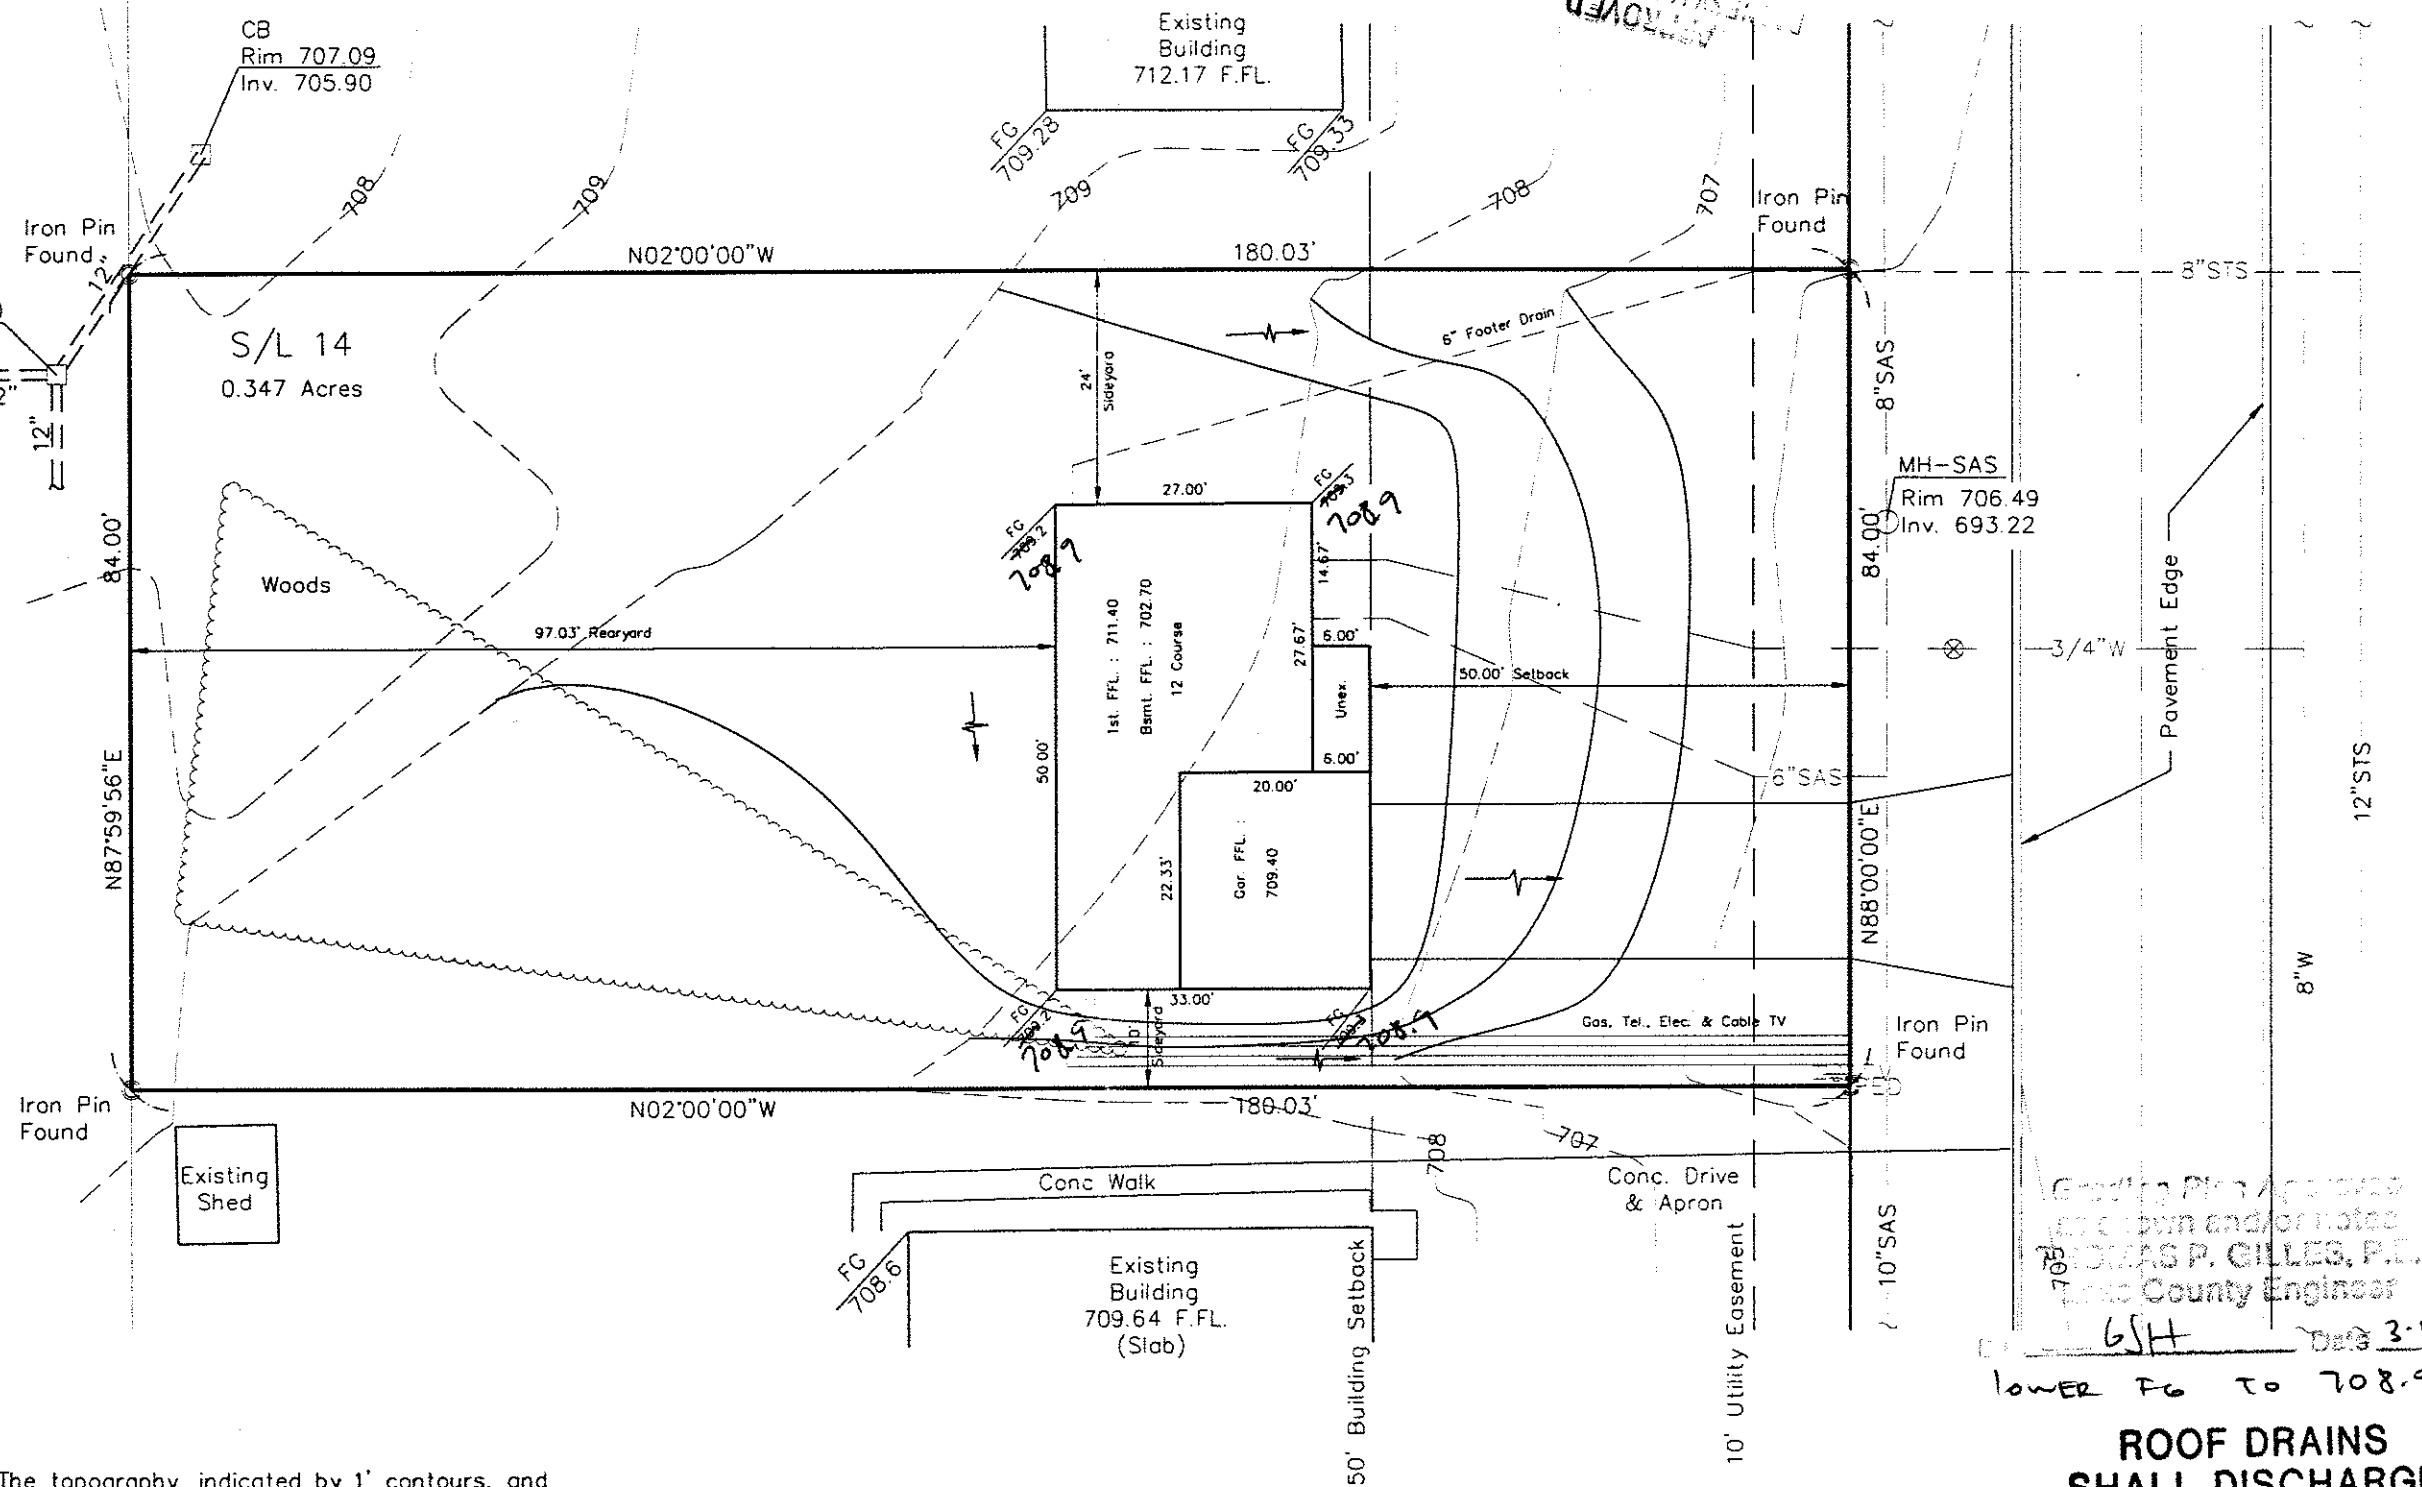

Grading Plan Approved
 by the Ohio State Engineer
 THOMAS P. GILLES, P.E.
 Lucas County Engineer
 Date 3-13-96

lower FG to 708.9
**ROOF DRAINS
 SHALL DISCHARGE
 TO SPLASH BLOCKS.**

REMOVED
 ZONING DEPARTMENT
 PAINESVILLE TOWNSHIP
 476-03-96

Dartmouth Drive - 60'

Foresight Engineering Group
 Engineers & Surveyors

SCALE: Horiz. 1"=20' Vert. NONE
 FILE NAME: C:\DEC1996\7070\SL-14
 DATE: March 2, 1996

Heatherstone Village Subdivision No. 2
 Phase No. 2 - S/L 14
 Painesville Twp. - Lake County - Ohio
 Site Plan - Decco Homes

SHEET NO.
 1/1