


This Permit Expires
NOV 23 1983
PAINESVILLE TOWNSHIP
ZONING APPROVED
5647
R. W. Hurler
Zoning Inspector 11/23/82

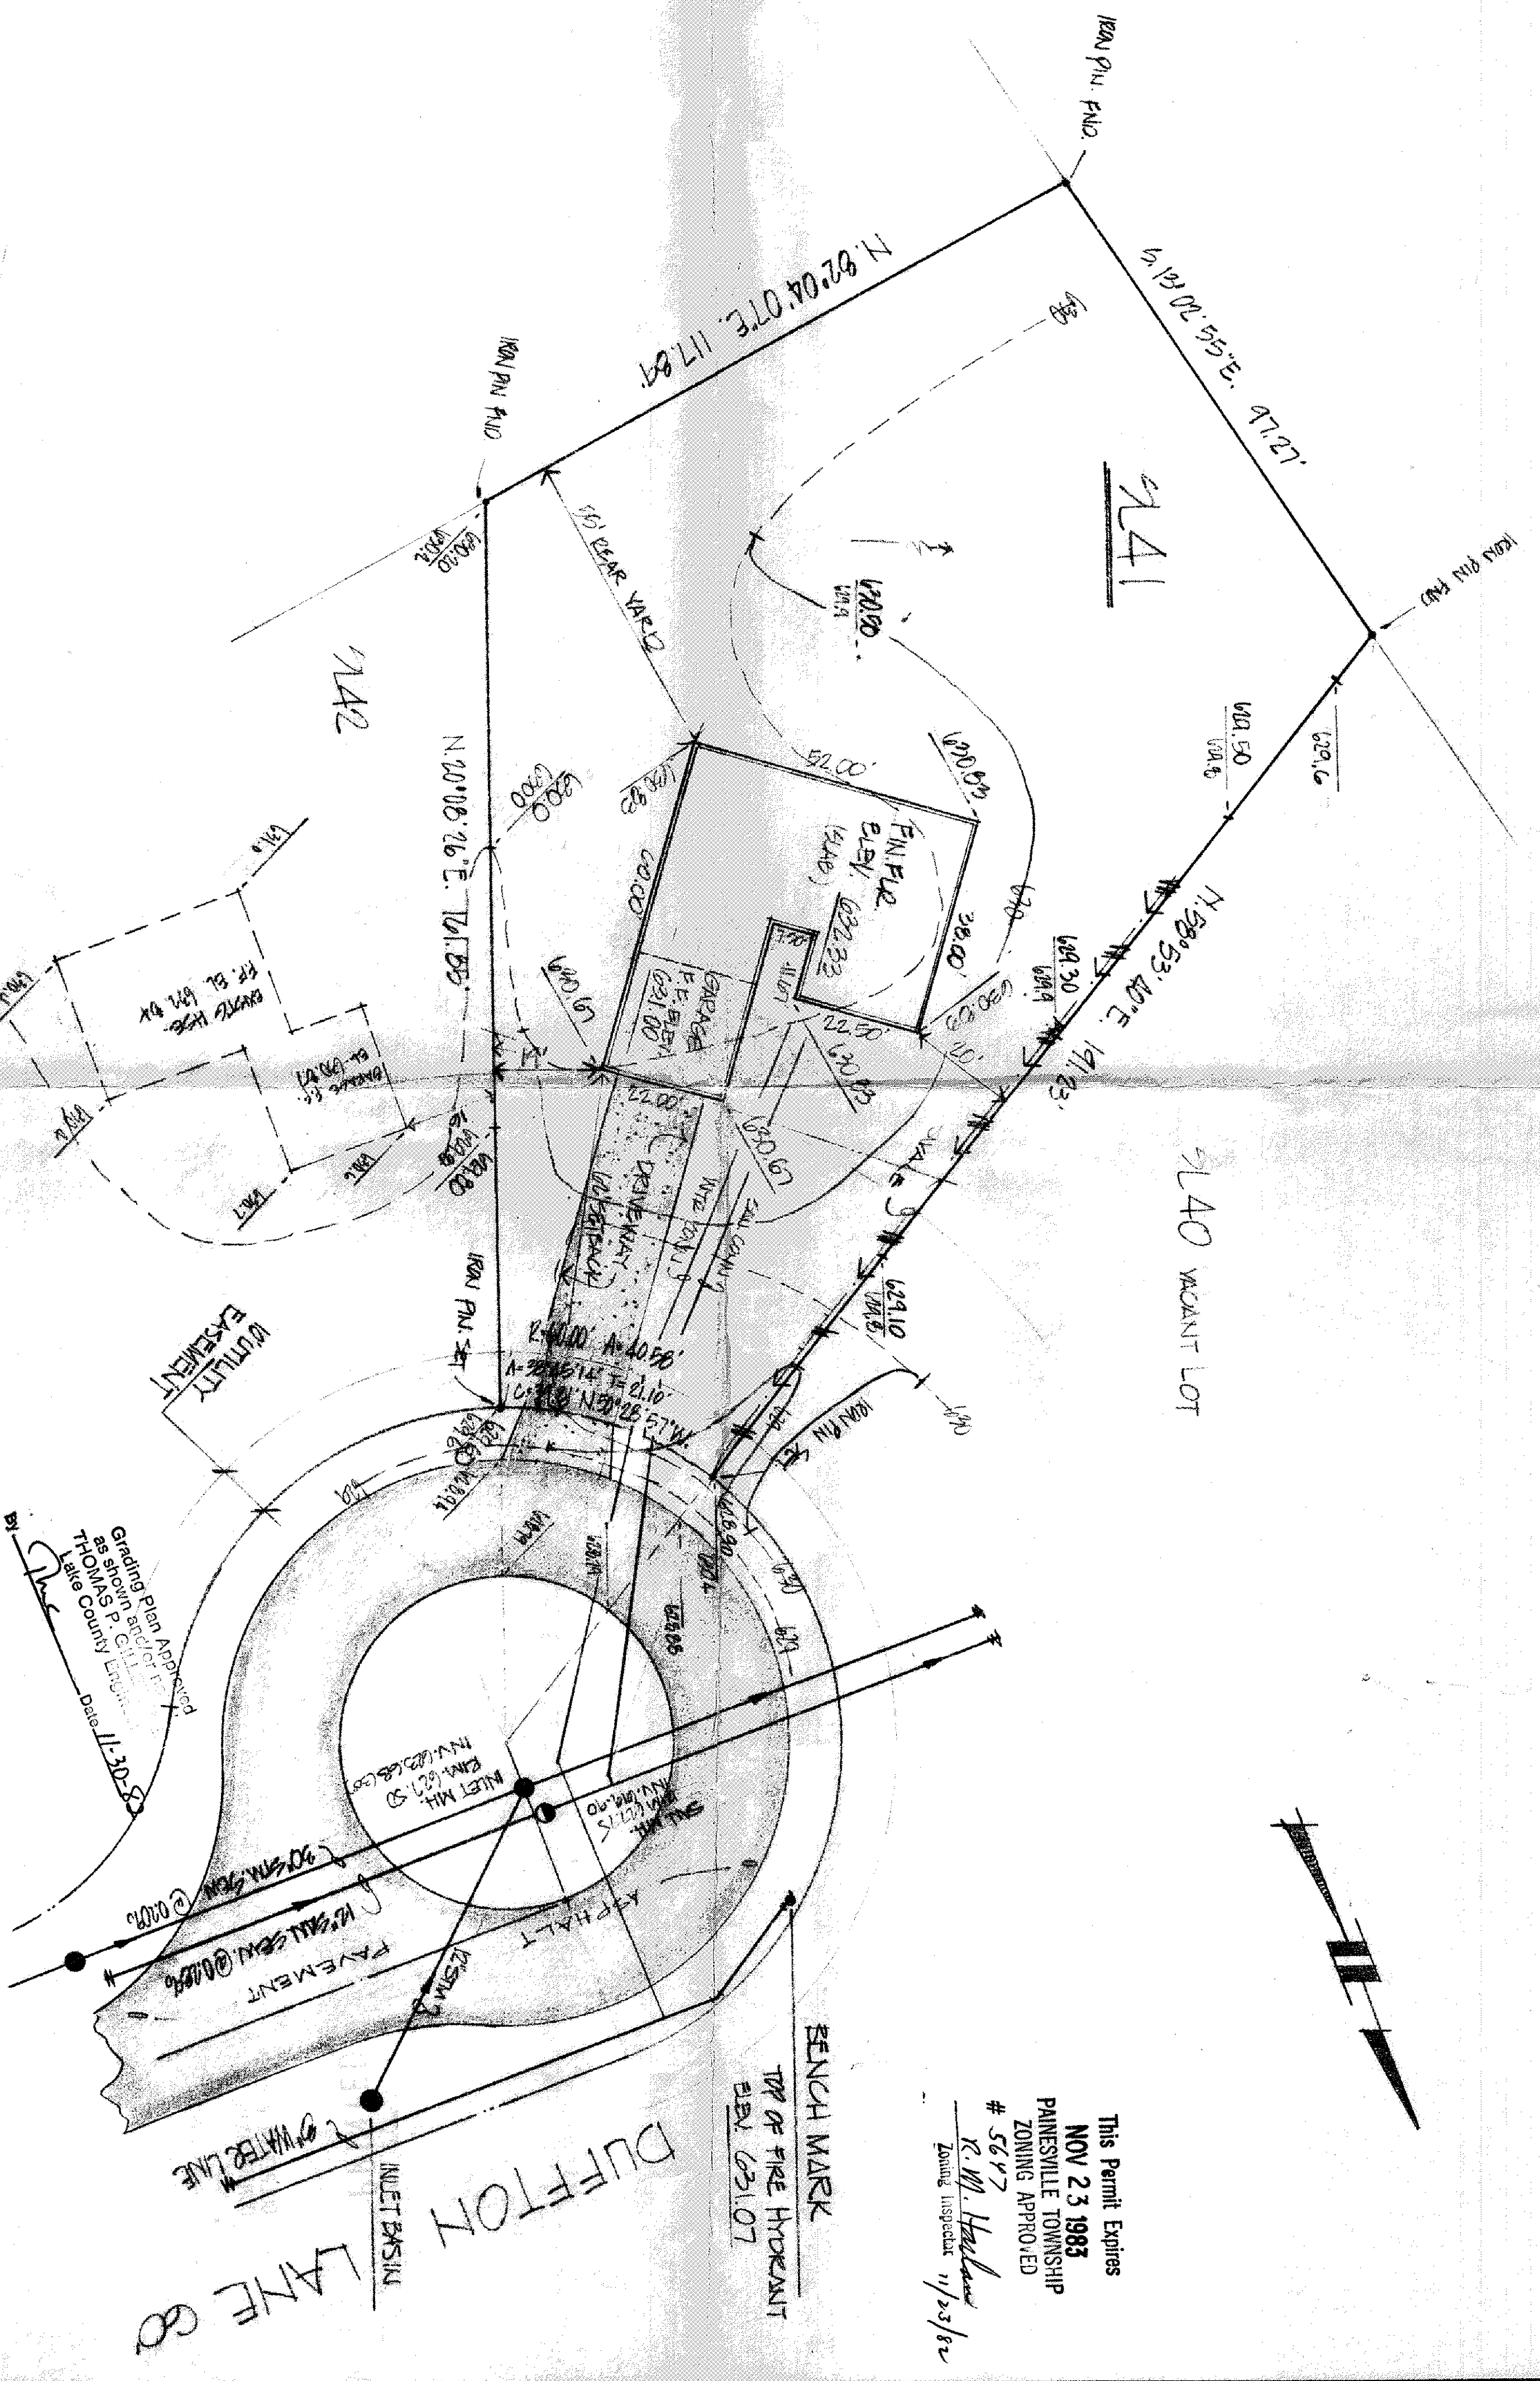

DESIGN CERTIFICATION
THIS PLAN WAS PREPARED BY ME AND IS CORRECT TO THE BEST OF MY KNOWLEDGE AND BELIEF.
Edin J. Jelinec
REG. SURVEYOR NO. 12295

AS BUILT CERTIFICATION
I HEREBY CERTIFY THAT THE CIRCLED GRADES ARE EXISTING FINISH GRADES CHECKED IN THE FIELD. ON THE BASIS OF THE SURVEY, THE GRADES ARE CORRECT TO THE BEST OF MY KNOWLEDGE AND BELIEF.
REG. SURVEYOR NO. 12295

SITE PLAN FOR EDWARD H. TRESCHER, INC.
8100 DEERWOOD BLVD., MENTOR, OHIO
PAINESVILLE TOWNSHIP NO. 2 IN PAINESVILLE TOWNSHIP, OHIO

COLPETZER & WOODS CONSULTANTS, INC.
MENTOR, OHIO 44060

DATE: 11/17/82
SCALE: 1"=20'
DRAWN BY: *JB*
CHECKED BY: *JB*
P.E. 3015, P.E. 3016

SHEET 1 OF 1