

SITE PLAN

PAINEVILLE COUNTY, OHIO

for: **HELIPTAGE HOMES**

CLIENT: **HELIPTAGE HOMES**
ADDRESS: **MAIN STREET** CITY: **Hudson** ZIP: **43034**

THE **PLAT** SUBD. NAME: **PLAT**
SUBDIVISION: **V-27** VOL. **NO.** **1000** SHEET **38**
SUBLOT NO. **1000** STREET **MAIN STREET**

LOT **1000** TRACT **1000**
VOLUME **1000** PAGE **1000**
PERMIT TANGENT NO. **1000** STREET **1000**

LEGEND

SANITARY MANHOLE **1000** WATER VALVE (GAS) **1000**
STORM MANHOLE **1000** WATER METER (GAS) **1000**
INLET OR CATCH BASIN **1000** AS BUILT ELEVATION **1000**
HYDRANT **1000** EXISTING CONTOURS **1000**
PROPOSED CONTOURS **1000** INDICATES DIRECTION OF SURFACE DRAINAGE **1000**
EXIST. ELEV. **1000** PROP. ELEV. **1000**

REMARKS

ALL BOUNDARY DATA SHOWN WAS OBTAINED FROM IDEEDS, RECORDED SUBDIVISION PLAT OR OTHER PUBLIC RECORDS
LOCATIONS AS SHOWN OF ADJACENT WELLS AND SEPTIC TANKS OBTAINED FROM LAKE COUNTY HEALTH DEPARTMENT

DESIGN CERTIFICATION

THIS PLAT WAS PREPARED BY ME, AND IS CORRECT TO THE BEST OF MY KNOWLEDGE AND BELIEF.

NAME **PAINEVILLE** SURVEYOR REGISTRATION NO. **1000**

CHECK LIST

NO. OF BEDROOMS **1000**
DIMENSIONS **1000**
SEAN. SEWER SIZE % GR. LOC. **1000**
SEAN. MH. CAST. ELEV. INV. ELEV. **1000**
SAN. CONN. SIZE, LOC. DEPTH **1000**
STORM SEWER SIZE % GR. LOC. **1000**
STORM MH. CAST. ELEV. INV. ELEV. **1000**
BLDG. TYPE, GRADE CURBS **1000**
PAVT TYPE, GRADE CURBS **1000**
GAS LINE LOC. SIZE, PRESSURE **1000**
SEPTIC TANK LOCATION & DUPLICATION AREA **1000**
WELL LOCATION **1000**
ISOLATION RADIUS FROM WELL **1000**
ROCK OUTCROPPINGS **1000**

PLAN PREPARED BY: **BABCOCK • JONES & ASSOCIATES, INC.**

PAINEVILLE, OHIO

NO.	DATE	BY
1		
2		
3		
4		
5		

"AS BUILT" CERTIFICATION

I, HEREBY CERTIFY THAT THE CIRCLED GRADES ARE EXISTING FINISH GRADES CHECKED IN THE FIELD ON **19** AND ARE CORRECT TO THE BEST OF MY KNOWLEDGE AND BELIEF.


REGISTERED SURVEYOR REG. NO. **1000**

TBM - 1000 SMALL M.H.,
ELEV. 627.75

This Permit Expires

AUG 8 1984
PAINEVILLE TOWNSHIP
ZONING AUTHORITY

5783
R. M. Healy
8/8/83

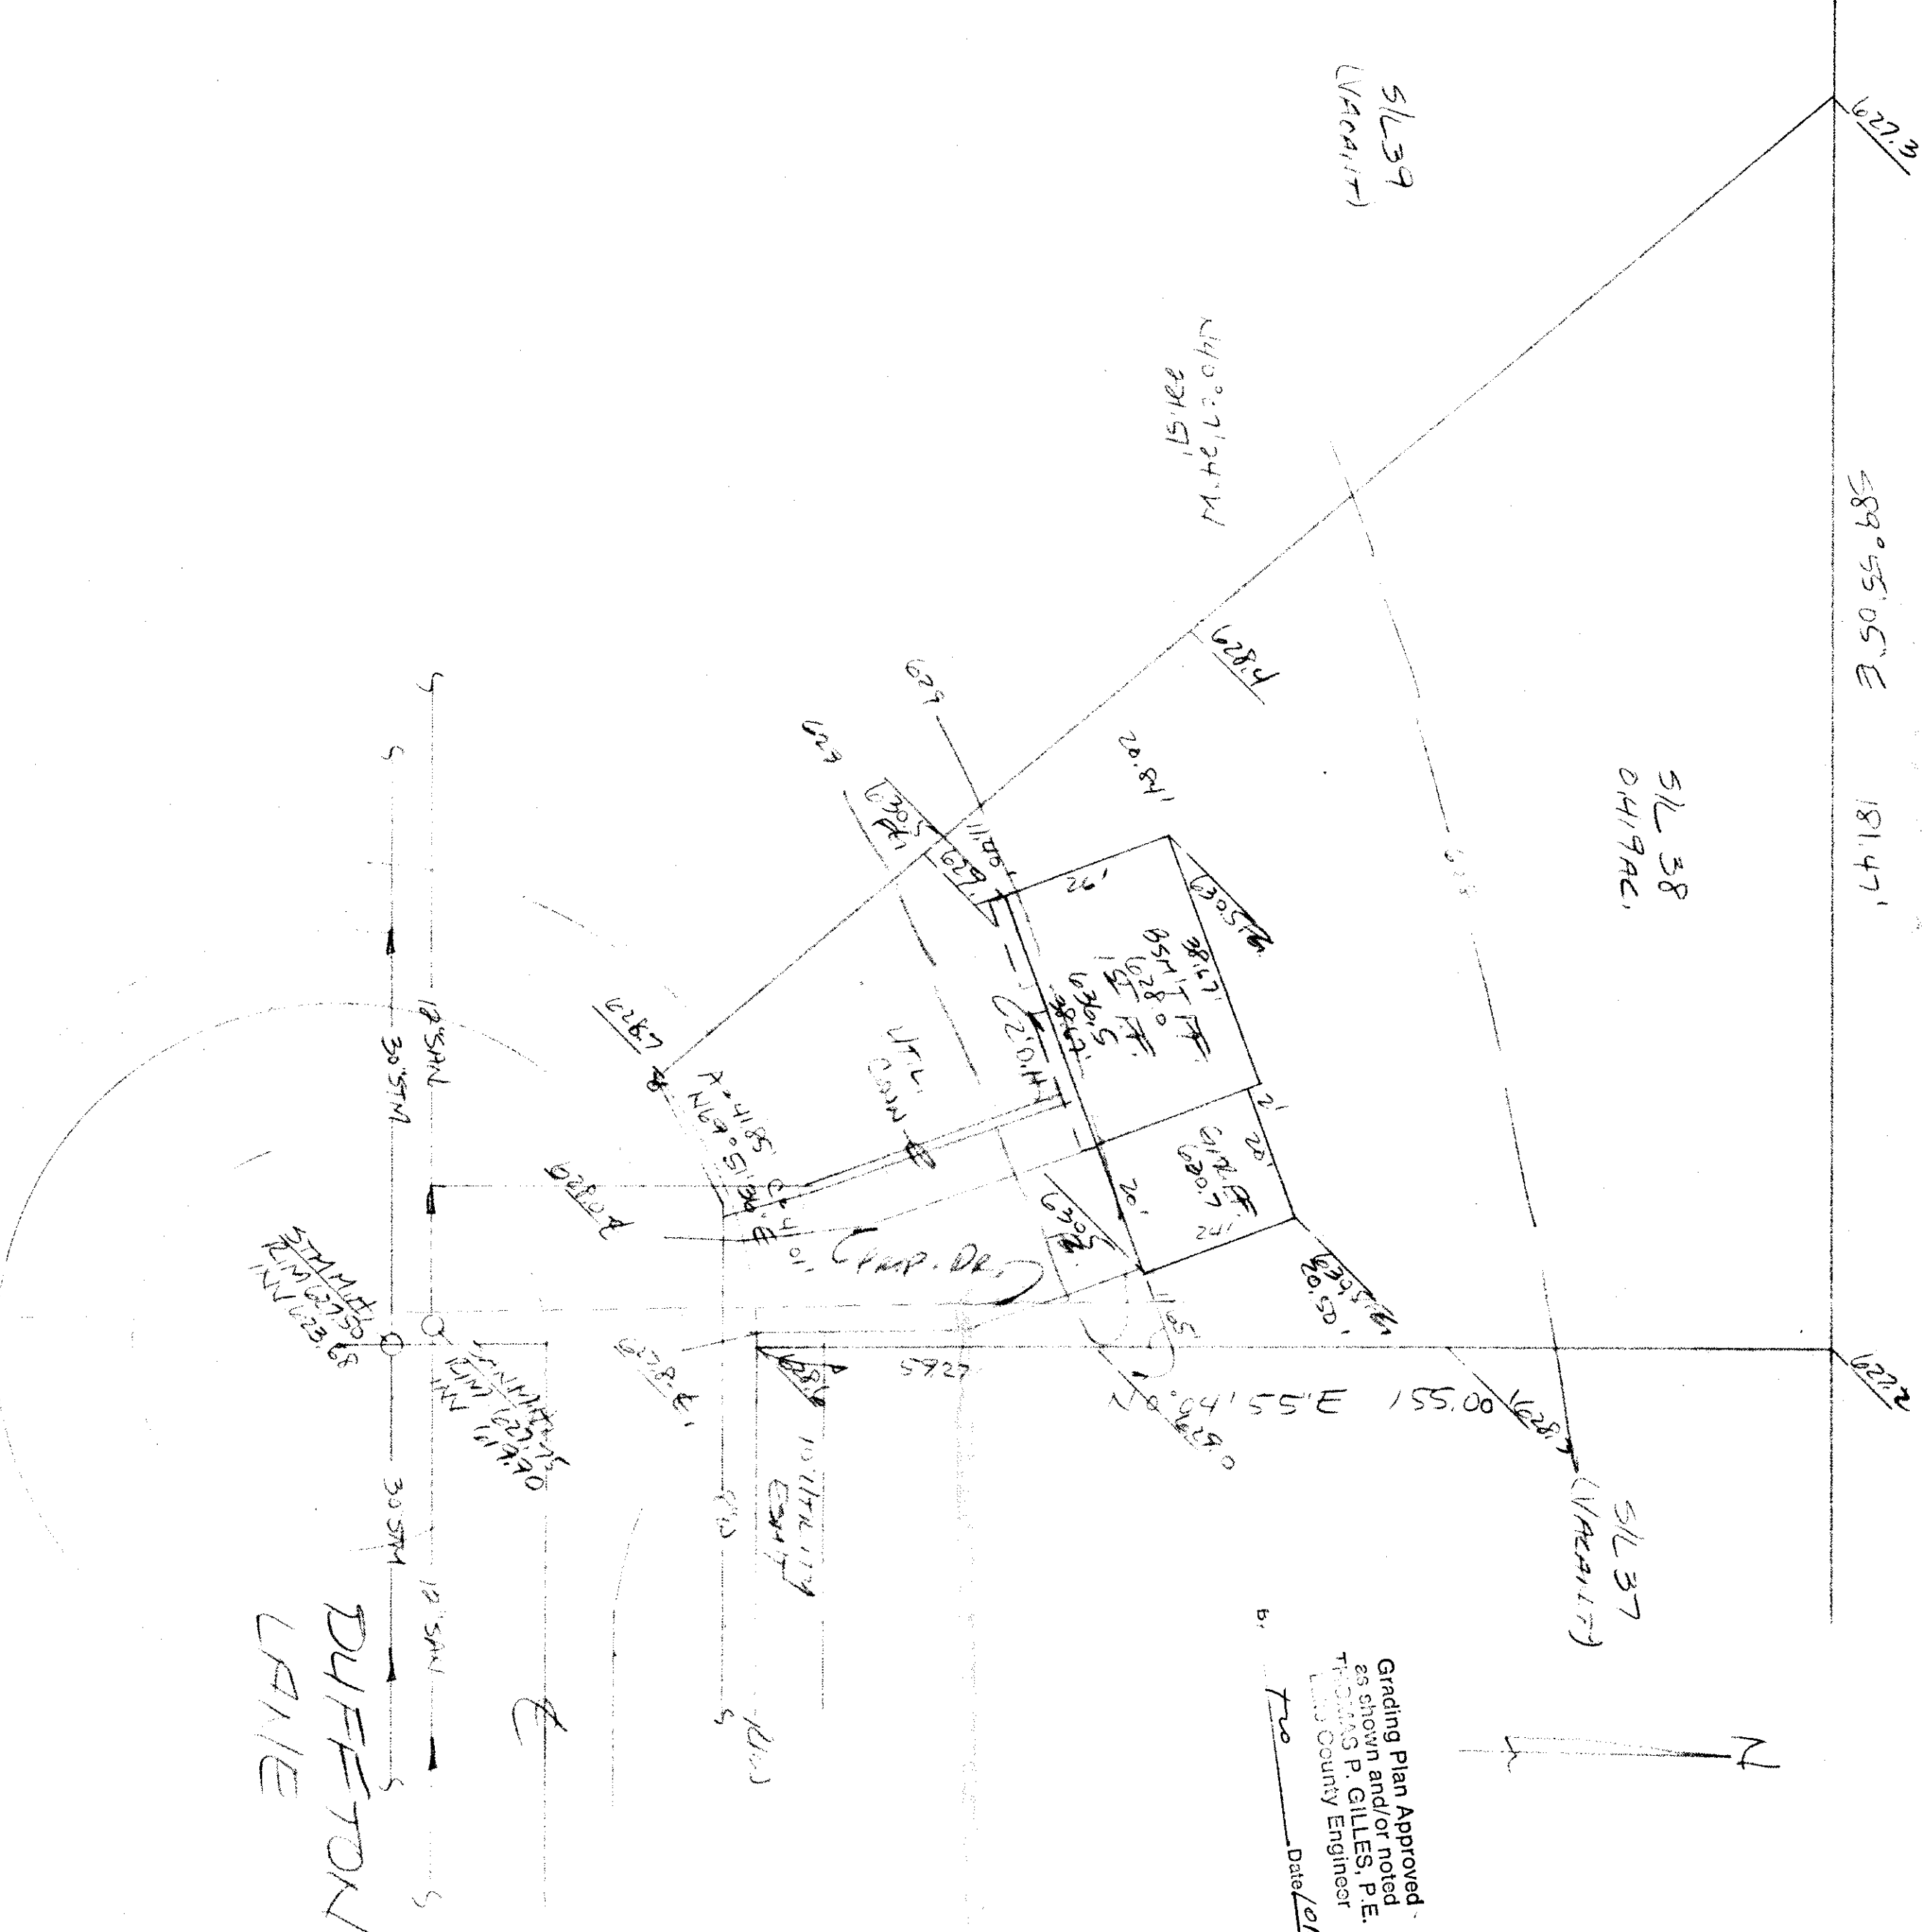

S/L 39
(VACUITY)

S/L 38
0.419 AC.

S/L 37
(VACUITY)