


DESIGN CERTIFICATION
 THIS PLAT WAS PREPARED BY ME, AND IS CORRECT TO THE BEST OF MY KNOWLEDGE AND BELIEF.
 REG. SURVEYOR NO. 5244

AS BUILT CERTIFICATION
 I HEREBY CERTIFY THAT THE CIRCLED GRADES ARE EXISTING FINISH GRADES CHECKED IN THE FIELD ON _____ AND THAT SURVEY IS CORRECT TO THE BEST OF MY KNOWLEDGE AND BELIEF.
 REG. SURVEYOR NO. _____

COLPETZER • WOODS
 CONSULTANTS, INC.
 9470 MENTOR AVENUE • MENTOR, OHIO 44060 • (216) 357-7569

DATE: AUG 3, 1987
 SCALE: 1"=20'
 DRAWN BY: CB.
 CHECKED BY: _____
 JOB NO.: 8-156-044
 FB 332 PG. 144

SITE PLAN FOR:
EDWARD H. TRESSGER, INC.
 8100 DEEPWOOD BLVD. MENTOR, OHIO.
 BEING SUBLOT NO. 44 IN THE PINES SUBDIVISION NO. 2 PAINESVILLE TOWNSHIP, OHIO.

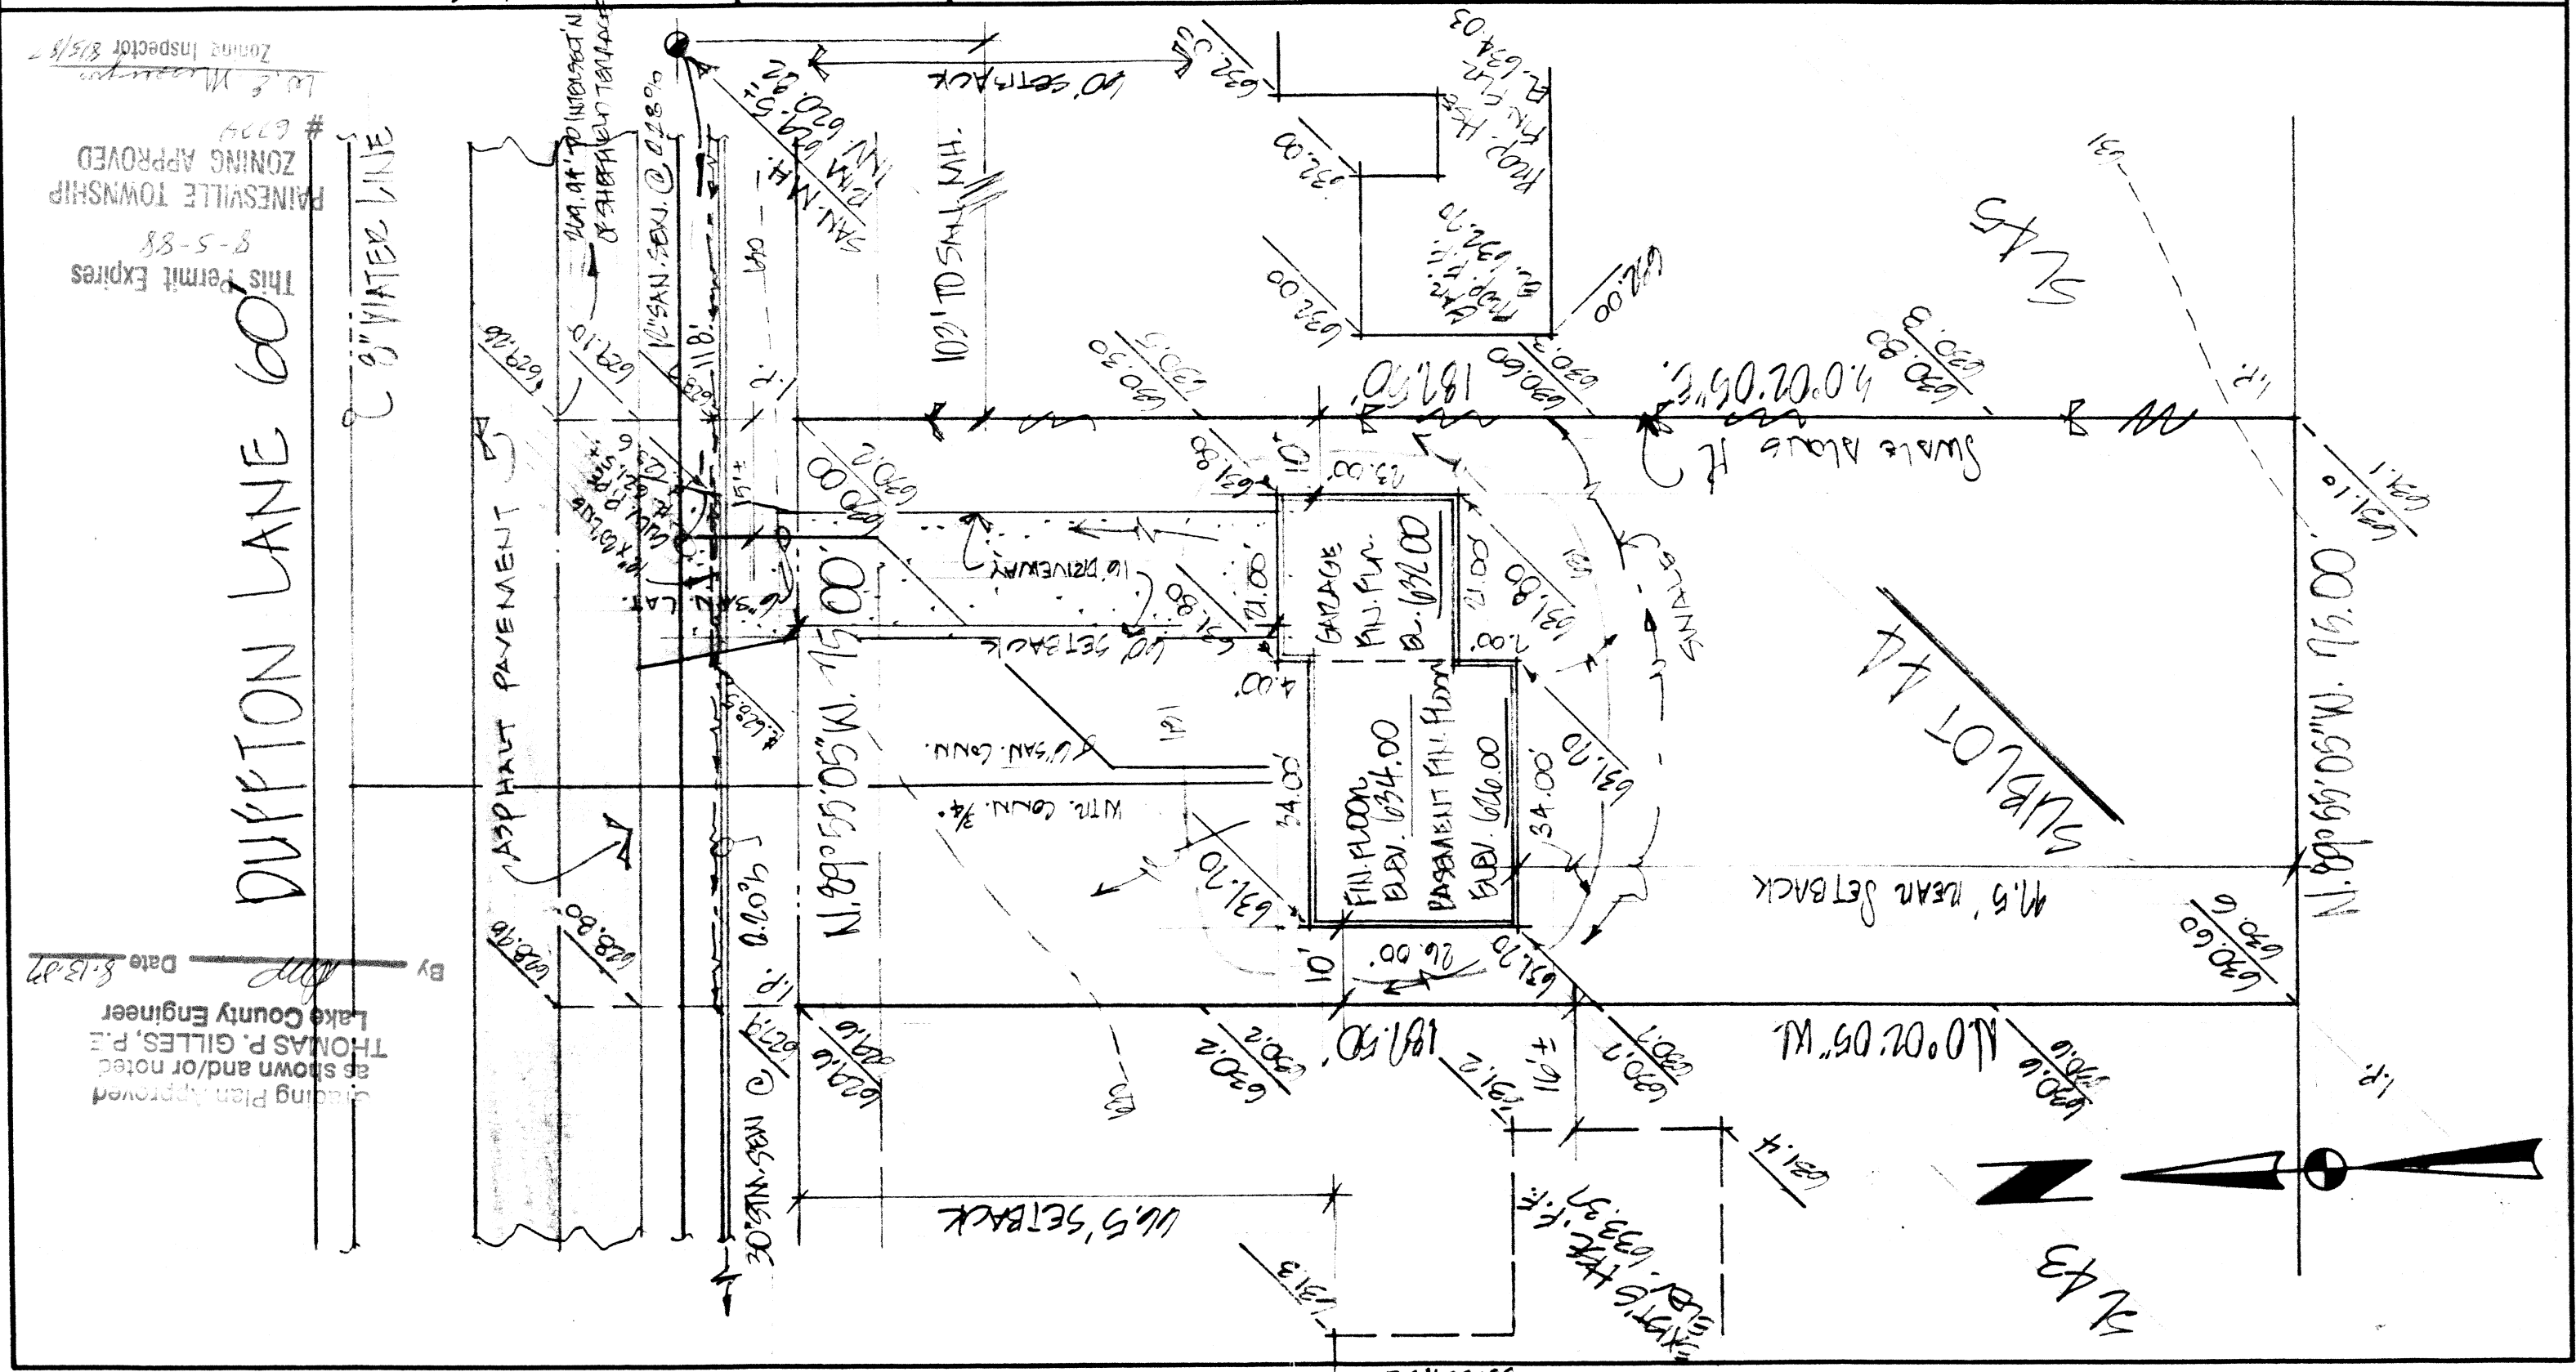

This Permit Expires 8-5-88
 PAINESVILLE TOWNSHIP
 ZONING APPROVED
 # 6774
 W.E. McNamee
 Zoning Inspector 8/5/87

By _____
 Lake County Engineer
 THOMAS P. GILLES, P.E.
 as shown and/or noted
 on existing Plan Approved
 Date 8-13-87