


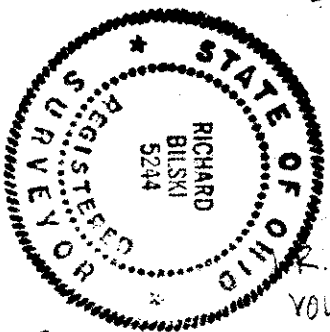

R.C. FIBERS
VOL. 709 PG. 442

LEACH MARK:
TOP OF FIBER HYDRAULIC
INTERSECTION OF DUFFTON LANE
AND SHEFFIELD BLVD. 632.34

DESIGN CERTIFICATION

THIS PLAN WAS PREPARED BY ME
AND IS CORRECT TO THE BEST OF
MY KNOWLEDGE AND BELIEF.

REG. SURVEYOR NO.

5244

AS BUILT CERTIFICATION

I HEREBY CERTIFY THAT THE CIRCLED GRADES
ARE EXISTING FINISH GRADES CHECKED IN THE
FIELD ON _____ AND THAT
SURVEY IS CORRECT TO THE BEST OF MY
KNOWLEDGE AND BELIEF.

REG. SURVEYOR NO.



COLPETZER-THOMAS, INC.
AN ENGINEERING GROUP

WILLOUGHBY • MENTOR • NORTH CANTON • STEUBENVILLE • LORAIN

DATE 4/18/88

SCALE 1"=25'

DRAWN BY CB

CHKD BY


JOB NO 78-156-34

FB 332-A PG ALL

SITE PLAN FOR:

EDWARD H. TRESSELER, INC.

8100 DEERWOOD BLVD., MENTOR, OHIO.
BEING SUBLOT NO. 34 IN THE DUES SUBDIVISION NO. 2
IN PAINESVILLE TOWNSHIP, OHIO.

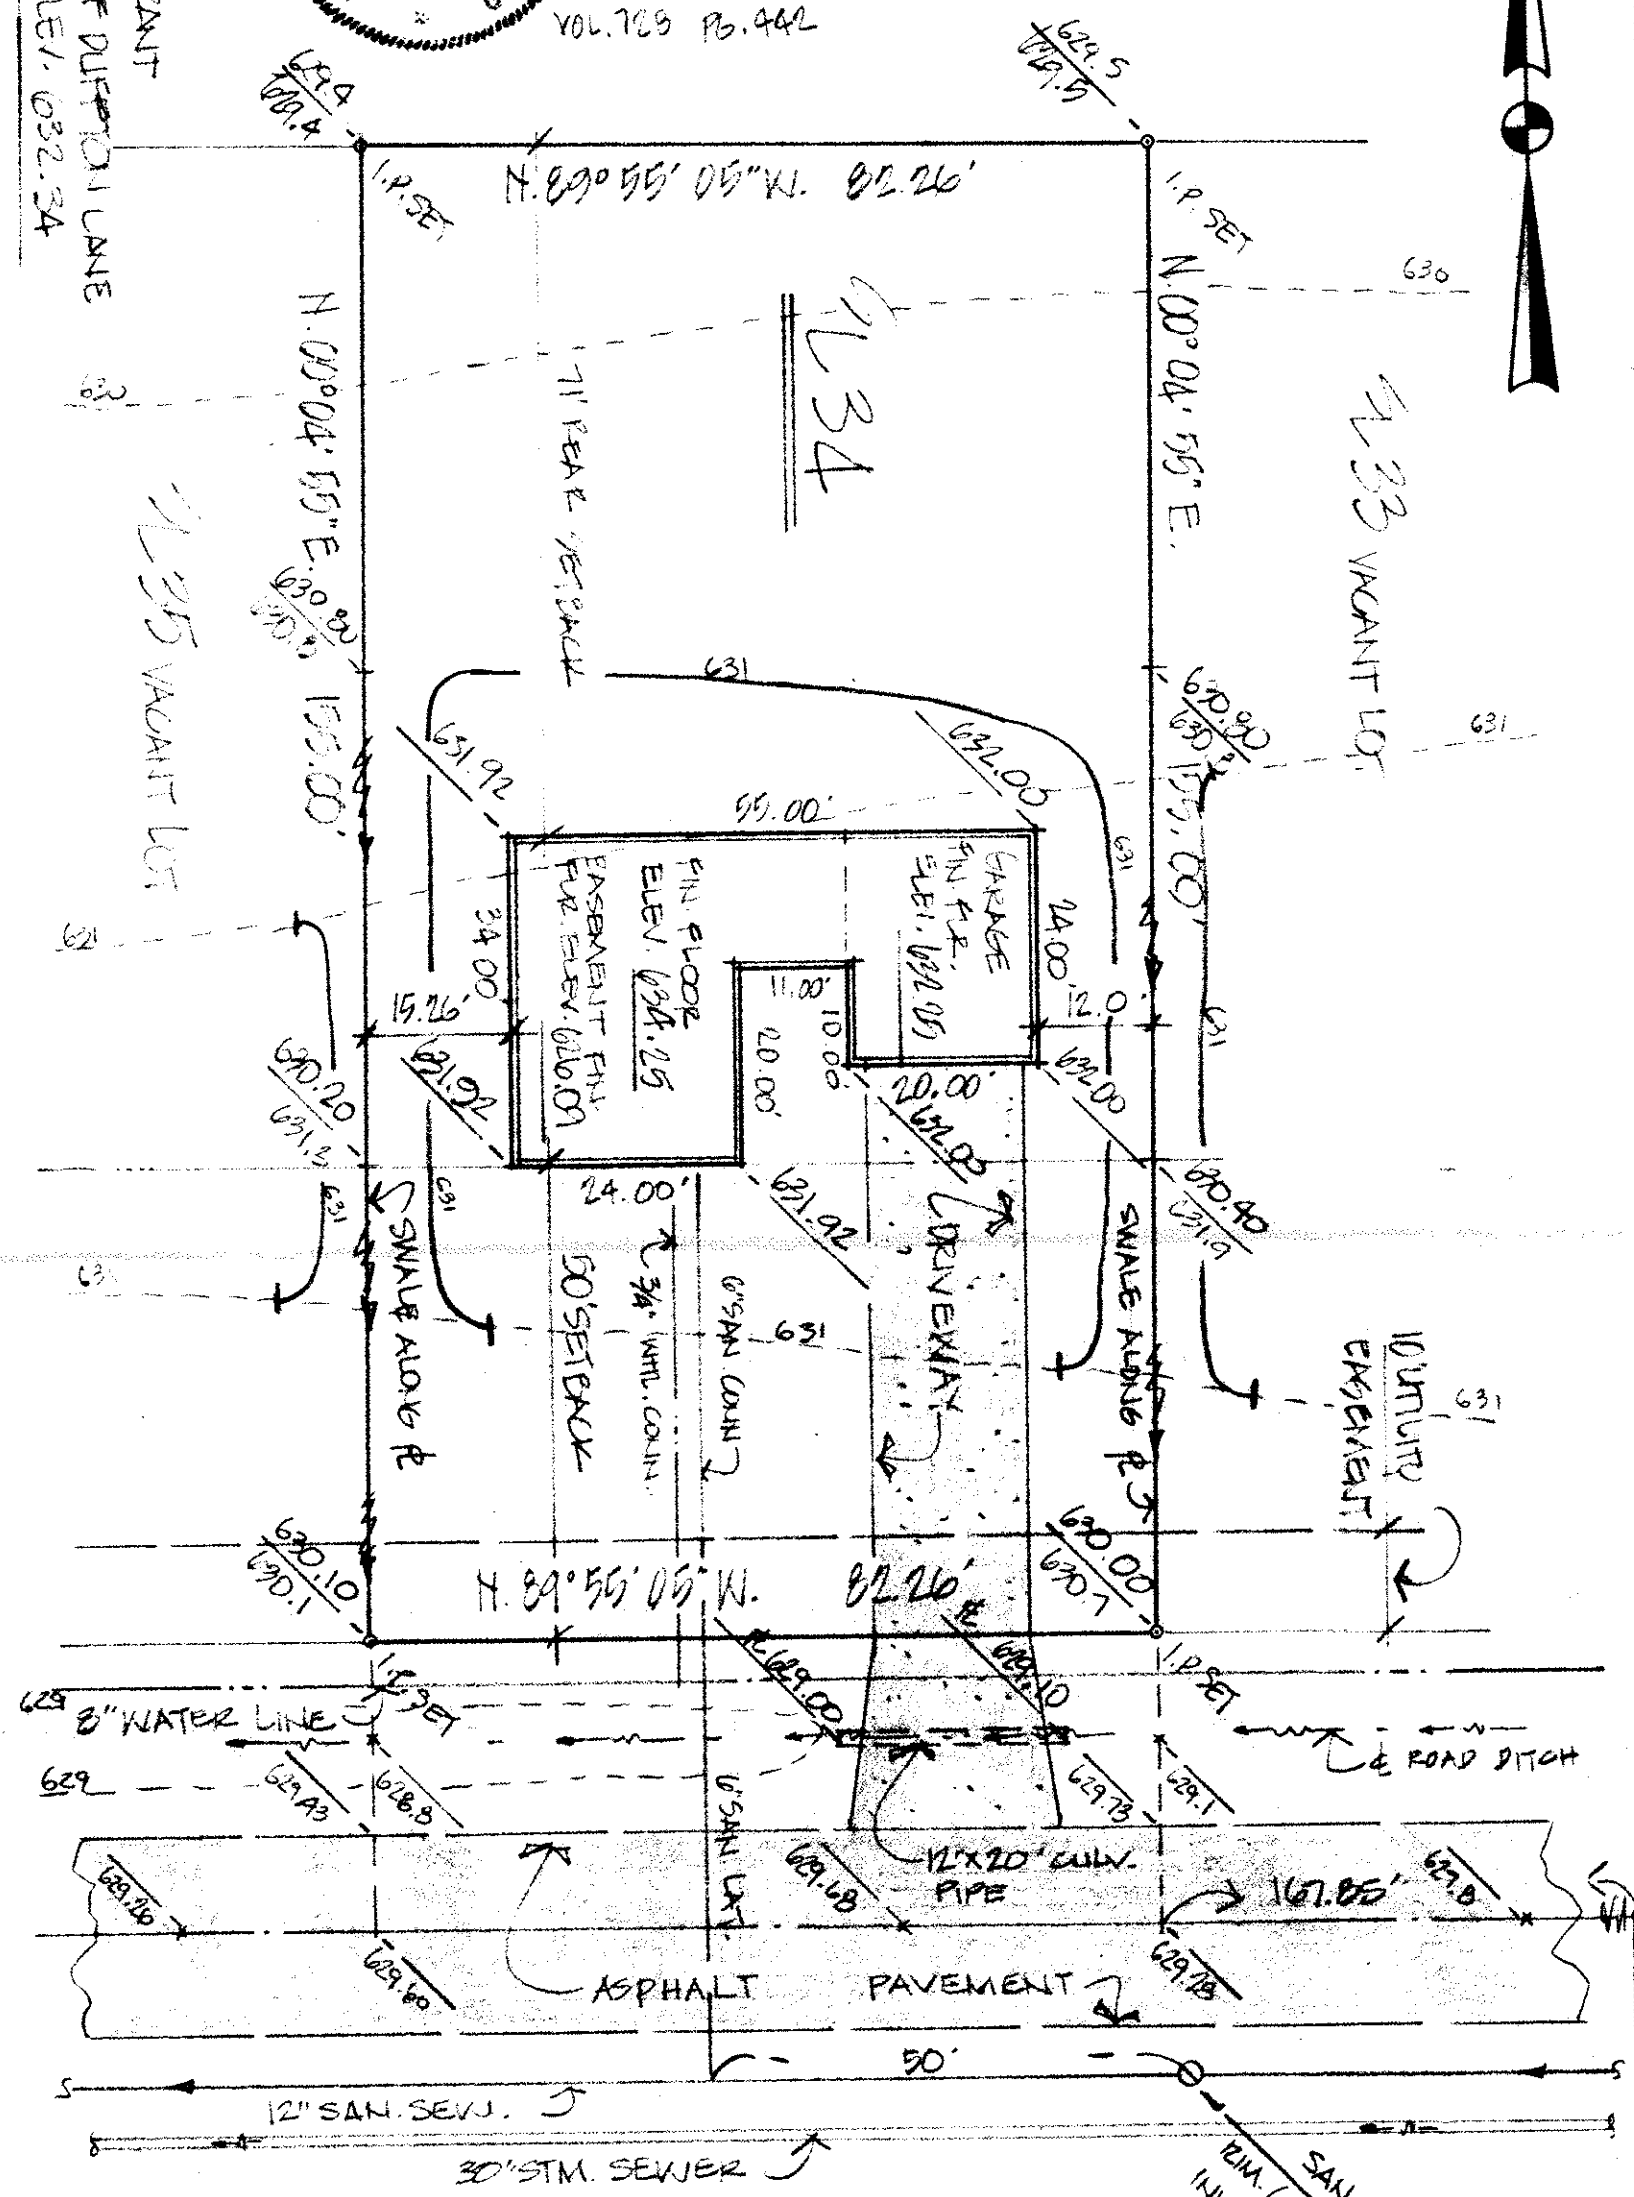

DUFFTON LANE 60'

This Permit Expires

4-25-89

PAINESVILLE TOWNSHIP

ZONING APPROVED

6939

Willie E. [Signature]

Zoning Inspector 7/29/88

Grading Plan Approved
as shown and/or noted
THOMAS P. GILLES, P.E.
Lake County Engineer

Date

BY

SHEFFIELD
TERACE