


WILFORD LANE 60'

1" WATER LINE

ASPHALT PAVEMENT

EXIST. 10" CULV PIPE

FIRE HYDRANT

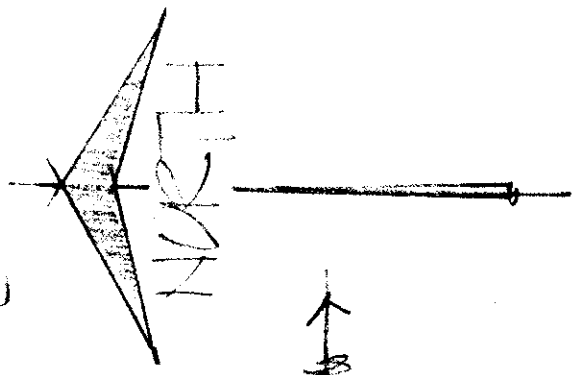

Grading Plan Approved -
shown and/or noted
by P. GILLES, P.E.
Professional Engineer

Date 23 Feb 84

This Permit Expires
FEB 21 1985

PAINESVILLE TOWNSHIP
ZONING APPROVED

5984
R.M. Hulse
Zoning Inspector 2/21/84

BENCH MARK: 10' HIGH OF
STAIN M.H. EL. 639.23

NOTE: DOWN SLOPES TO
EMPTY INTO SWALES
ALONG SIDE LINES.

UNDERLINED ELEVATIONS
INDICATE PROPOSED
GRADES.

DESIGN CERTIFICATION

THIS PLAT WAS PREPARED BY ME,
AND IS CORRECT TO THE BEST OF
MY KNOWLEDGE AND BELIEF.

W. J. Lafollette
REG. SURVEYOR NO. 4165

AS BUILT CERTIFICATION

I HEREBY CERTIFY THAT THE CIRCLED GRADES
ARE EXISTING FINISH GRADES CHECKED IN THE
FIELD ON _____ AND THAT
SURVEY IS CORRECT TO THE BEST OF MY
KNOWLEDGE AND BELIEF.

REG. SURVEYOR NO. _____



COLPETZER · WOODS
CONSULTANTS, INC.

9470 MENTOR AVENUE • MENTOR, OHIO 44060 • (216) 357-7569

DATE 2/23/84
SCALE 1"=60'
DRWN BY W. J. Lafollette
CHKD BY H
JOB NO. 10-120-001
FB 222-A PG. _____

NOTE: PLAT FOR
ED. WARD H. TRESCHER, INC.
2100 VEEWOOD BLVD., MENTOR, OHIO 44060
BEING SUBMITTED IN CONNECTION WITH
IN PAINESVILLE TOWNSHIP OHIO.