


DESIGN CERTIFICATION
THIS PLAT WAS PREPARED BY ME,
AND IS CORRECT TO THE BEST OF
MY KNOWLEDGE AND BELIEF.
5244

AS BUILT CERTIFICATION
I HEREBY CERTIFY THAT THE CIRCLED GRADES
ARE EXISTING FINISH GRADES CHECKED IN THE
FIELD ON
SURVEY IS CORRECT TO THE BEST OF MY
KNOWLEDGE AND BELIEF.
REG. SURVEYOR NO.

COLPETER • WOODS
CONSULTANTS, INC.
9470 MENTOR AVENUE • MENTOR, OHIO 44060 • (216) 357-7569

DATE: 6/12/87
SCALE: 1"=40'
DRAWN BY: CW
CHKD BY: JH
JOB NO: 15-26-03
FB: 3-11 PG

SITE PLAN FOR
BRYAN H. TRISLER, III.
8100 DEERWOOD BLVD., NATOR, OHIO
LOT 16 SUBD. NO. 80 THE HILLS SUBDIVISION
IN PAINEVILLE TOWNSHIP, OHIO.

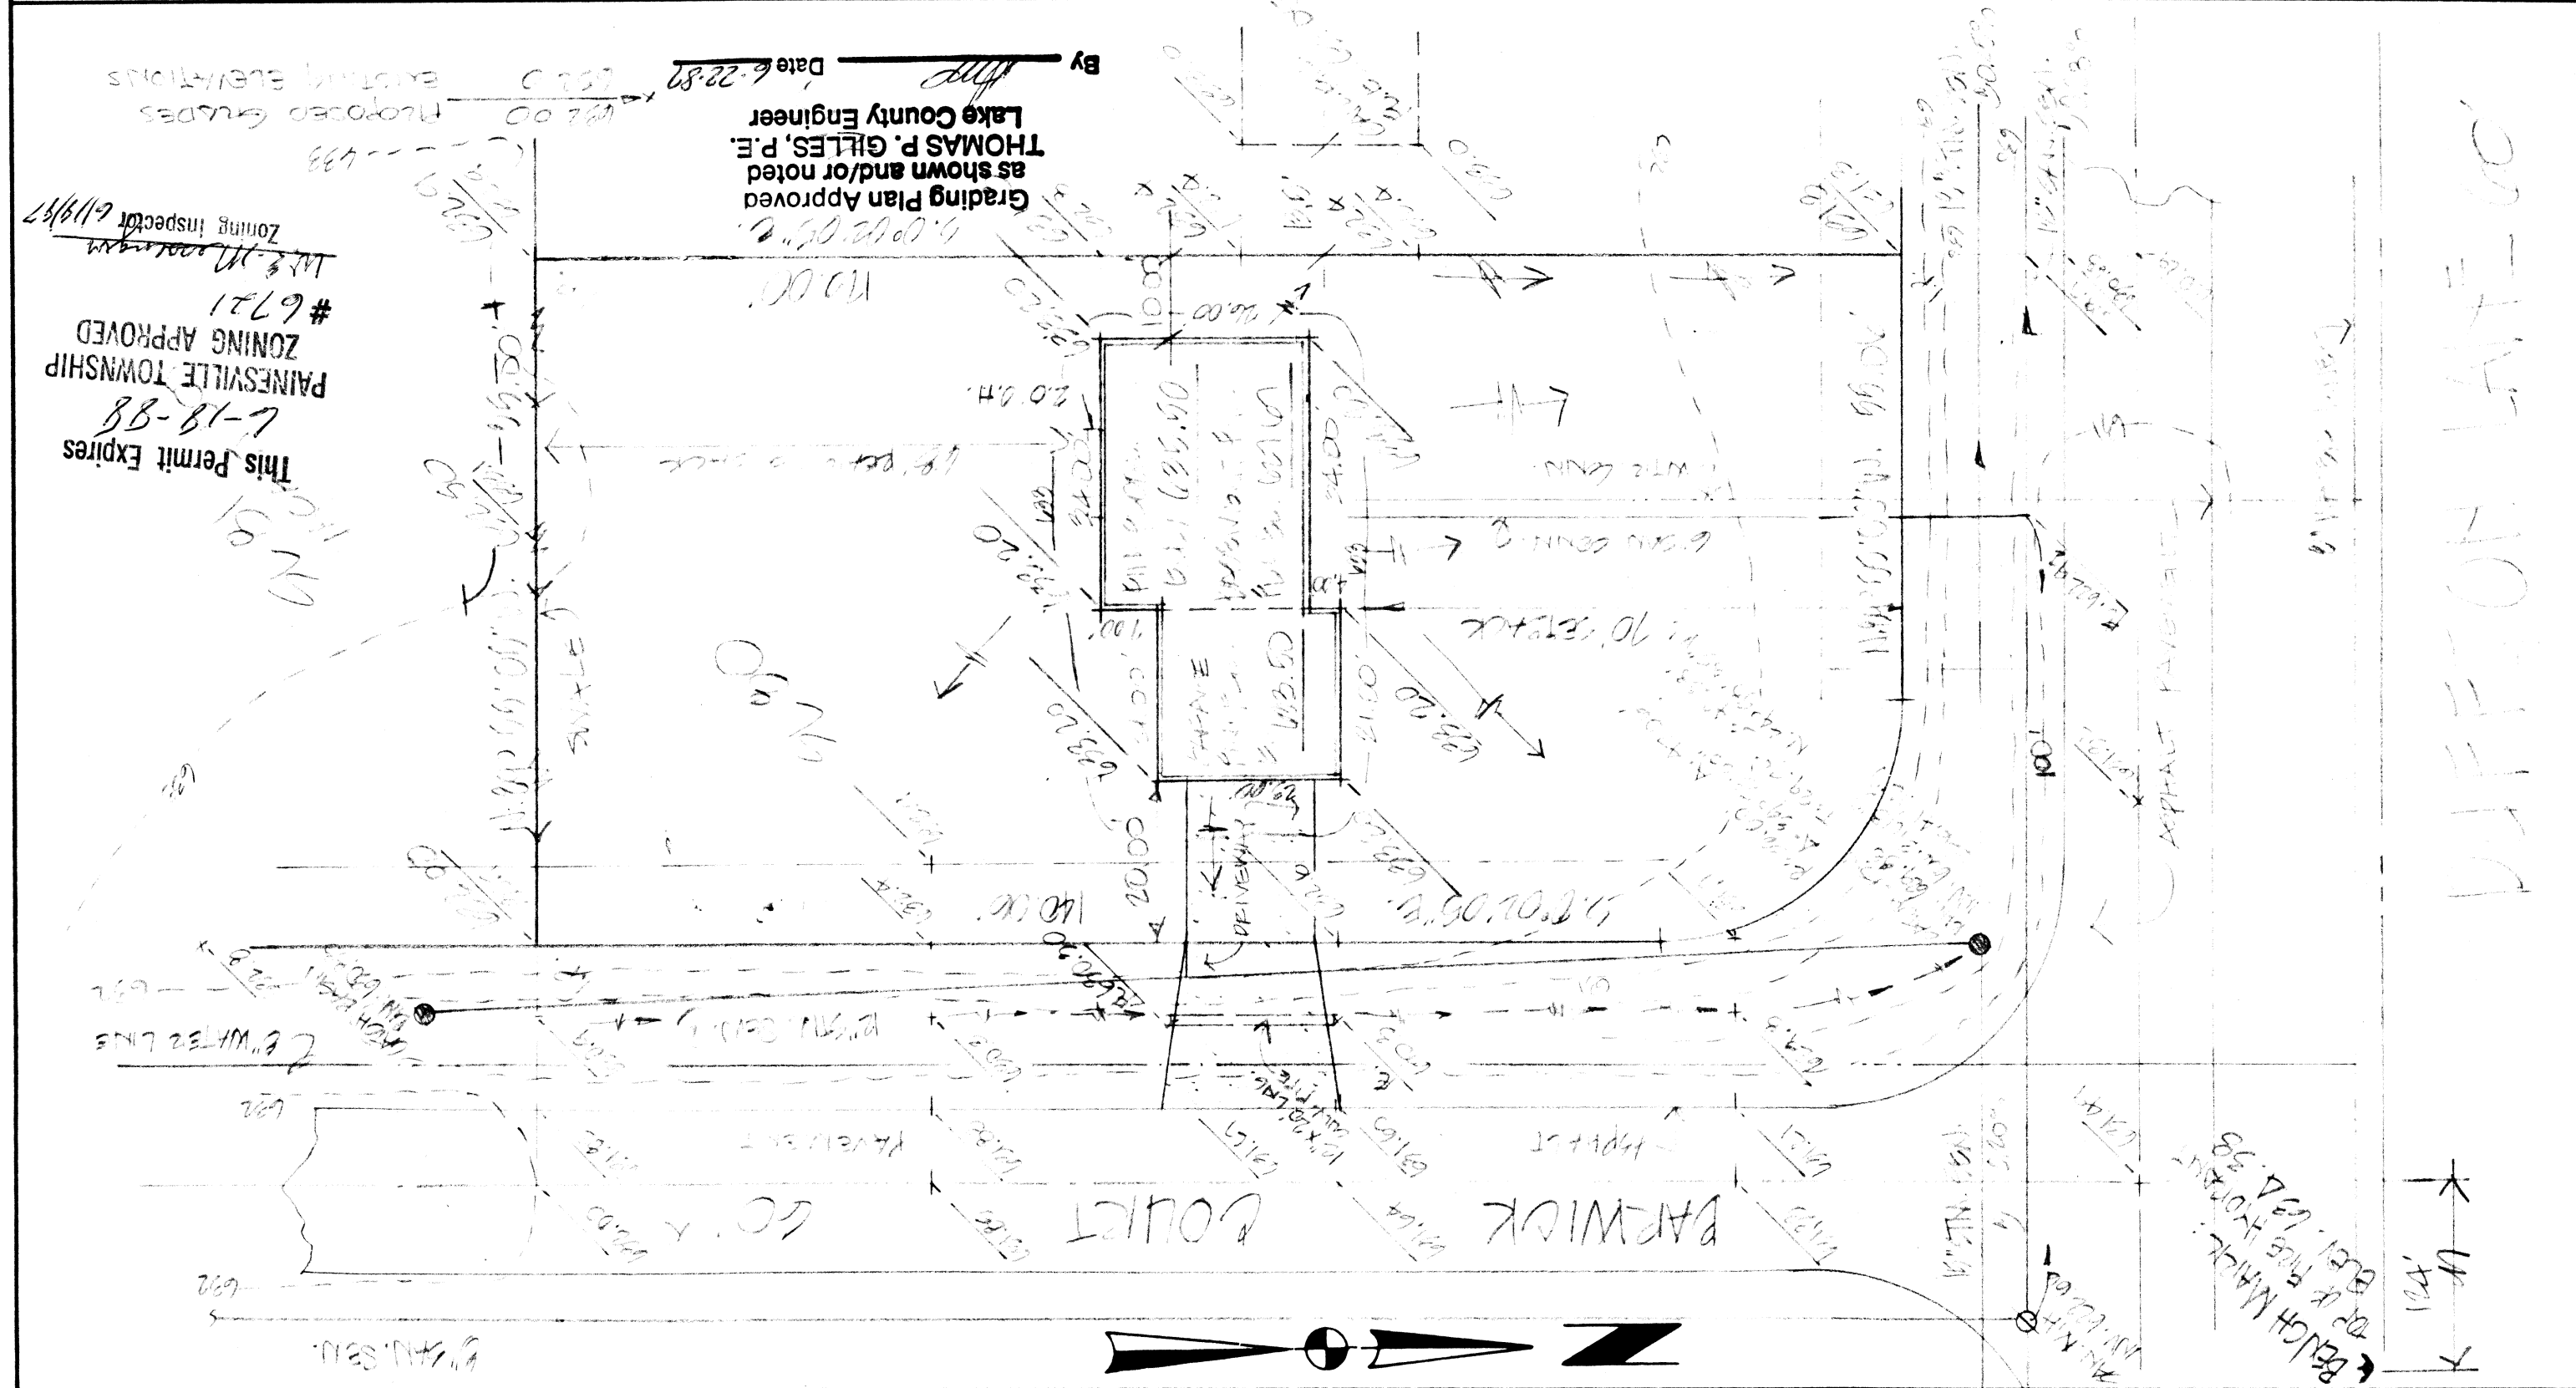

DIFFERENTIAL