


DESIGN CERTIFICATION
THIS PLAT WAS PREPARED BY ME, AND IS CORRECT TO THE BEST OF MY KNOWLEDGE AND BELIEF.

AS BUILT CERTIFICATION
I HEREBY CERTIFY THAT THE CIRCLED GRADES ARE EXISTING FINISH GRADES CHECKED IN THE FIELD ON SURVEY IS CORRECT TO THE BEST OF MY KNOWLEDGE AND BELIEF.

COLPETZER • WOODS
CONSULTANTS, INC.
9470 MENTOR AVENUE • MENTOR, OHIO 44060 • (216) 357-7569

DATE: APR. 23, 1986
SCALE: 1" = 20'
DRAWN BY: CB
CHKD BY: 18-156-024
JOB NO: FB 332-A PG

SITE PLAN FOR:
EDWARD H. KRESGER, INC.
2100 DEERWOOD BLVD., MENTOR, OHIO
BEING SUBLOT NO. 24 IN THE PINES SUBDIVISION NO. 2 IN PAINESVILLE TOWNSHIP, OHIO

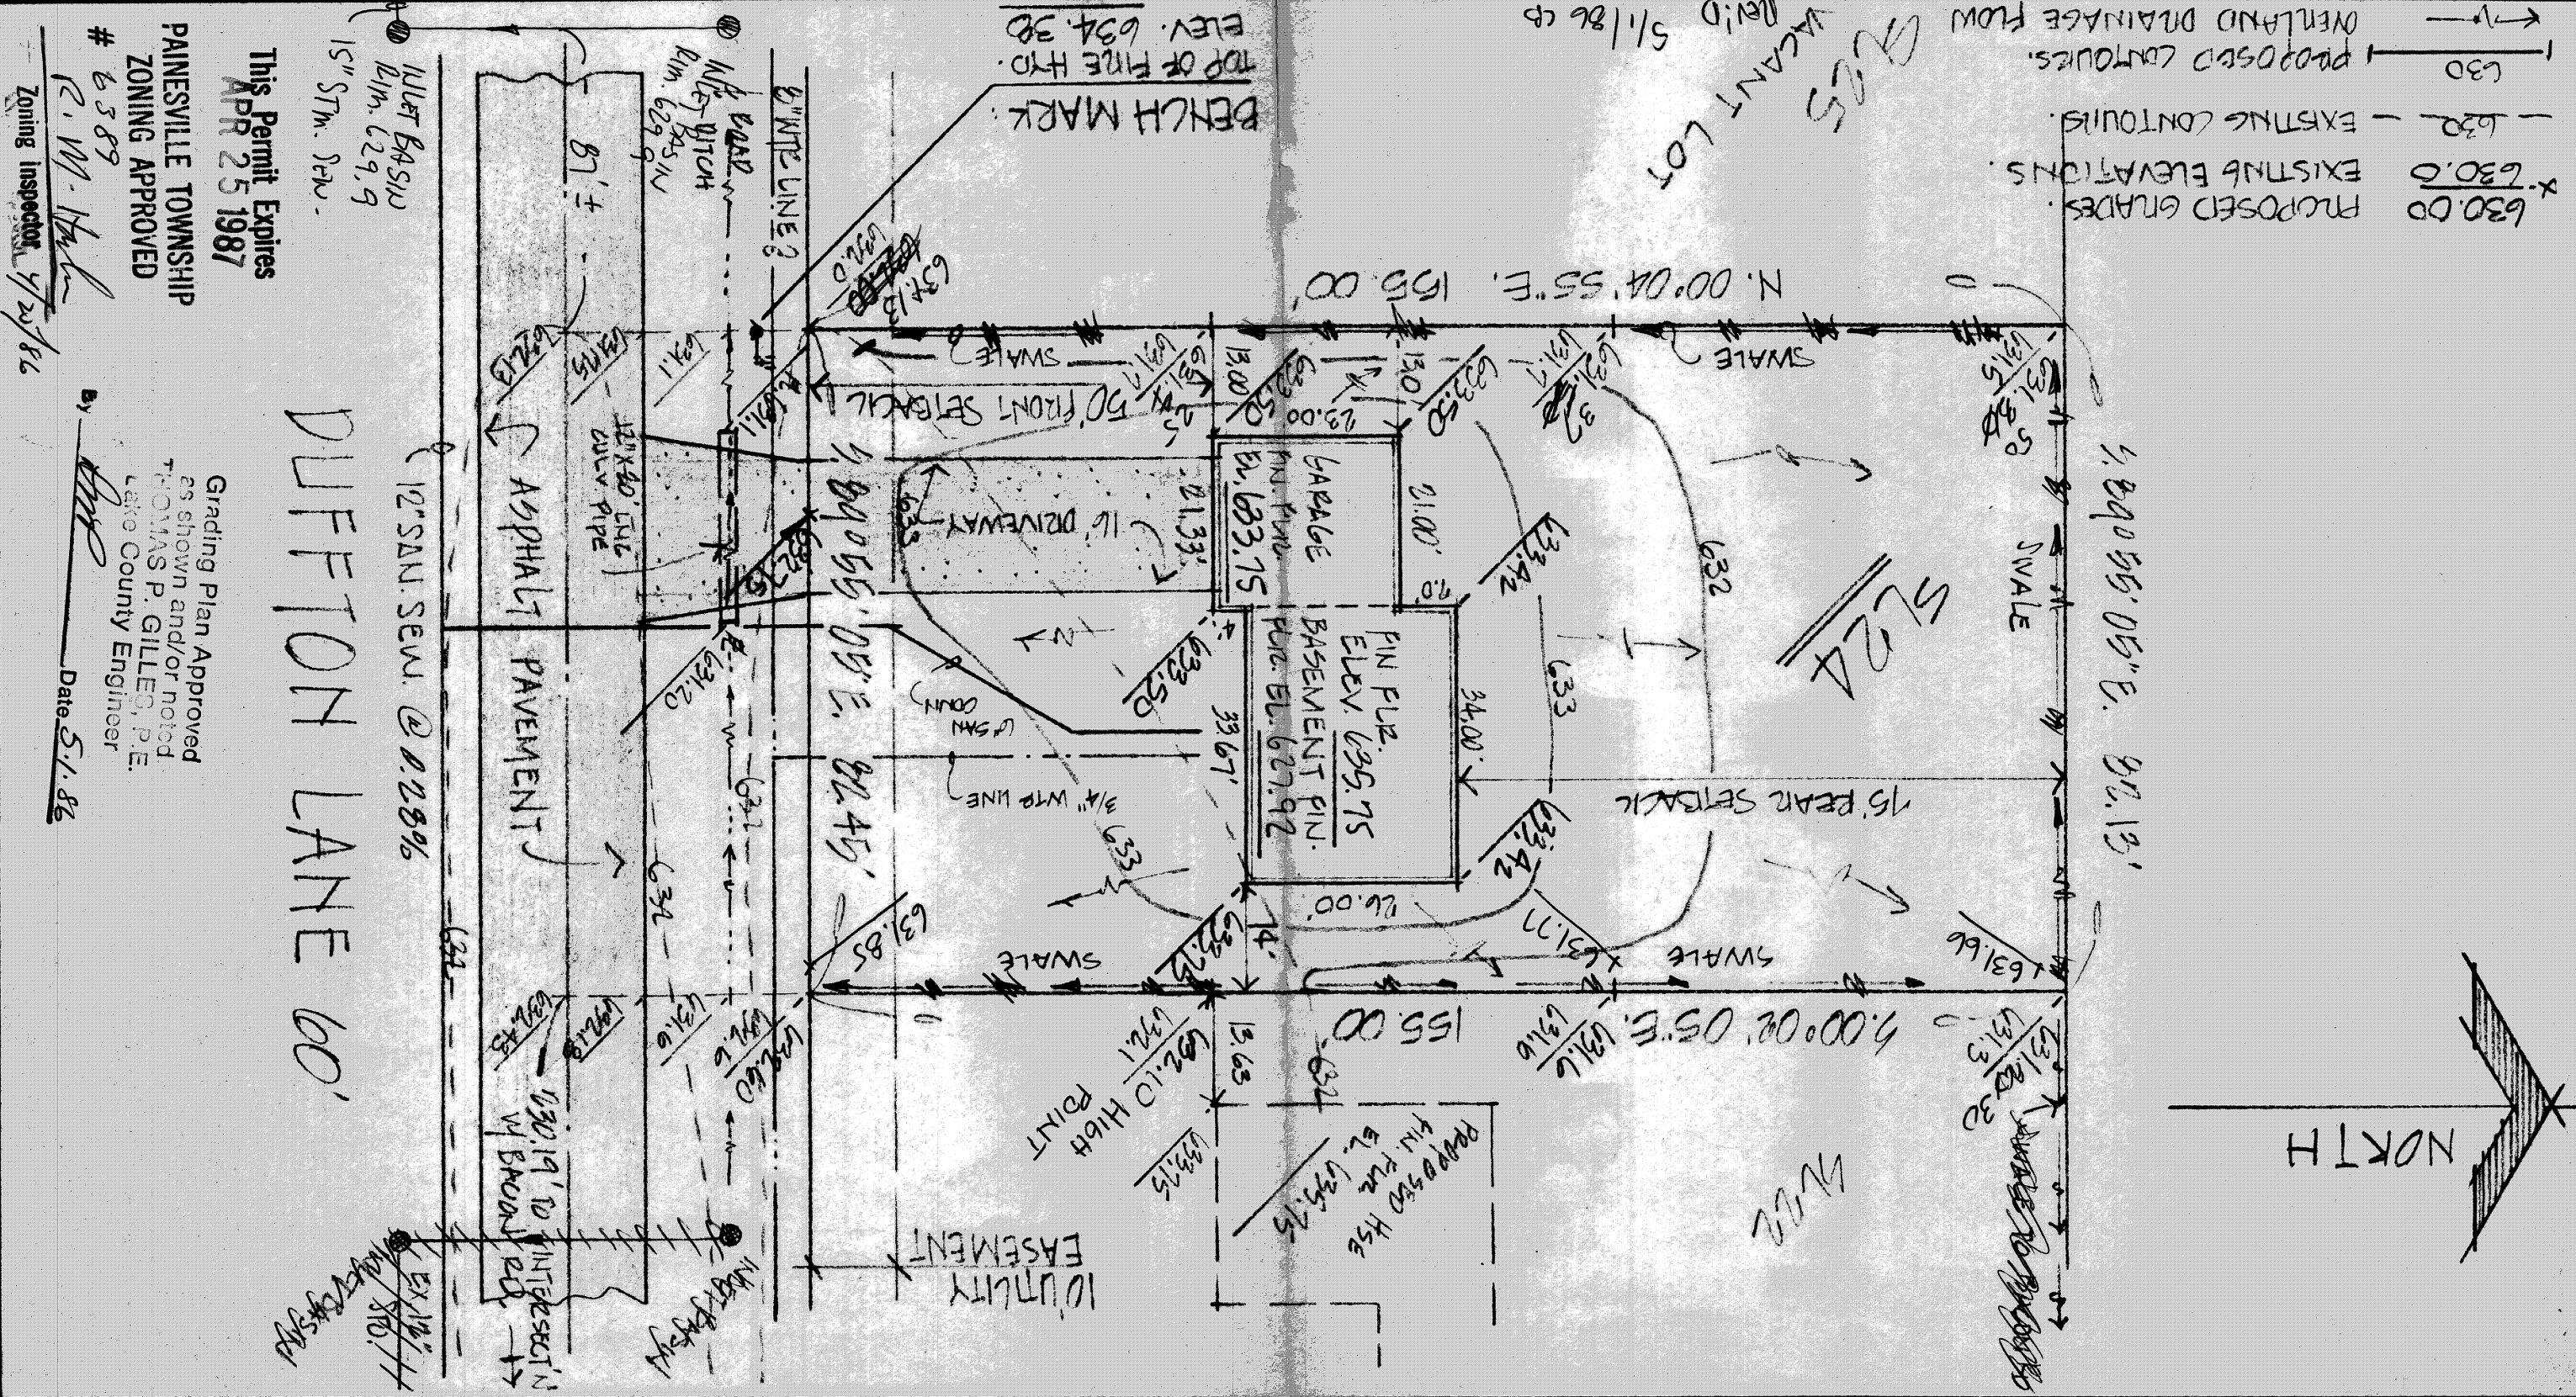

This Permit Expires
APR 25 1987
PAINESVILLE TOWNSHIP
ZONING APPROVED
6589
C. M. H. L.

Grading Plan Approved
as shown and/or noted
THOMAS P. GILLES, P.E.
Lake County Engineer
Date 5.1.86
Zoning Inspector 7/20/86