

**SITE PLAN**  
FOR  
**THE TAGG'S**  
BEING PART OF LOT NO. 21, TRACT NO. 1,  
IN THE TOWNSHIP OF PAINESVILLE, COUNTY  
OF LAKE, STATE OF OHIO

ANNA E. ALDEN  
T21-91

Grading Plan Approved  
as shown and/or noted  
**THOMAS P. GILLES, P.E.**  
Lake County Engineer

By 6/14 Date 10-10-96

I, the undersigned hereby certify this  
topography, indicated by 1' contours,  
and elevations shown hereon represent  
an actual field survey by me on July 16, 1996  
and that the were taken at appropriate  
intervals and that as of that date they  
existed as indicated hereon.

JM Off

ALBERT R. ALDEN  
ANNE E. ALDEN

|                                                    |
|----------------------------------------------------|
| Reviewed and Accepted                              |
| LAKE COUNTY GENERAL HEALTH DISTRICT                |
| Date <u>9-24-96</u>                                |
| <u>Avoid footer drain</u>                          |
| JOEL LUCIA, R. S., M. P. H.<br>Health Commissioner |
| By <u>J. Lindsay</u>                               |

- A. To be brought to finished grade**
1. Septic tank manhole covers
  2. Splitter box cover
  3. Distribution box cover
- B. No footer drains or downspouts**  
to be discharged into septic tanks
- C. All waste water to be discharged into**  
septic tanks



**LOW YIELD WATER  
FIXTURES REQUIRED  
ON ALL:**

- Shower Head
- Toilet

SEWAGE DISPOSAL PERMIT MUST BE  
OBTAINED BY A LAKE COUNTY LICENSED  
INSTALLER BEFORE INSTALLATION IS  
STARTED.

**VILLAGE SURVEYING CO.**  
X 1096, FAIRPORT HARBOR, OHIO 44077  
(216) 357-1359

APPROVED  
PAINESVILLE TOWNSHIP  
ZONING DEPARTMENT  
96-10-11  
DJR

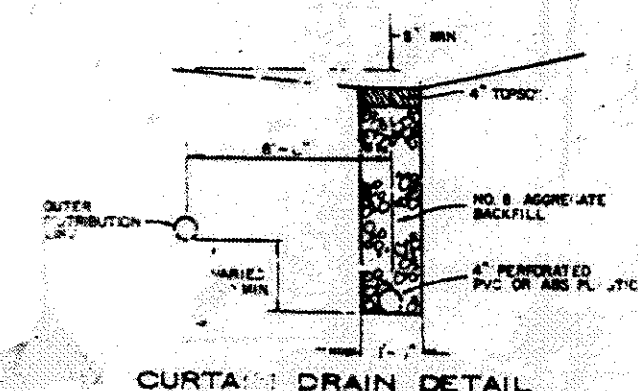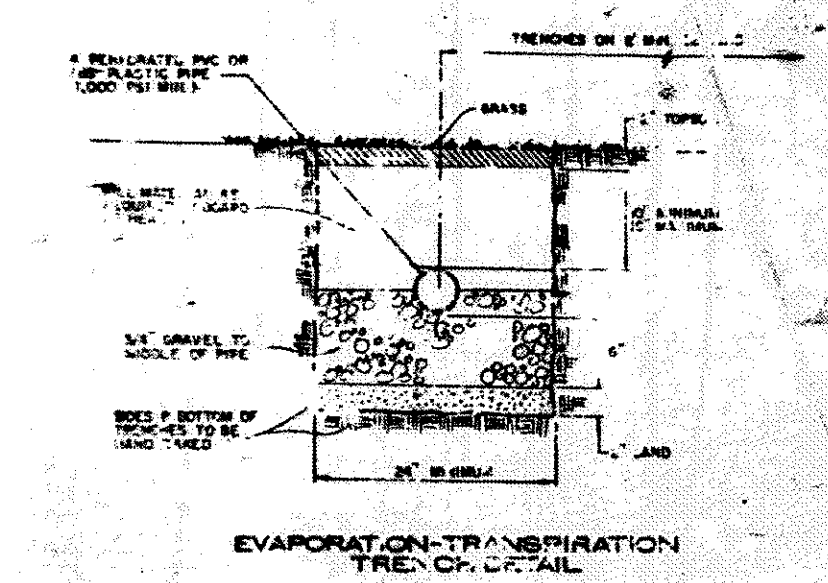

HYDRAULIC PROFILE  
VERT. 1" = 3' HORIZ. 1" = 100'

FF-114.25  
GRINDER PUMP  
REQD IF PUMPING  
IN BASEMENT  
BSMT-104.92

