

SITE & DRAINAGE PLAN FOR:

SANTO PAPPALARDO
28841 SERINITY LANE
WICKLIFFE, OHIO

BEING SUBJECT NO. 14 IN THE REESEN
SUBDIVISION IN PAINESVILLE TWP., OHIO BY J.W.K.

PAINESVILLE TOWNSHIP
ZONING APPROVED

With change noted
3249 - 8-7-73
Zoning Inspector
W. A. Henderson

Grading Plan Approved
as shown and/or noted
THOMAS P. GILLES, P.E.
Lake County Engineer




PREPARED BY:

WM. R. GRAY ASSOC. INC.
ENGINEERS & SURVEYORS
7547 MENTOR AVE
MENTOR, OHIO

DATE: AUGUST 1, 1973 SCALE 1"=20'

CERTIFICATION:

I HEREBY CERTIFY THAT THIS PLAT IS
CORRECT TO THE BEST OF MY KNOWLEDGE
By: *Wm. R. Gray*
WM. R. GRAY REG. SURV. #2752
OR DONALD O. BREWSTER REG. SURV. #5273

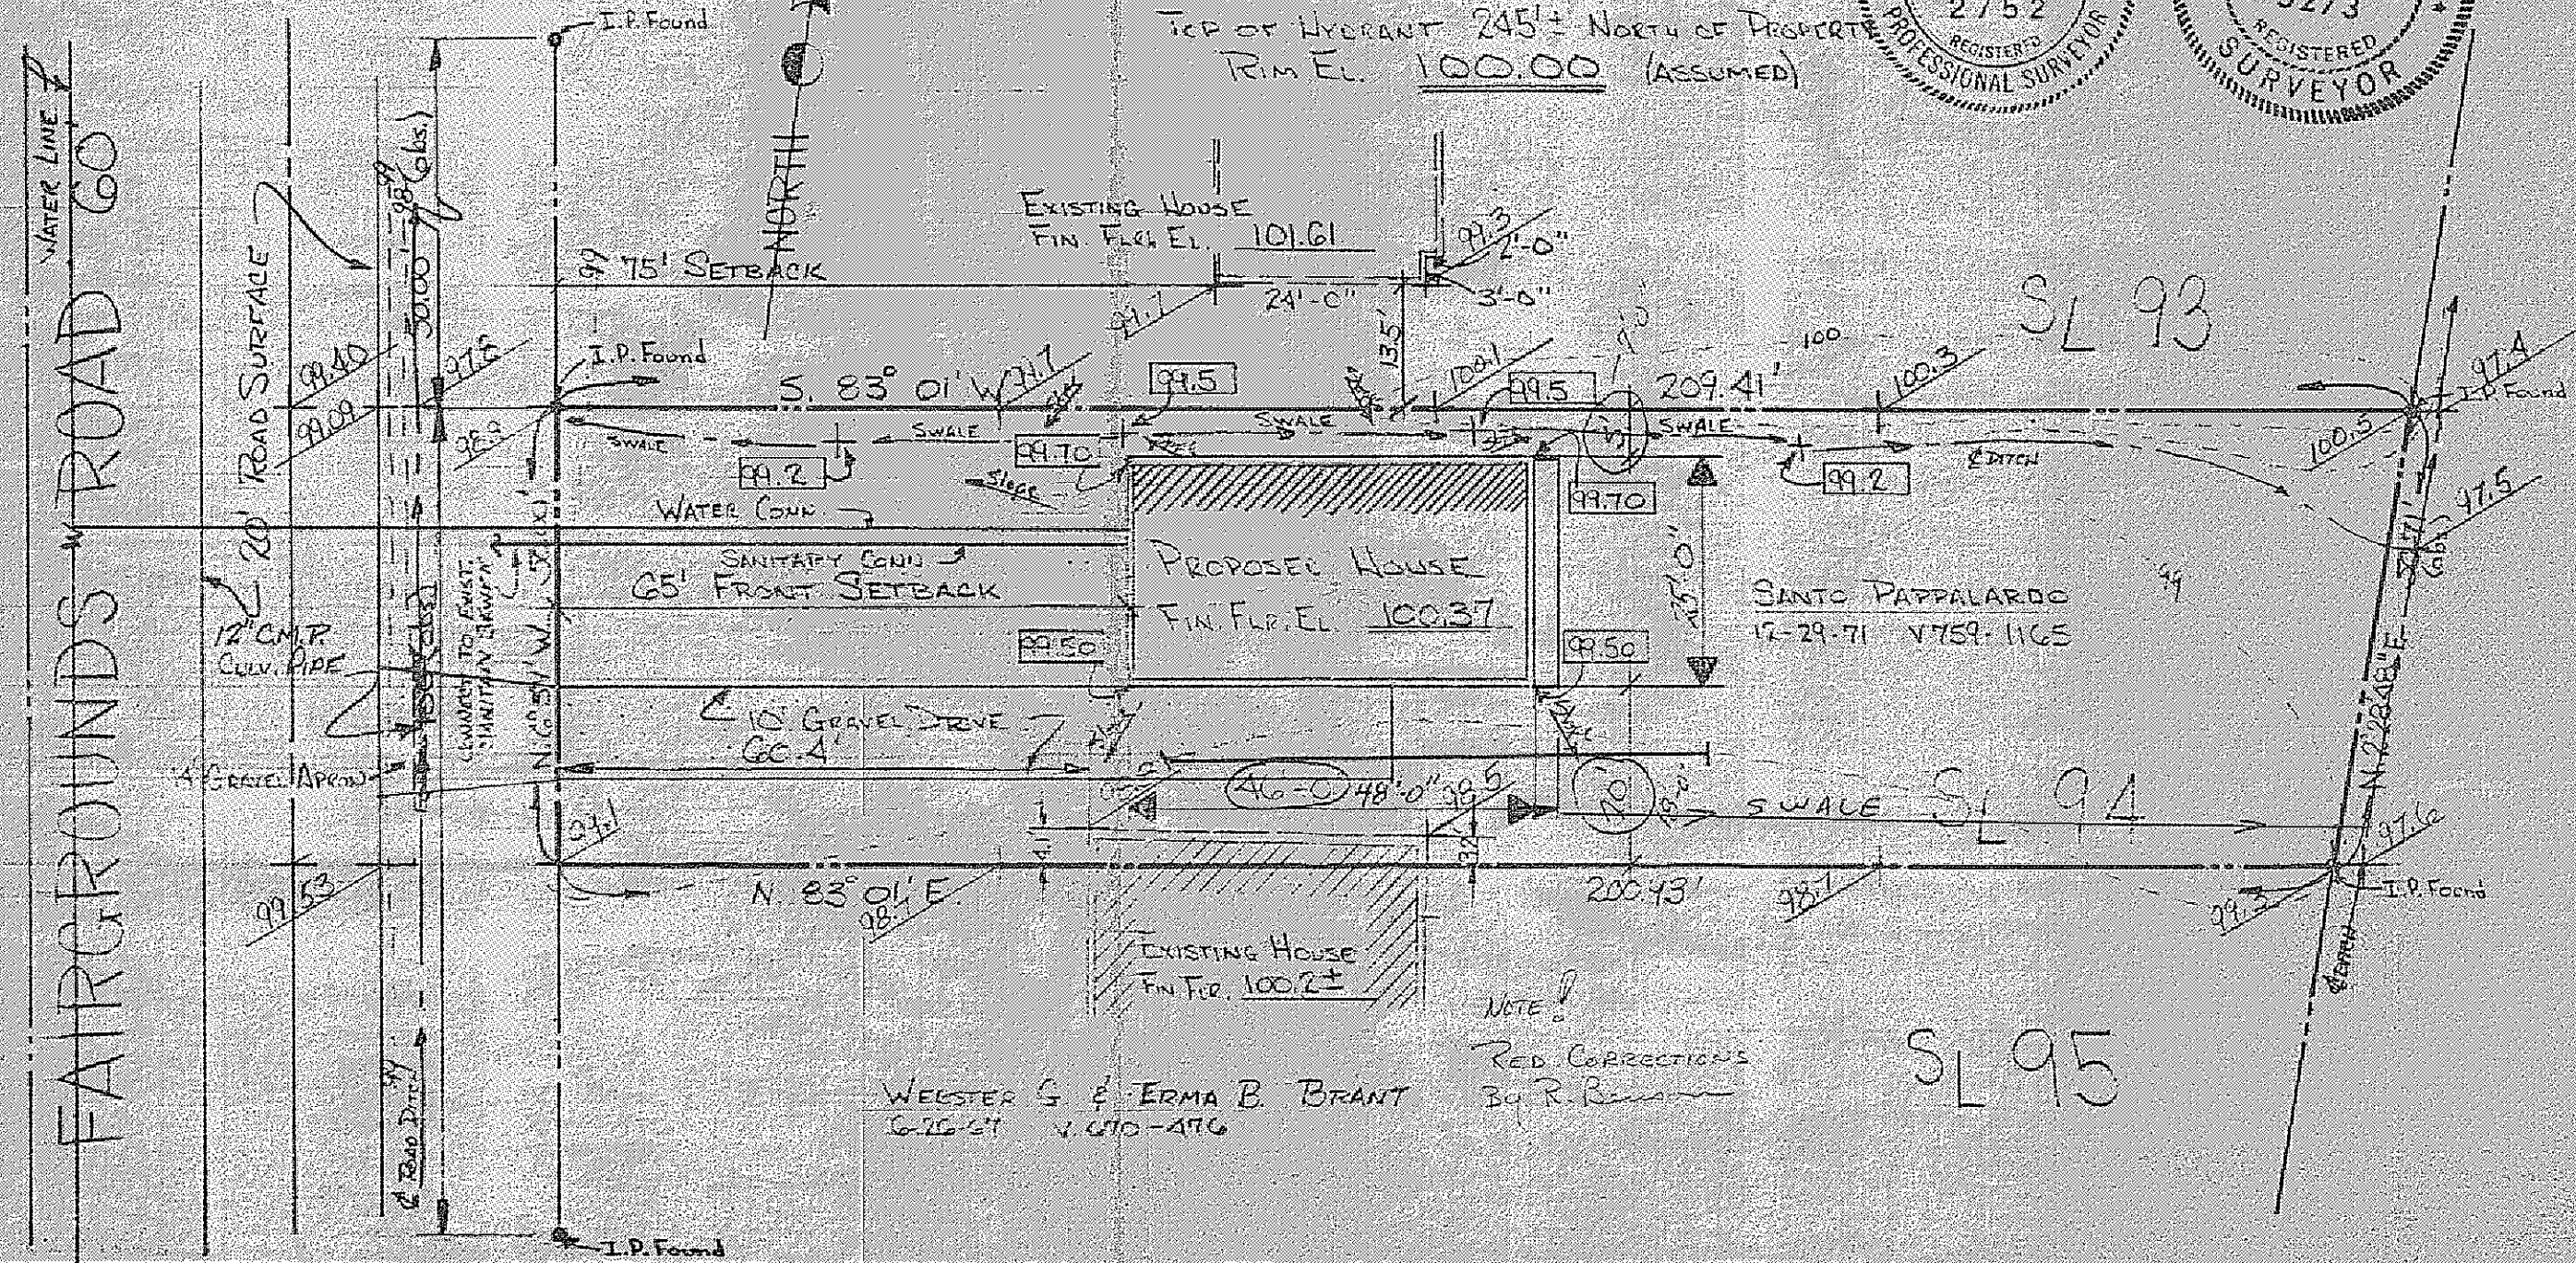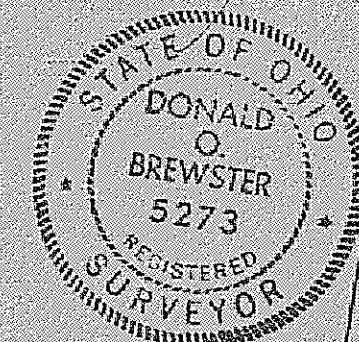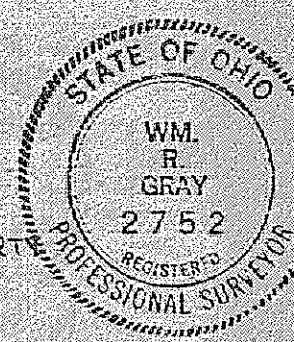

SL 93

SL 94

SL 95