


THIS PLAT WAS PREPARED BY ME,  
AND IS CORRECT TO THE BEST OF  
MY KNOWLEDGE AND BELIEF.

REG. SURVEYOR NO. 4642

I HEREBY CERTIFY THAT THE CIRCLED GRADES  
ARE EXISTING FINISH GRADES CHECKED  
FIELD ON \_\_\_\_\_ AND  
SURVEY IS CORRECT TO THE BEST OF MY  
KNOWLEDGE AND BELIEF

REG. SURVEYOR NO.

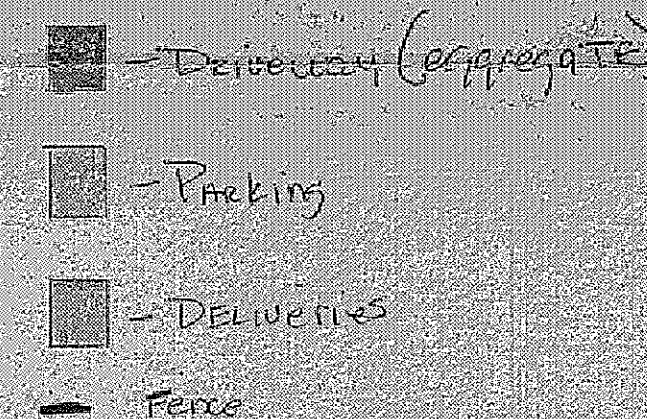

This Permit Expires  
OCT 10 1980  
PAINESVILLE TOWNSHIP  
ZONING APPROVED  
# 4937  
Ralph M. Hulse  
Zoning Inspector  
10/10/79

REMOVED: ADDED SEPTIC SYSTEM 9/11/70

ES CANFIELD CO

BEING PART OF LOT 6, TRACT 2  
PAINEVILLE TOWNSHIP, LAKE COUNTY, OHIO

DATE 7-30-79  
SCALE 1" = 50'  
DRAWN BY TCA  
CHK'D BY \_\_\_\_\_  
FBI 364 12



**COLPETZER · WOODS**  
CONSULTANTS, INC.  
MENTOR, OHIO 44060

**SHEET**  
/

**CONTRACT**

SCALE: HORIZ. 1" = 30'  
VERT. 1" = 5'

246 Fairport Nursery