

PREPARED BY
Wilson and Associates
Registered Surveyors
11005 Wilson Mills Road
Chardon, Ohio 44024
Date: April 15, 1974
Scale: 1" = 30'

SITE PLAN

FOXFIRE TRAILS SUBDIVISION


SUBLOT NO. 12

VOLUME 5 PAGE 7

PAINESVILLE TOWNSHIP

LAKE COUNTY OHIO

for
CASEMENT HOMES
1251 MADISON AVE.
PAINESVILLE, OHIO

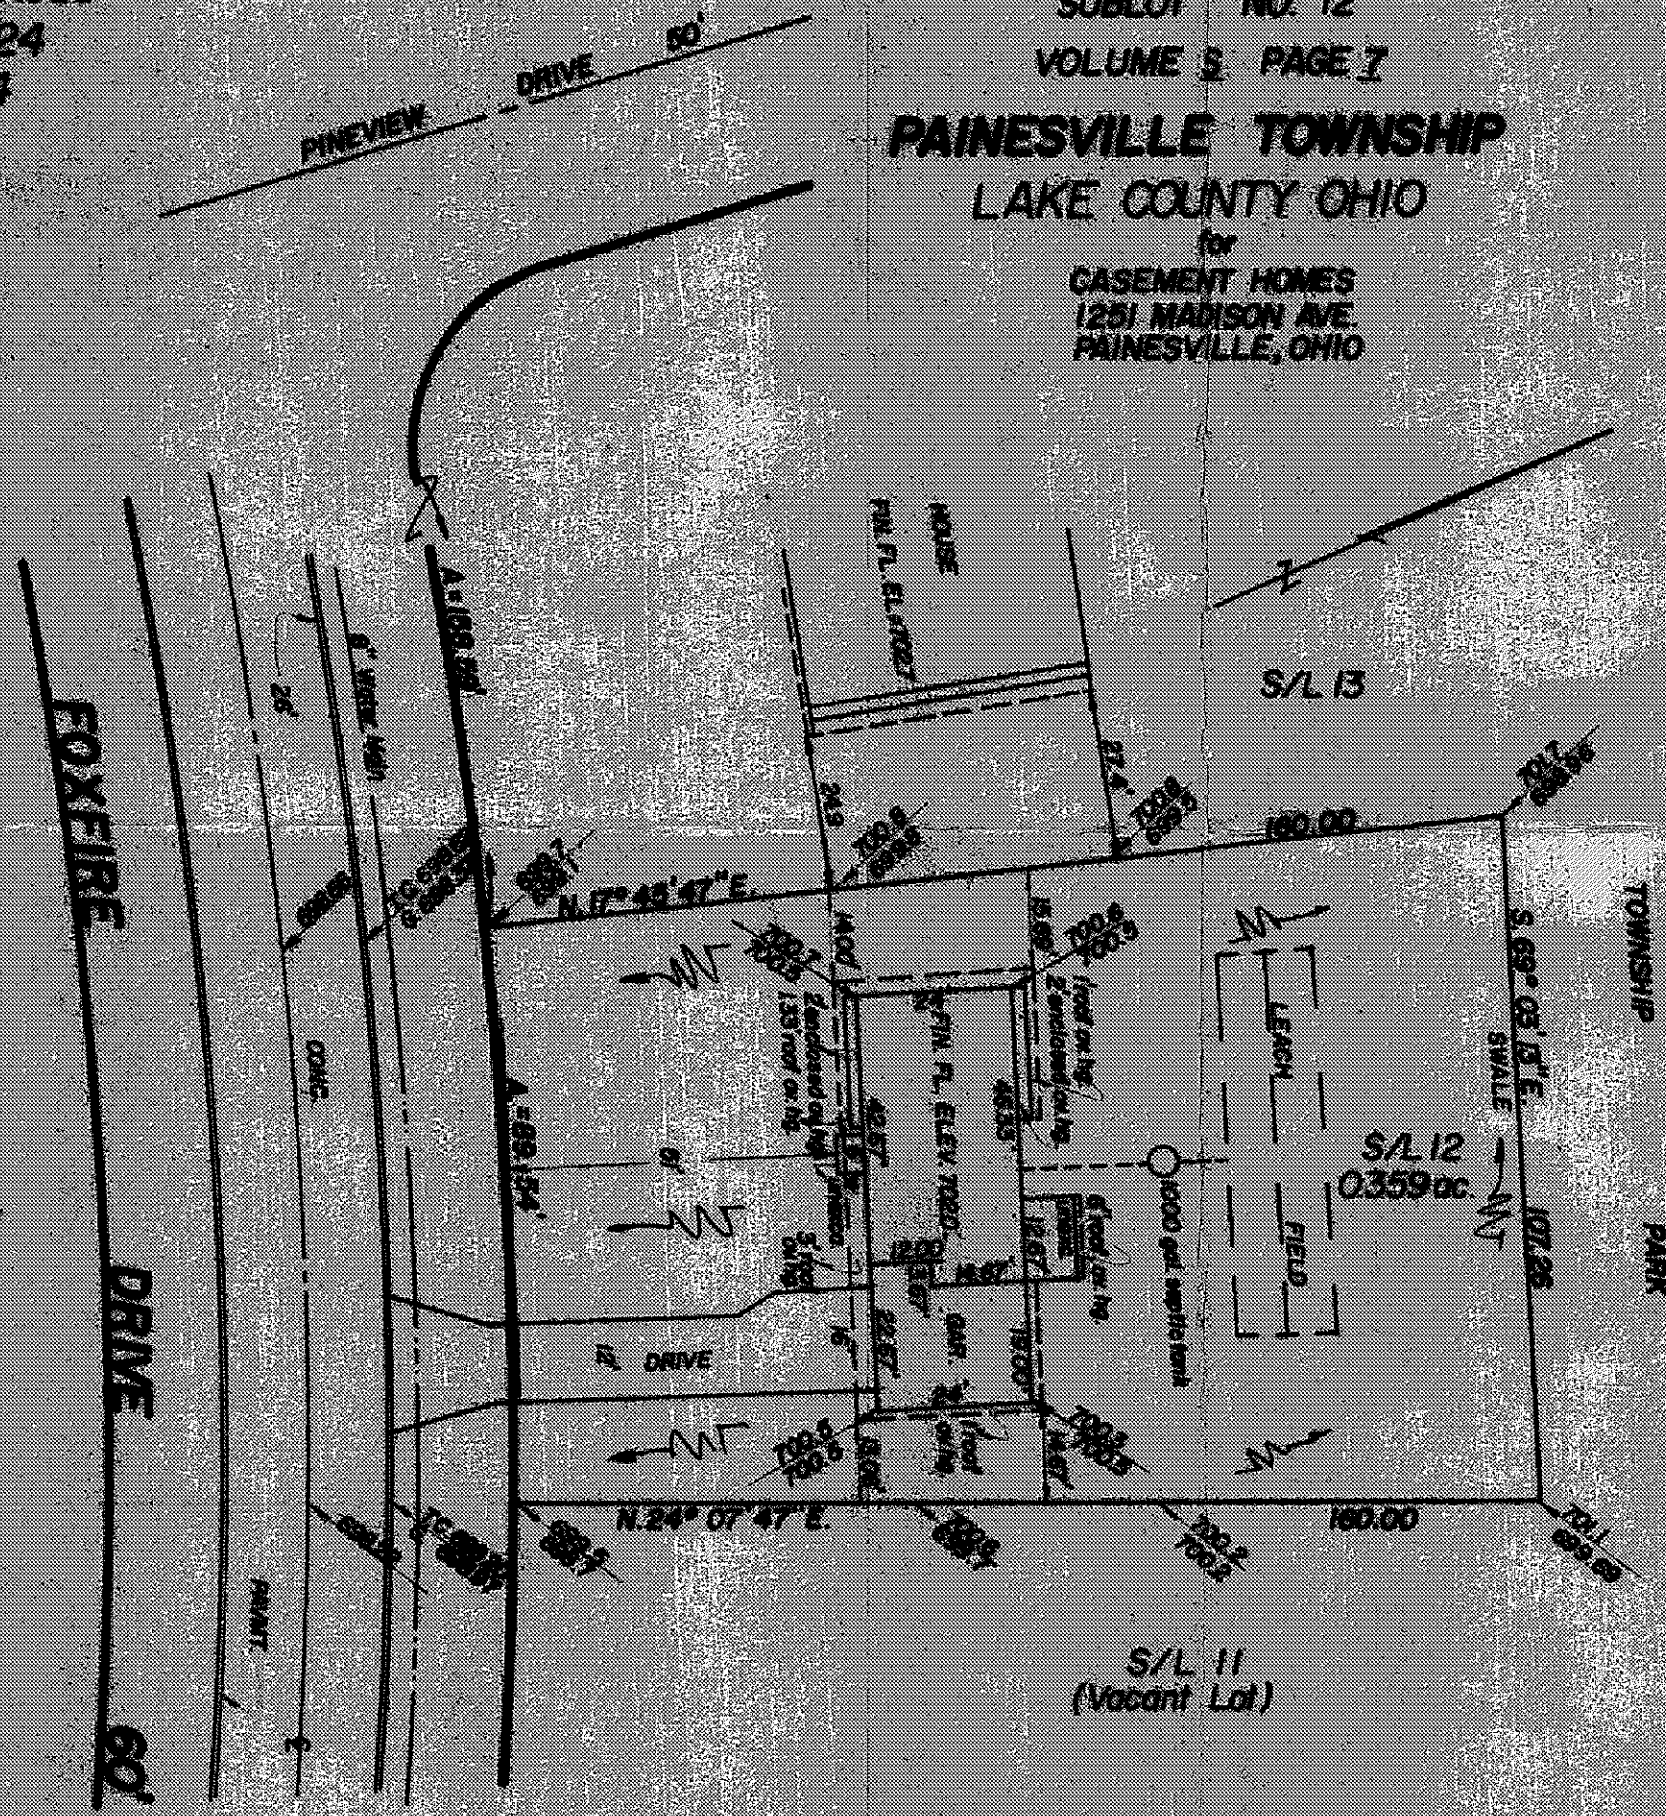

CERTIFICATION

I certify that this plat was prepared by me, and is correct to the best of my knowledge.

By:

Lawrence Wilson
Lawrence Wilson, Reg. Surveyor No. 5807

"AS BUILT" CERTIFICATION

I certify that on _____ 1974, the finished grades were checked in the field, shown encircled, and are correct to the best of my knowledge.

By:

Lawrence Wilson, Reg. Surveyor No. 5807

BENCH MARK: TOP OF MON. BOX RIM AT INTERSECTION OF C'S PINEVIEW AND FOXFIRE DR. ELEV. 696.84

EXIST. EL.
PROP. EL.

PAINESVILLE TOWNSHIP
ZONING APPROVED

#3431 4-17-74

M. d. Henderson
Zoning Inspector

Grading Plan Approved
as shown and/or noted
THOMAS E. GILLES, P.E.
Lake County Engineer

By *JWK* Date 4-17-74

