


PREPARED BY:
Wilson and Associates
Registered Surveyors
11005 Wilson Mills Road
Chardon, Ohio 44024
Date: July 19, 1974
Scale: 1" = 30'

SITE PLAN
FOX FIRE TRAILS SUBDIVISION
SUBLOT NO. 23
VOLUME 5 PAGE 7
PAINESVILLE TOWNSHIP
LAKE COUNTY OHIO
for
CASEMENT HOMES
1251 MADISON AVE.
PAINESVILLE, OHIO

CERTIFICATION:
I certify that this plat was prepared by me,
and is correct to the best of my knowledge
By: Lawrence Wilson
Lawrence Wilson, Reg. Surveyor No 5807
"AS BUILT" CERTIFICATION:
I certify that on _____ 1974,
the finished grades were checked in the
field, shown encircled, and are correct to
the best of my knowledge.
By: _____
Lawrence Wilson, Reg. Surveyor No 5807

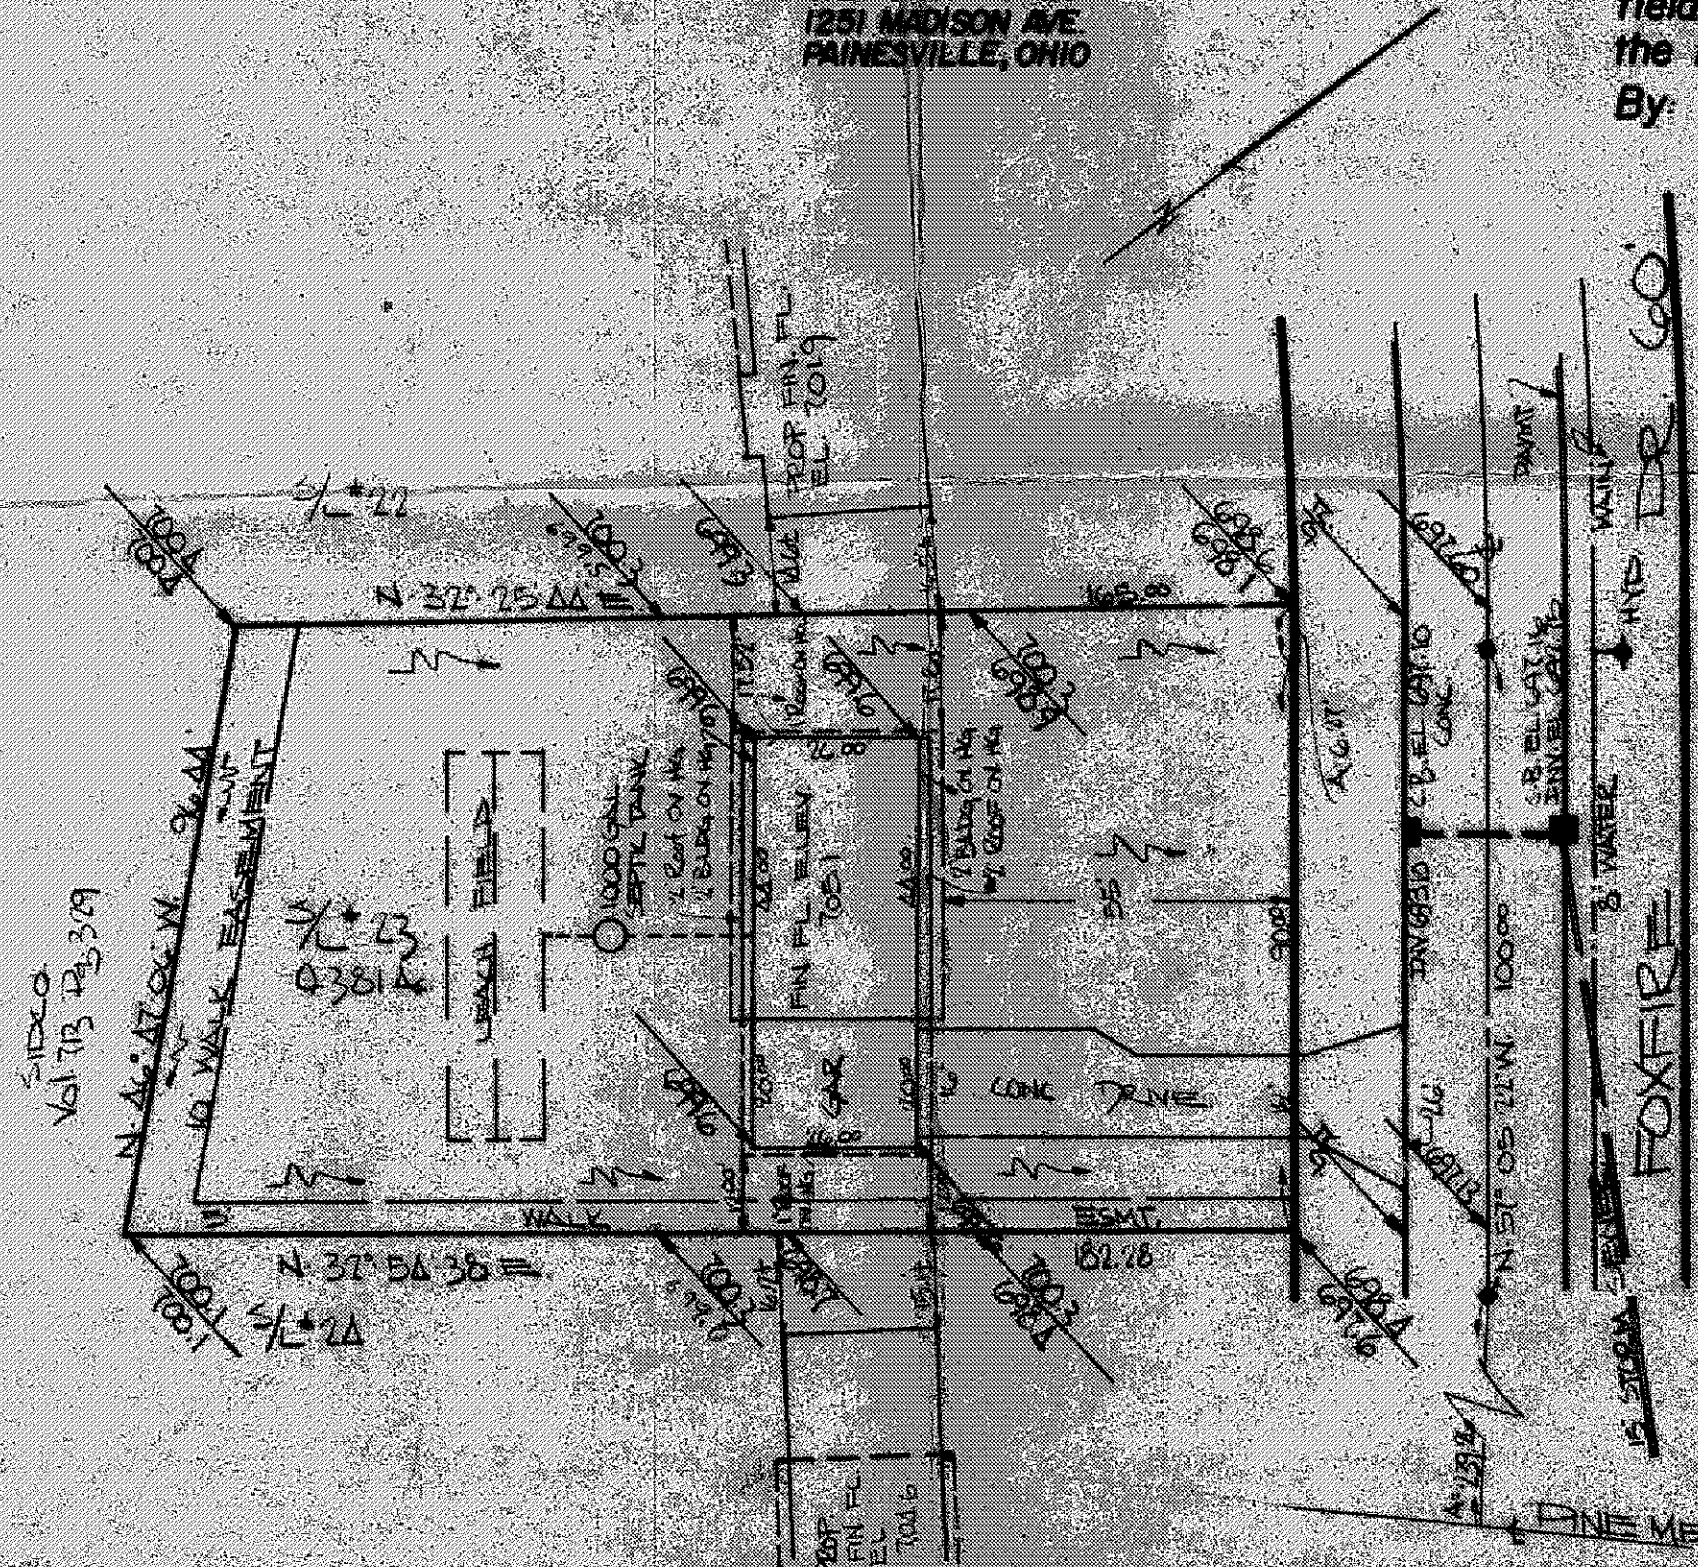

PAINESVILLE TOWNSHIP
ZONING APPROVED
#3516 7-24-74
D. A. Henderson
Zoning Inspector

BENCH MARK TOP OF MON BOX P
AT INTERSECTION OF C₂ OF D₁ & D₂
MEADOW PLACE - FOX FIRE TRAILS
EL = 646.12

EXIST
PROP

Grading Plan Approved
as shown and/or noted
THOMAS P. GILLES, P.E.
Lake County Engineer.

By JWK Date 7-25-74