


I, the undersigned hereby certify that the boundary survey represented by this plat and that all monumentation set has been done in accordance with the specifications set forth in Chapter 4733-37 of the Ohio Administrative Code.

I, further certify that the topography, indicated by 1 foot contours and elevations shown hereon represent an actual field survey made by me on Dec 15, 01 and the elevations were taken at the appropriate intervals and that as of that date they existed as indicated hereon.

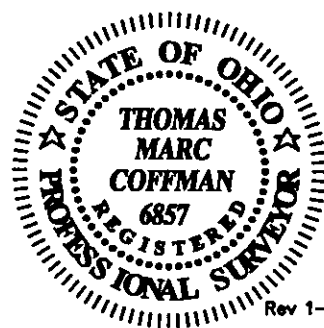


Rev 1-03-02 (overhang & sideline)

SITE PLAN
FOR
TOM REED, GENERAL CONTRACTOR

Being Sublot No. 26 of the Ridgewood Subdivision
(Proposed), of part of Lot No. 46, Tract No. 4, in
the Township of Painesville, Lake County, Ohio.



SCALE IN FEET

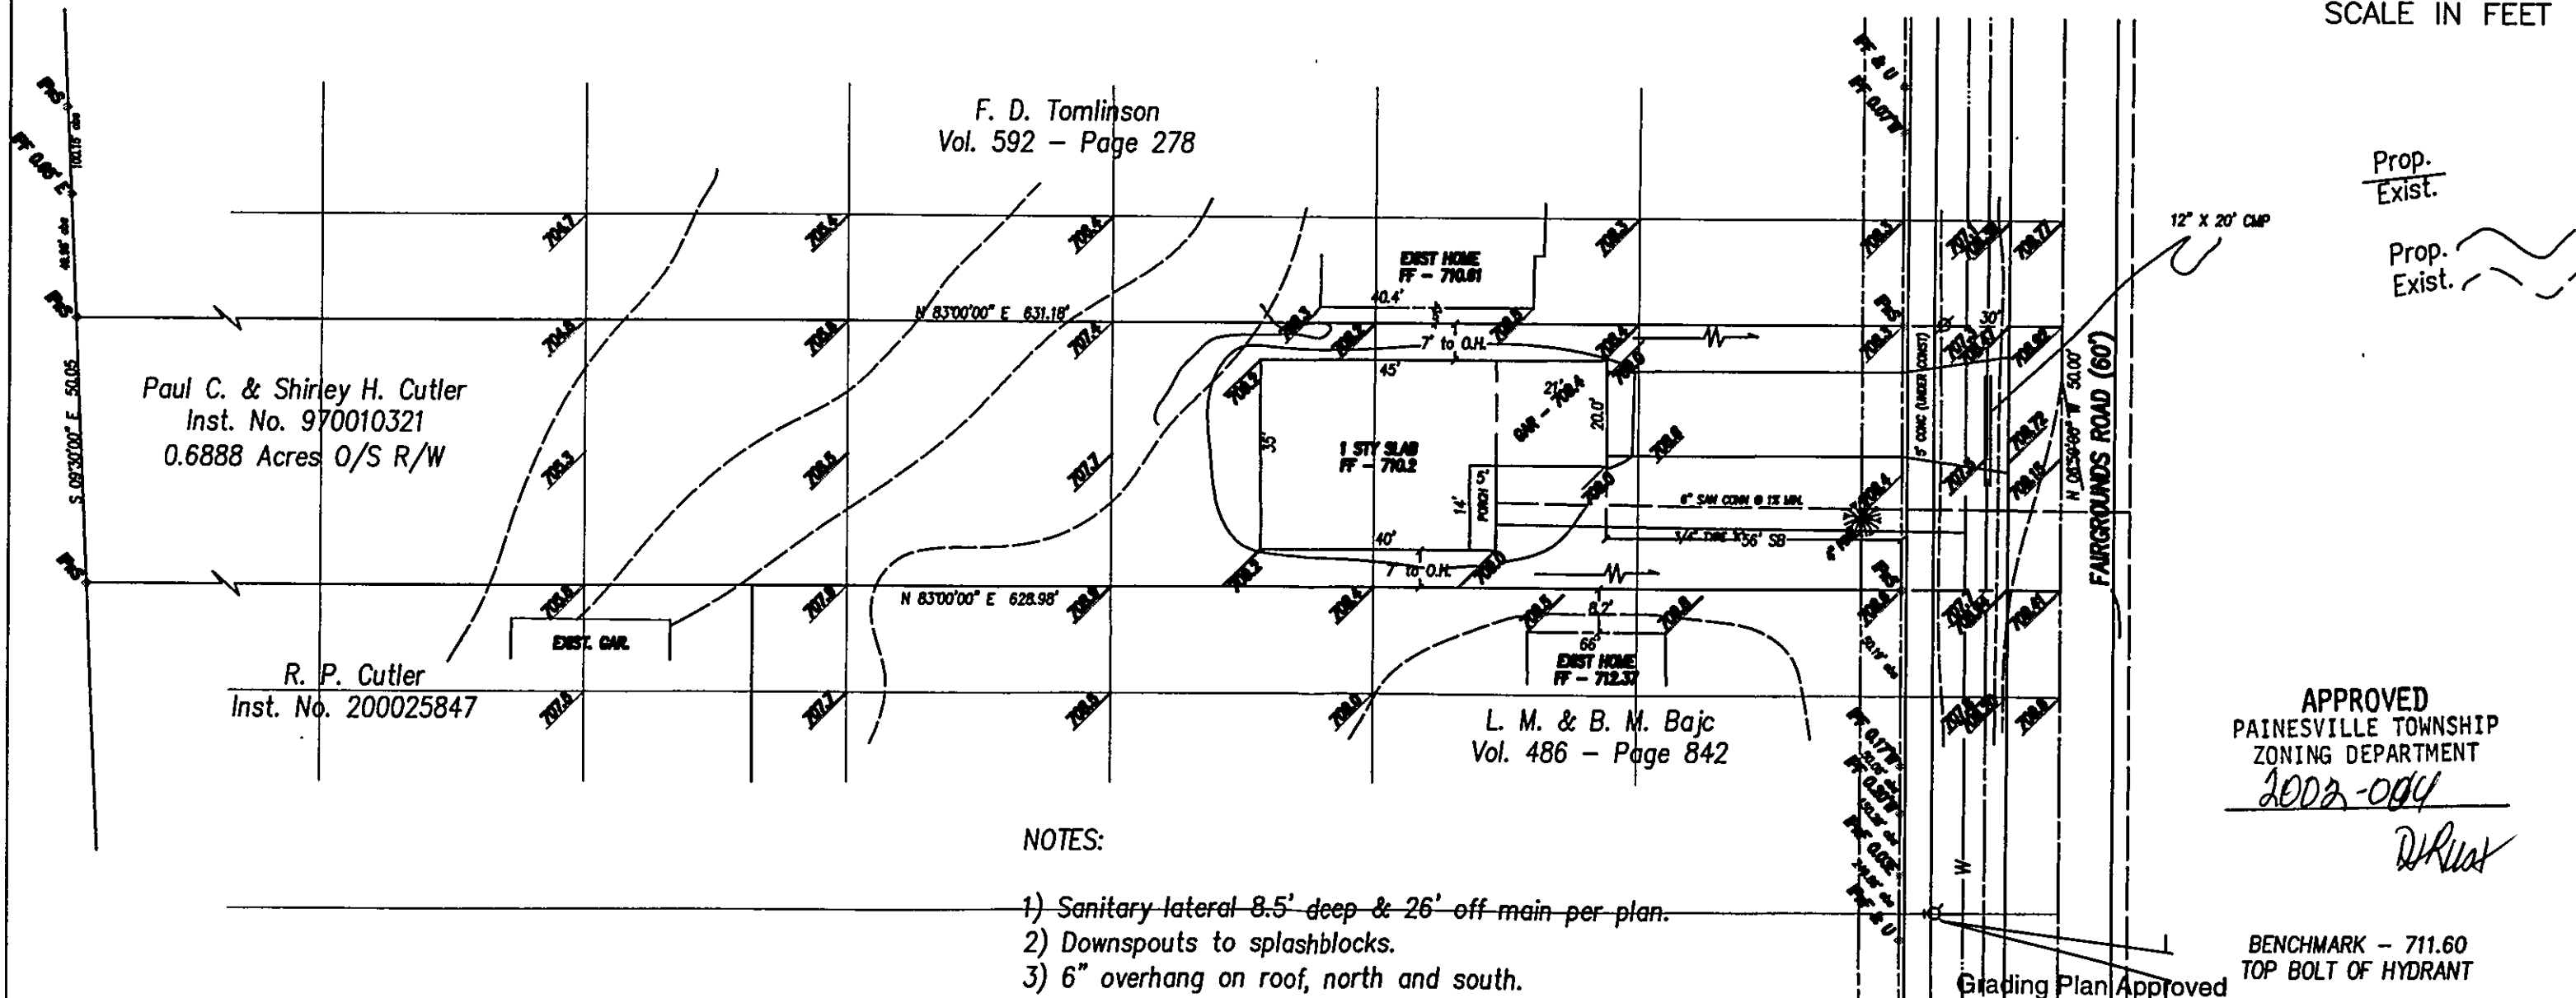

NOTES:

- 1) Sanitary lateral 8.5' deep & 26' off main per plan.
- 2) Downspouts to splashblocks.
- 3) 6" overhang on roof, north and south.

VILLAGE SURVEYING COMPANY
605 VILLA EAST DR., FAIRPORT HARBOR, OH 44077
(440) 357-1359 - CELL (440) 413-0527

APPROVED
PAINESVILLE TOWNSHIP
ZONING DEPARTMENT

2002-004

[Signature]

BENCHMARK - 711.60
TOP BOLT OF HYDRANT

Grading Plan Approved
as shown and/or noted
JAMES R. GILLS, P.E.
Lake County Engineer

By GJH Date 01/11/02
Scale as shown