
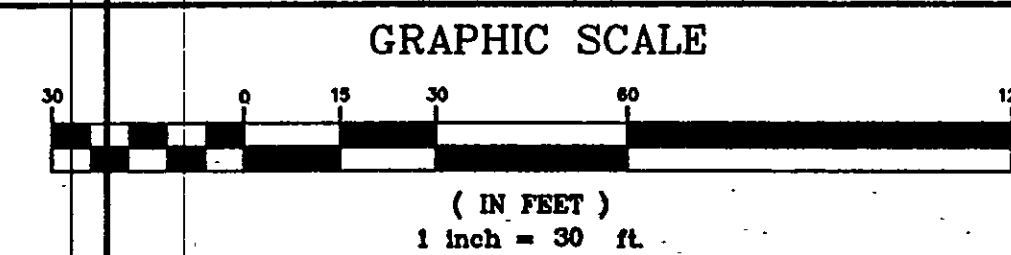


APPROVED
PAINESVILLE TOWNSHIP
ENGINEERING DEPARTMENT
12/28/96
P.J.K.

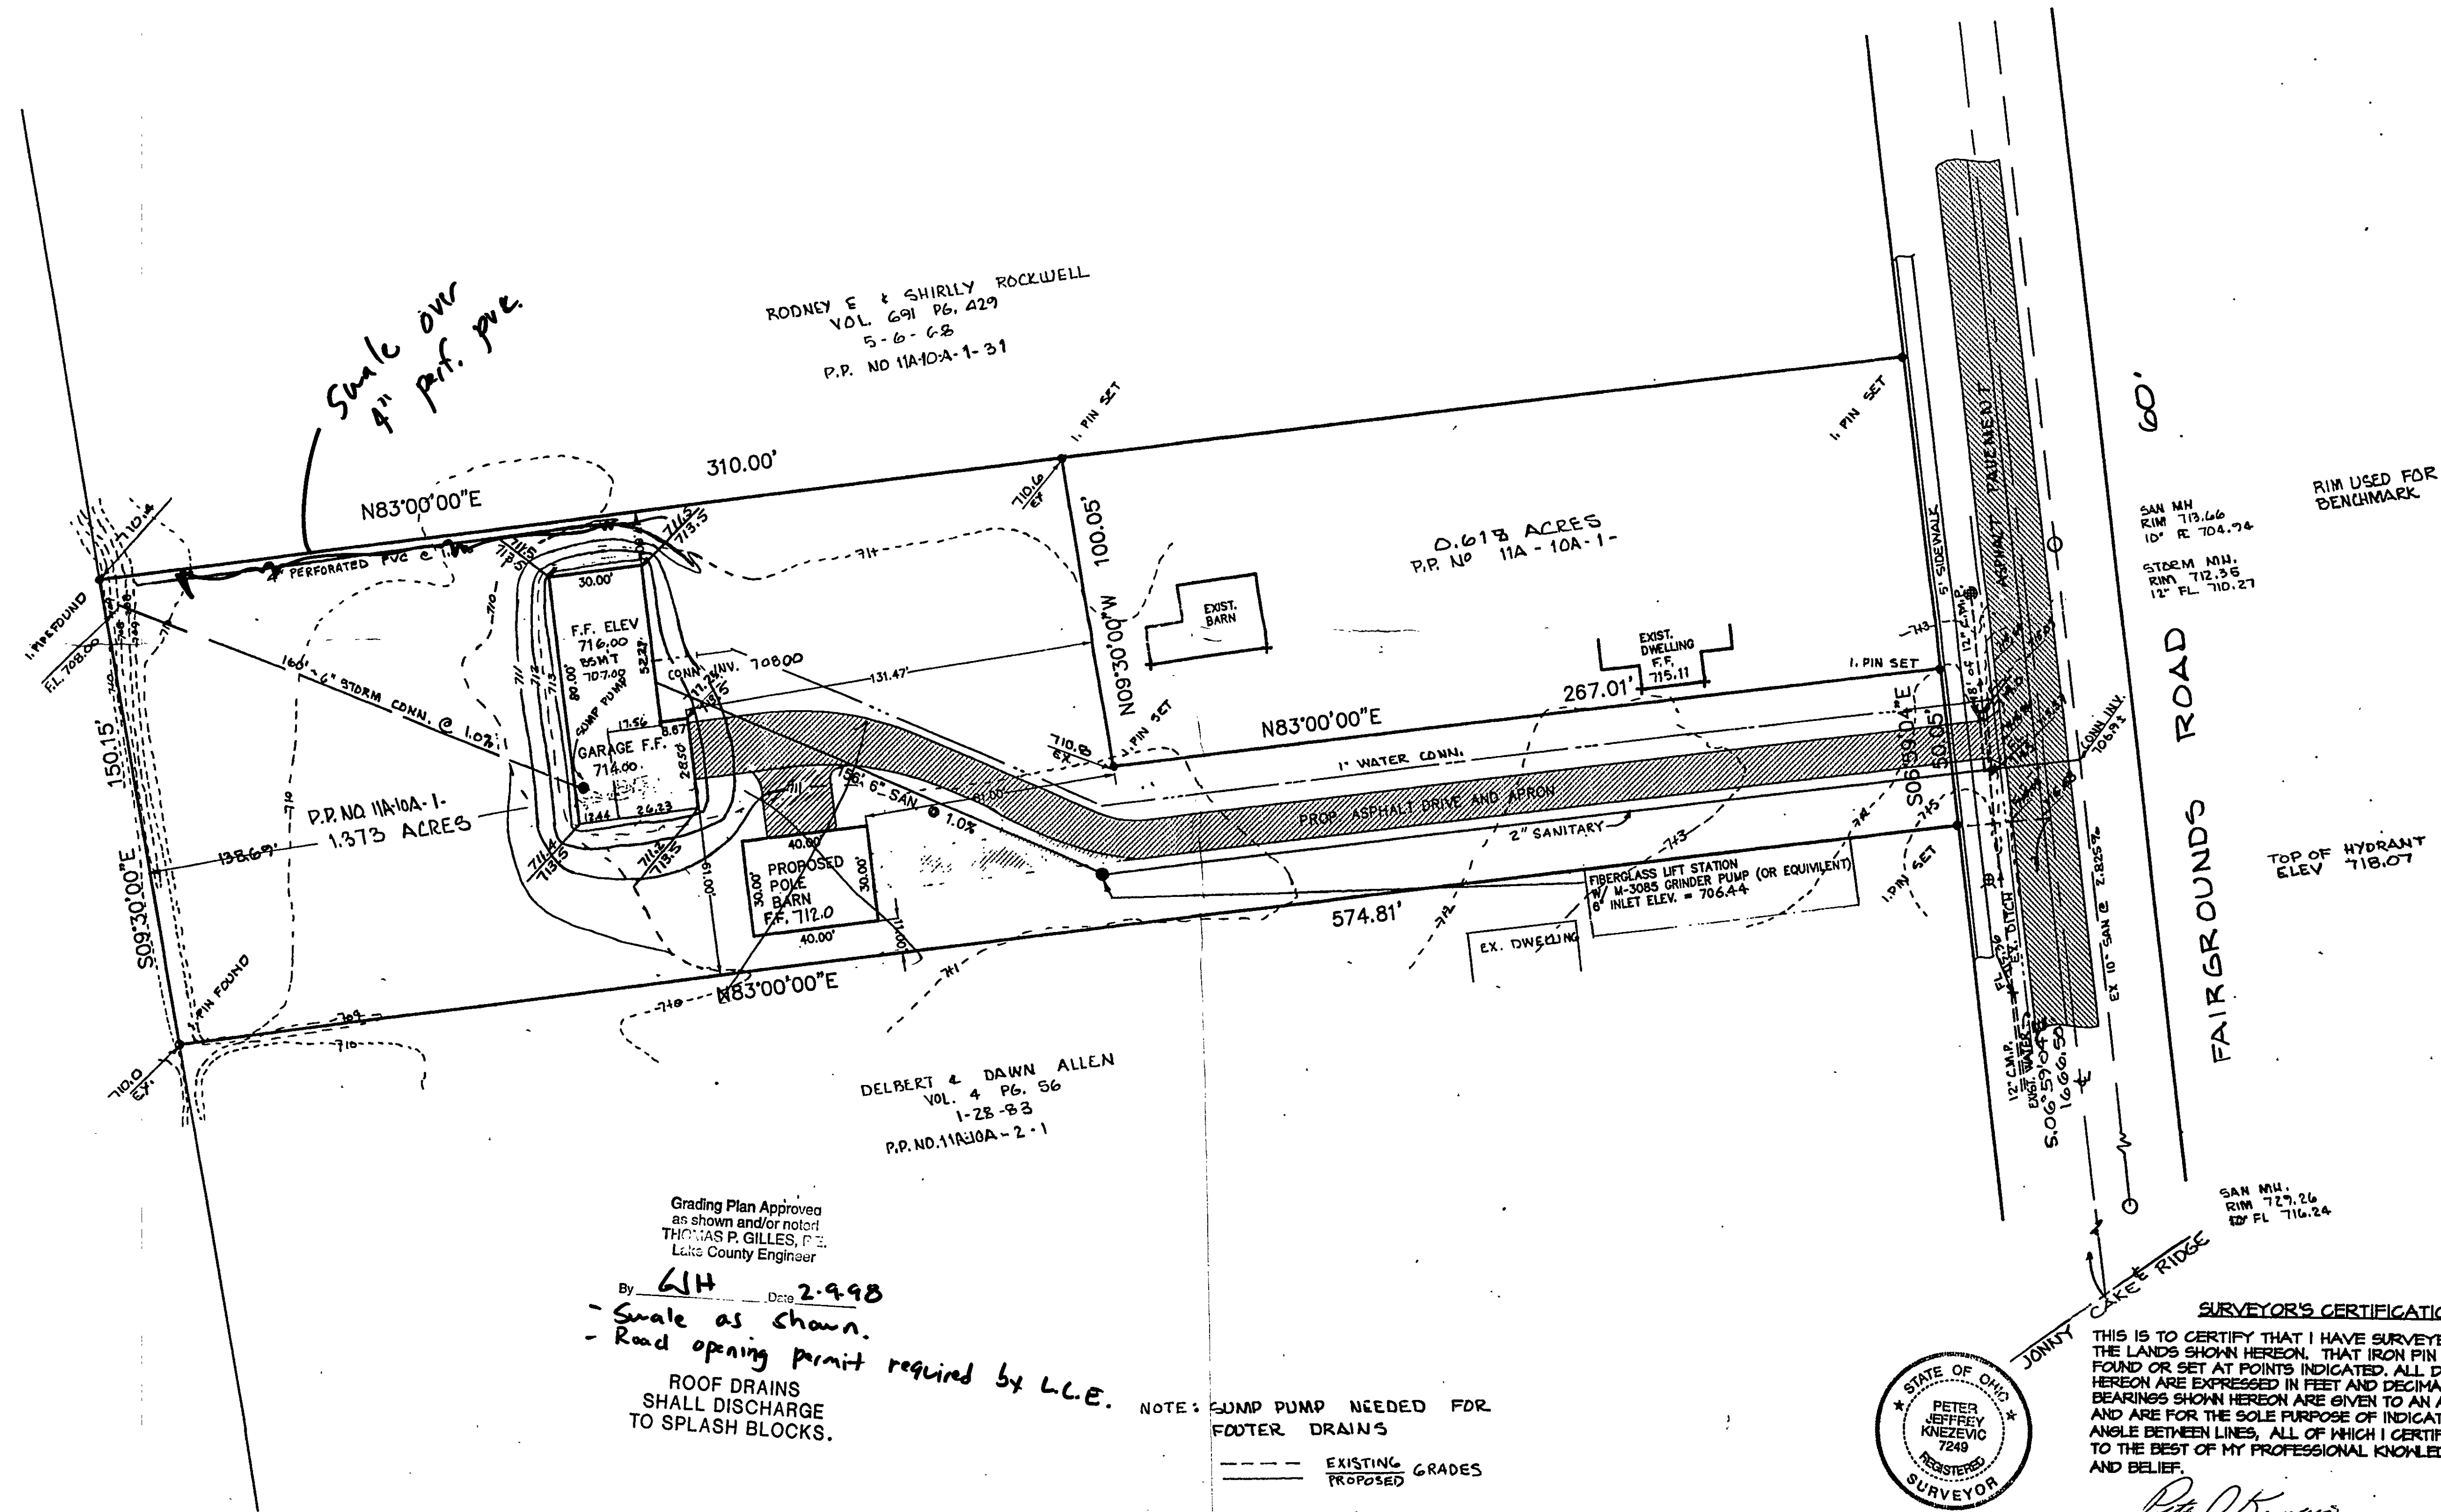

Rev. No.	Description	Date	By	CH'KD
1	REVISED HOUSE DIMENSIONS, PROPOSED GRADES, SAN. CONN.	12-27-97	D.G.	P.J.K.

SITUATED IN THE TOWNSHIP OF PAINESVILLE, COUNTY OF LAKE, STATE OF OHIO
AND SHOWN AS BEING A PART OF ORIGINAL LOT NO. 46, TRACT NO. 4

Drawn By D.G.
Filename:
Checked By P.J.K.
Approved By P.J.K.
Date: JANUARY-1998

SITE PLAN
for
BURT LOOMIS

Scale:	1" = 30'
HORIZ	1" = 30'
VERT	1" = 30'
Sheet No.	1 of 1