

SITE PLAN

PRINESVILLE LAKE COUNTY, OHIO

for: DAVE MURACO

OWNER

ADDRESS STREET CITY ZIP

HEATHER STUDE VILLAGE LOT TRACT

SUBDIVISION 2-35 NAME VOLUME PAGE

41 VOL. 15 FAIRWOOD CT. PERM. PARCEL NO. STREET

LEGEND

SANITARY MANHOLE --- WATER VALVE (GAS)
STORM MANHOLE --- WATER METER (GAS)
INLET OR CATCH BASIN --- AS BUILT ELEVATION
HYDRANT ---
EXISTING CONTOURS ---
PROPOSED CONTOURS ---
EXIST. ELEV. --- PROP. ELEV. ---
INDICATES DIRECTION OF SURFACE DRAINAGE

REMARKS

ALL BOUNDARY DATA SHOWN WAS OBTAINED FROM IDEEDS, RECORDED SUBDIVISION PLAT OR OTHER PUBLIC RECORDS
LOCATIONS AS SHOWN OF ADJACENT WELLS AND SEPTIC TANKS OBTAINED FROM LAKE COUNTY HEALTH DEPARTMENT

DESIGN CERTIFICATION

THIS PLAT WAS PREPARED BY ME, AND IS CORRECT TO THE BEST OF MY KNOWLEDGE AND BELIEF.

NAME SURVEYOR REGISTRATION NO.

CHECK LIST

NO. OF BEDROOMS
DIMENSIONS
SEAWALLS
TIE TO NEAREST STREET
SUBLOT NO. PARCEL NO.
SURROUNDING OWNERS
BLDG. DIMENSIONS FIN. GR.
BLDG. TIES FIN. GR.
PAV'T TYPE GRADE COURSE
APPROX. TYPE WIDTH THICKNESS
SIDEWALK TYPE DIA. LENGTH
ROCK OUTCROPPINGS
WATER MAIN SIZE, LOCATION
SAN. SEWER SIZE & OR LOC.
SAN. HW. CAST. ELEV. INV. ELEV.
SAN. CORR. SIZE LOC. DEPTH
STORM SEWER SIZE & OR LOC.
STORM HW. CAST. ELEV. INV. ELEV.
PAV'T TYPE GRADE COURSE
GAS LINE LOC. SIZE PRESSURE
SEPTIC TANK LOCATION & DUCTILATION AREA
WELL LOCATION
ISOLATION RADIUS FROM WELL

PLAN PREPARED BY:

REGISTERED SURVEYOR
172 NO. ST. CLAIR
PAINESVILLE, OHIO

NO.	DATE	BY
1		
2		
3		
4		
5		
6		

"AS BUILT" CERTIFICATION
I, HEREBY CERTIFY THAT THE CIRCLED GRADES ARE EXISTING FINISH GRADES CHECKED IN THE FIELD ON 19____ AND ARE CORRECT TO THE BEST OF MY KNOWLEDGE AND BELIEF.

REGISTERED SURVEYOR REG. NO.


SAN. FIN. ELEVATION TAKEN OFF OF PROPOSED IMPROVEMENT PLANS PER ENVIRONMENTAL ASSOC. INC. SOLON, OHIO

SANITARY MANHOLE #44
SAN. STA. AS BUILT
0+00 W. AT THE
INTERSECTION OF
DARTMOUTH DR. &
FAIRWOOD COURT

BENCHMARK:
AT FAIRWOOD &
DARTMOUTH (MH #44)

RIM EL. 707.06
INV. 699.59

FAIRWOOD COURT 60'

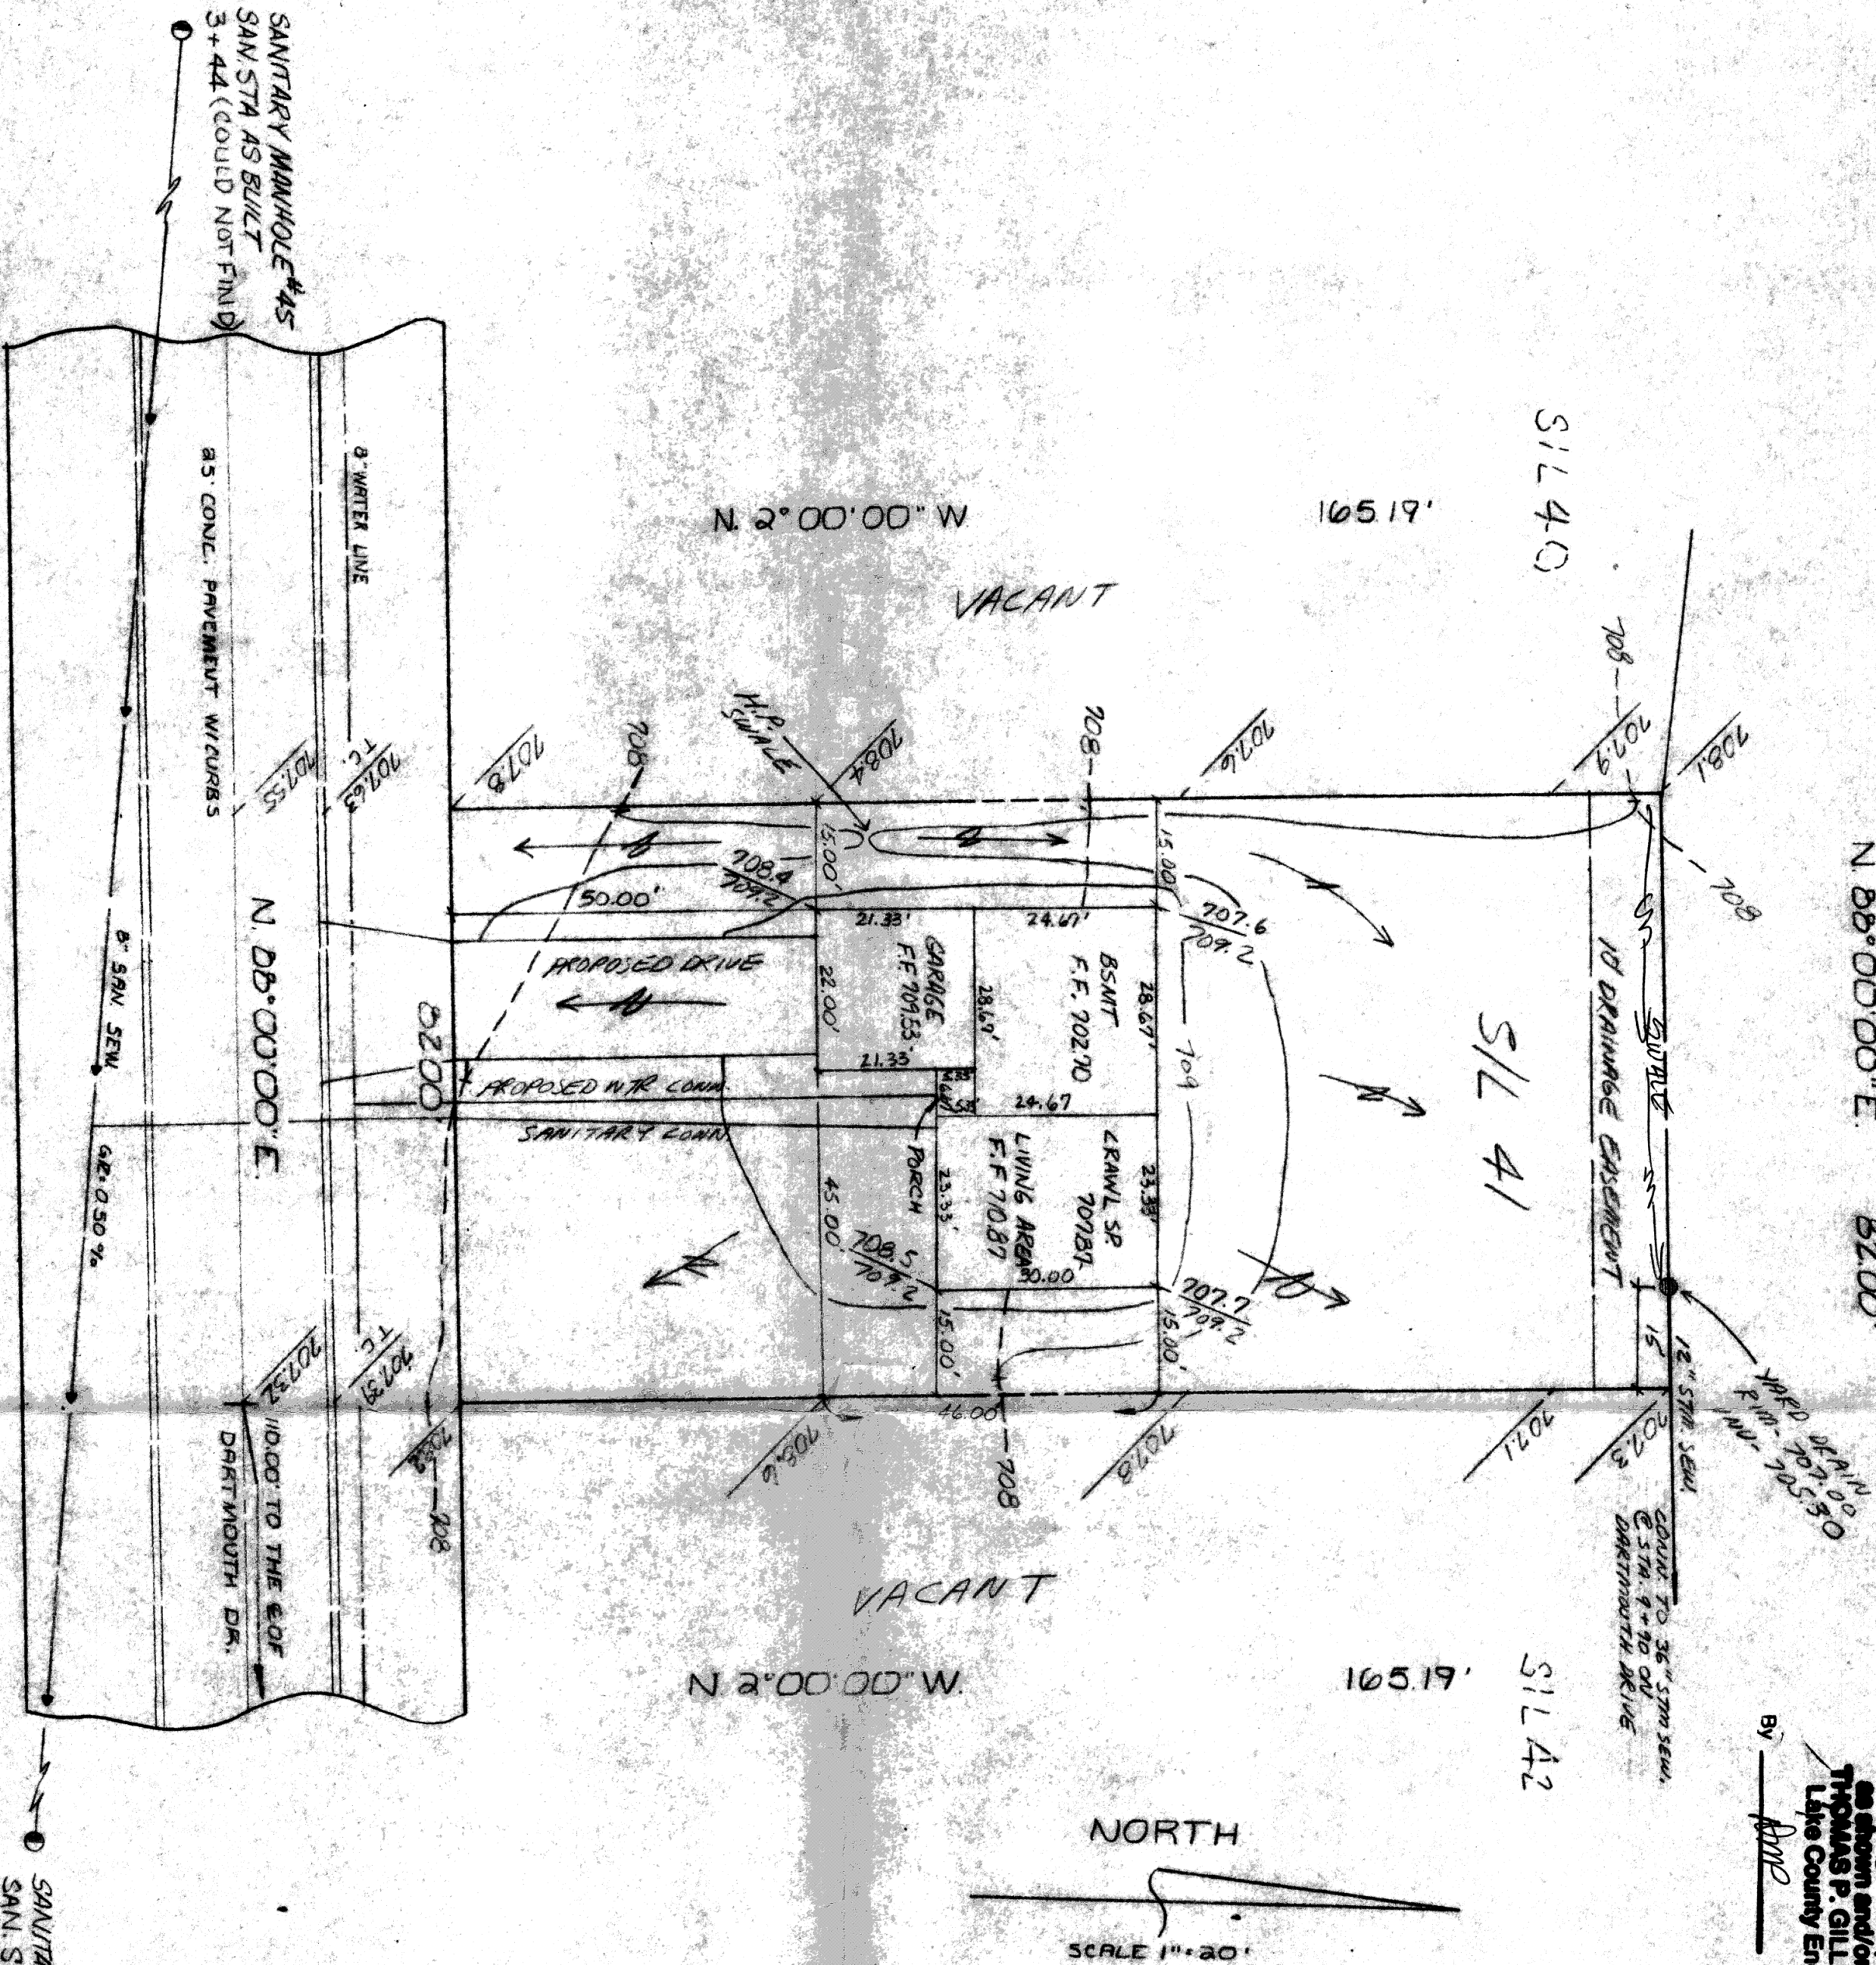

Grading Plan Approved
as shown and/or noted
THOMAS P. GILLES, P.E.
Lake County Engineer
By: *TPG* Date: 11-28