

SITE PLAN

PAINESVILLE TOWNSHIP
LAKE COUNTY, OHIO

FOR
M.M. BOGART DEVELOPMENT CORP

HEATHERSTONE SUBD
Vol. 2-35 Pg. 3

- LEGEND
- SANITARY MANHOLE
 - STORM MANHOLE
 - INLET OR CATCH BASIN
 - EXISTING CONTOUR
 - - - PROPOSED CONTOUR
 - AS BUILT ELEVATION
 - DIRECTION OF DRAINAGE


② CURVE DATA
A = 90.62'
C = 90.56'
Δ = 7°-34'-00"
Ch. Brg = S. 77°-45'-00" W.
R = 686.20'

David K. Mostoller R.S. #6949

I HEREBY CERTIFY THAT THE CIRCLED GRADES ARE EXISTING FINISH GRADES CHECKED IN THE FIELD ON 19____, AND ARE CORRECT TO THE BEST OF MY KNOWLEDGE AND BELIEF.

David K. Mostoller R.S. #6949

I HEREBY CERTIFY THAT THIS PLAN IS AN ACCURATE AND TRUE REPRESENTATION OF SAID PROPERTY.

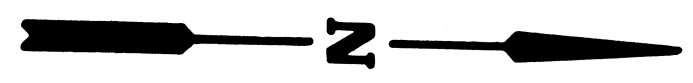

FISHER & ASSOCIATES INC.
ENGINEERS AND CONSULTANTS
SCALE: 1"=30'
DATE: OCT. 87

PREPARED BY:

Grading Plan Approved
as shown and/or noted
THOMAS P. GILLES, P.E.
Lake County Engineer
Date 10/14/87
Summ Firm Reviewed
This Permit Expires
10-13-88
PAINESVILLE TOWNSHIP
ZONING APPROVED
6912
W & M
Zoning Inspector 10/13/87

