

SITE PLAN

PAINESVILLE TOWNSHIP LAKE COUNTY, OHIO

for: Dick Arnold

ADDRESS: _____ STREET: _____ CITY: _____ ZIP: _____

SUBDIVISION	NAME	LOT	TRACT
VOL. NO.	18-650-13	19	4
SHEET NO.	13	13	13

LEGEND	
SANITARY MANHOLE	WATER VALVE (GAS)
STORM MANHOLE	WATER METER (GAS)
INLET OR CATCH BASIN	AS BUILT ELEVATION
HYDRANT	INDICATES DIRECTION OF SURFACE DRAINAGE
EXIST. ELEV.	
PROJ. ELEV.	

REMARKS


ALL BOUNDARY DATA SHOWN WAS OBTAINED FROM IDEEDS, RECORDED SUBDIVISION PLAT OR OTHER PUBLIC RECORDS.

LOCATIONS AS SHOWN OF ADJACENT WELLS AND SEPTIC TANKS OBTAINED FROM LAKE COUNTY HEALTH DEPARTMENT

DESIGN CERTIFICATION

THIS PLAT WAS PREPARED BY ME, AND IS CORRECT TO THE BEST OF MY KNOWLEDGE AND BELIEF

NAME: Harry S. Jones, Jr. SURVEYOR REGISTRATION NO. 56343

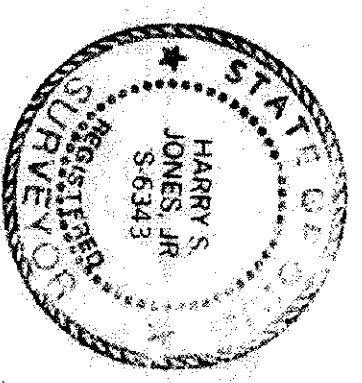

NO. OF BEDROOMS	WATER MAIN SIZE	LOCATION
DIMENSIONS	SAN. SEWER SIZE	% GR. LOC.
BEARINGS	SAN. MH. CAST. ELEV.	INV. ELEV.
THE TO NEAREST STREET	SAN. CONN. SIZE	LOC. DEPTH
SUBJECT NO. PARCEL NO.	STORM SEWER SIZE	% GR. LOC.
SURROUNDING OWNERS	STORM MH. CAST. ELEV.	INV. ELEV.
BLDG. DIMENSIONS FIN. GR.	PAYT. TYPE GRADE CURBS	
BLDG. TIES P.L.T. GRADES	GAS LINE LOC. SIZE PRESSURE	
APPROX. TYPE WIDTH THICKNESS	SEPTIC TANK LOCATION & DUPLICATION AREA	
SEPTIC TANK TYPE DIA. LENGTH	WELL LOCATION	
ROCK OUTCROPPINGS	ISOLATION RADII FROM WELL	

NO.	DATE	BY	PLAN PREPARED BY:
1			BABCOCK • JONES & ASSOCIATES, INC.
2			PAINESVILLE, OHIO
3			SCALE 1" = 20'
4			DATE 6/16/91
5			PHONE NO. 357-1811

"AS BUILT" CERTIFICATION

I, HEREBY CERTIFY THAT THE CIRCLED GRADES ARE EXISTING FINISH GRADES CHECKED IN THE FIELD ON 19 91

AND ARE CORRECT TO THE BEST OF MY KNOWLEDGE AND BELIEF.

REGISTERED SURVEYOR REG. NO.

TBM - RIM SAN. MH
ELEV. = 606.08

This Permit Expires 6/16/92

PAINESVILLE TOWNSHIP ZONING APPROVED

7886 D. J. D. J.

Grading Plan Approved as shown and/or noted THOMAS P. GILLES, P.E. Lake County Engineer

By GSH Date 6-17-91

Zoning Inspector

