


Grading Plan Approved  
as shown and/or noted  
THOMAS P. GILLES, P.E.  
Lake County Engineer  
By Tam Date 4/20/2000  
EXTEND DRIVE ABOUT  
SWALE AS SHOWN

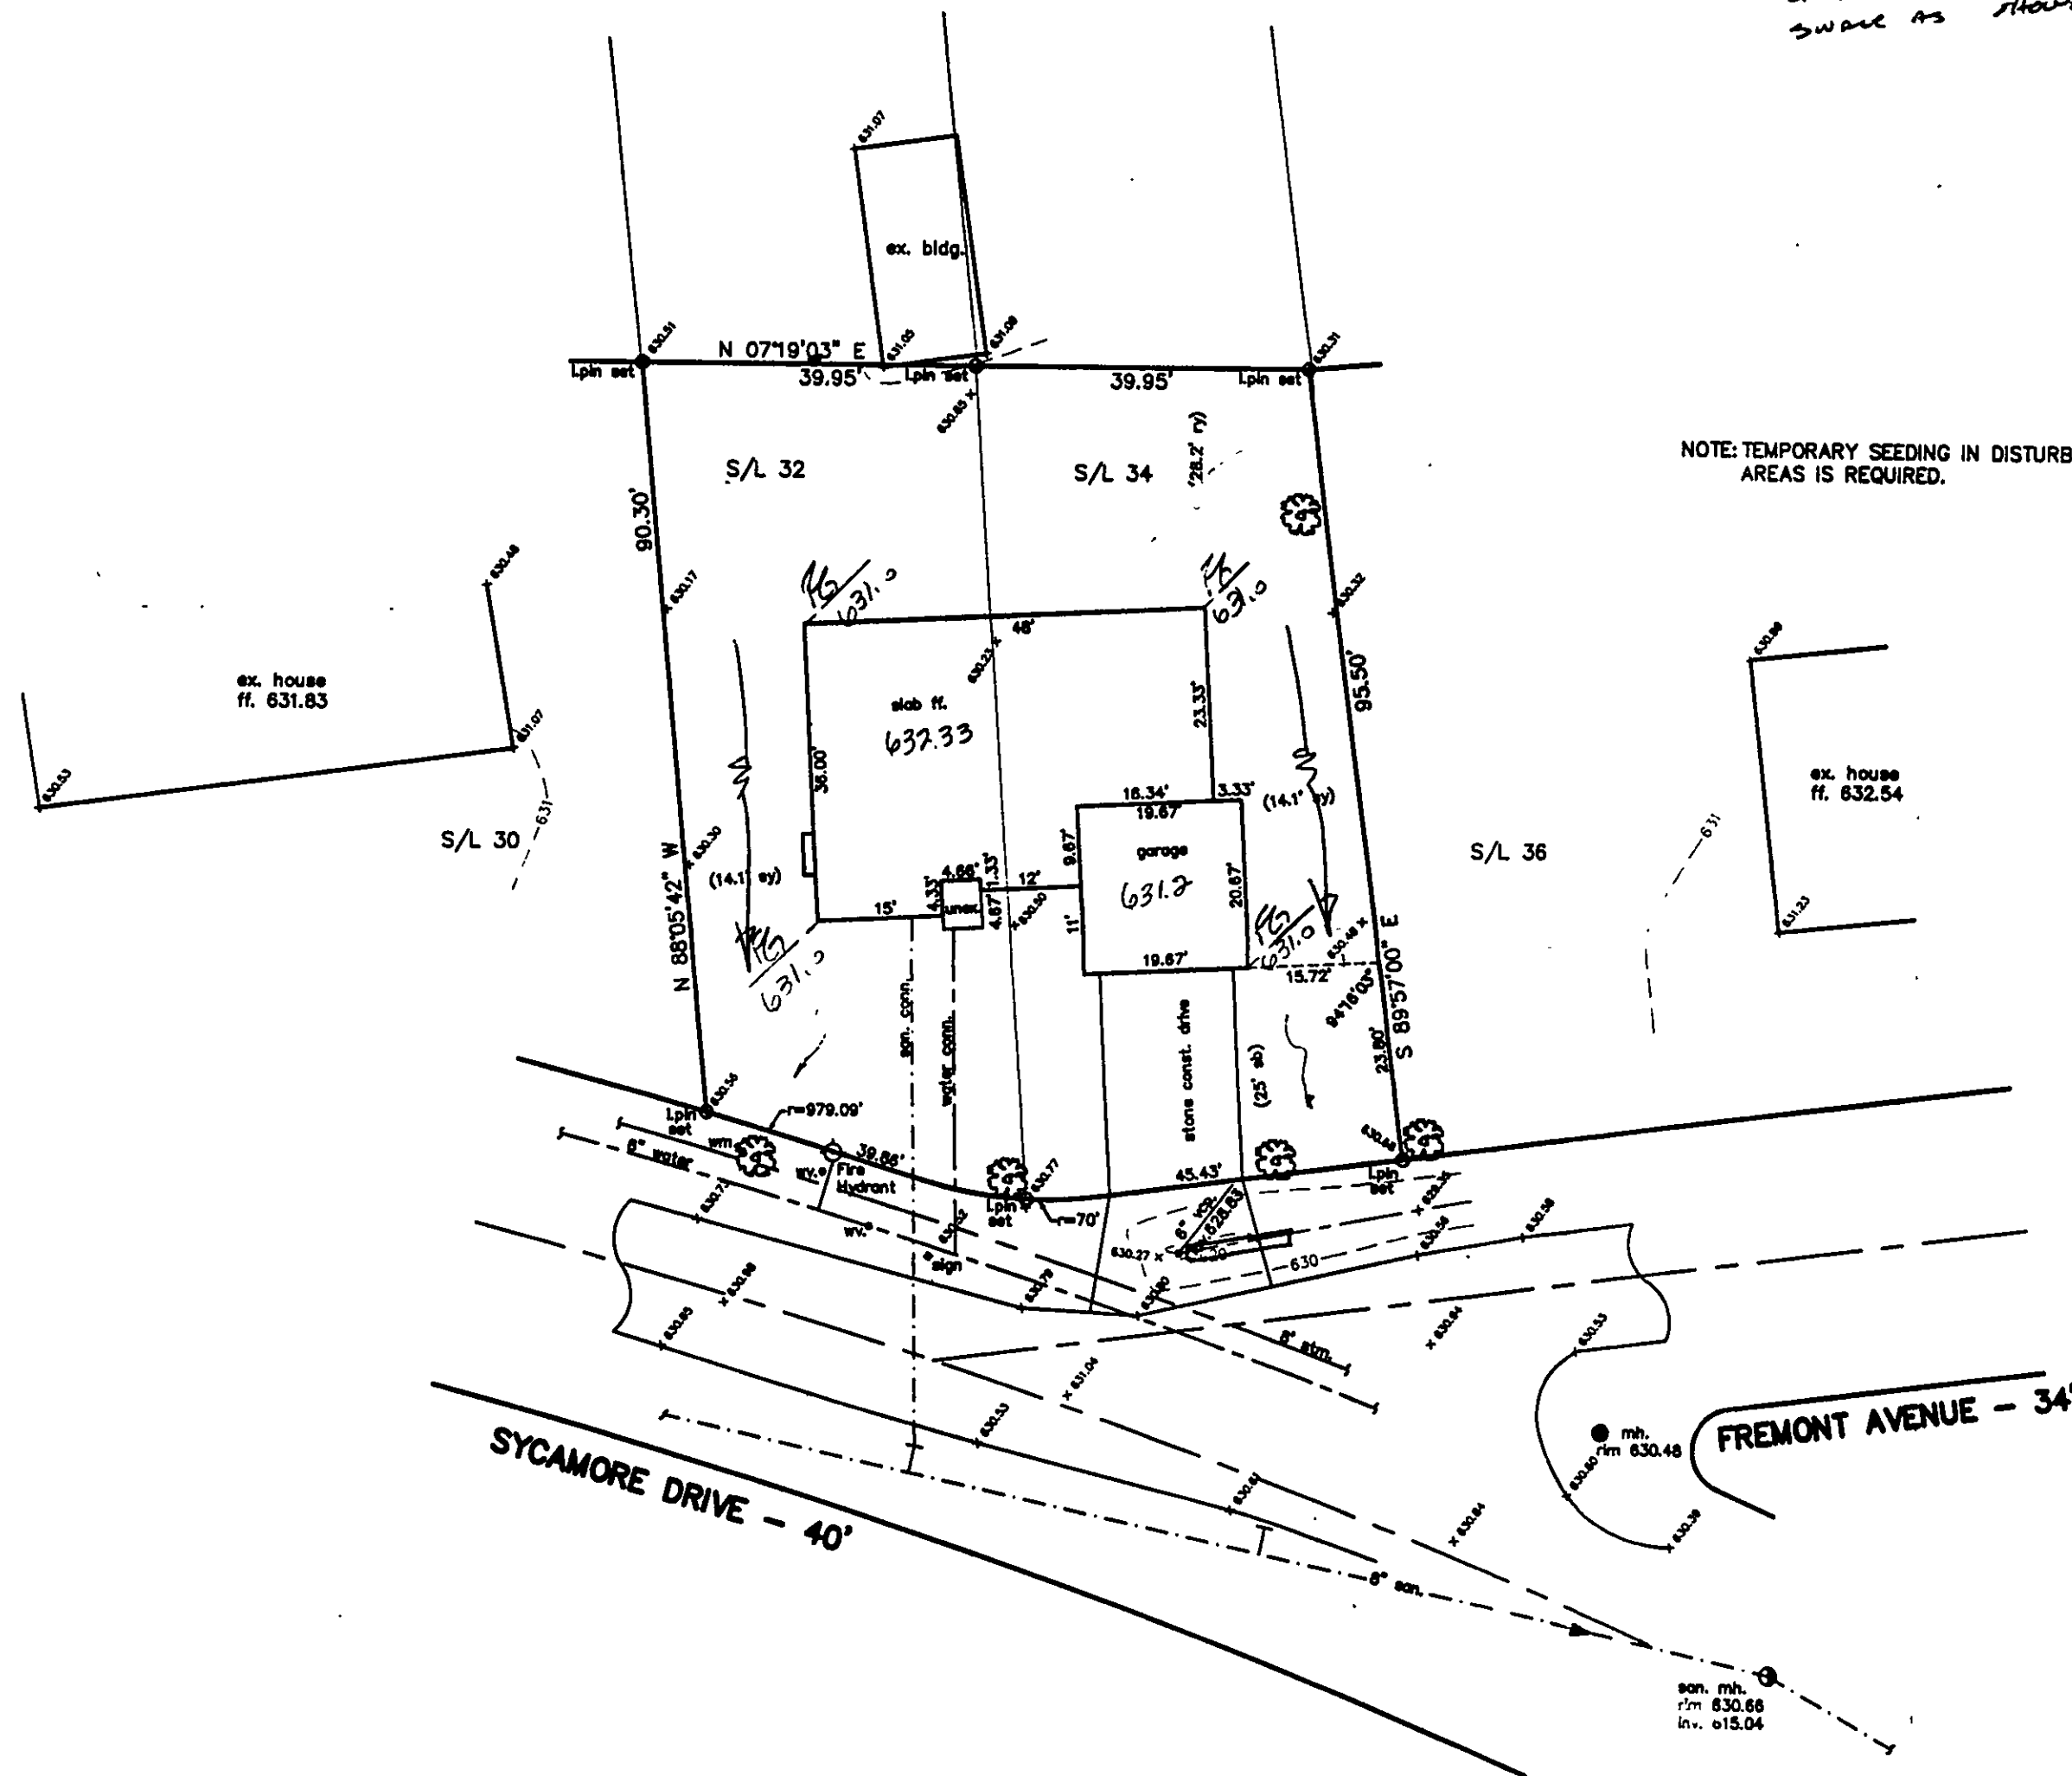

## SITE PLAN

PAINESVILLE TWP., LAKE COUNTY, OHIO

for: LENNIE WINTERS

CLIENT: \_\_\_\_\_ OWNER: \_\_\_\_\_  
ADDRESS: \_\_\_\_\_ STREET: \_\_\_\_\_ CITY: \_\_\_\_\_ ZIP: \_\_\_\_\_  
SUBDIVISION: D-13 NAME: \_\_\_\_\_ TRACT: \_\_\_\_\_ STREET: \_\_\_\_\_  
VOL.-PG. SYCAMORE DRIVE LOT: \_\_\_\_\_  
SUBLOT NO. STREET VOL.-PG. PERM. PARCEL NO.

### LEGEND

SANITARY MANHOLE --- ○ --- EXIST. ELEV. --- 100.0  
STORM MANHOLE --- ● --- 100.0 ± 2' PROP. ELEV.  
INLET OR CATCH BASIN --- □ --- AS BUILT ELEVATION  
HYDRANT --- ⊕ --- INDICATES  
EXISTING CONTOURS --- --- DIRECTION OF  
PROPOSED CONTOURS --- --- SURFACE DRAINAGE

### REMARKS

ALL BOUNDARY DATA SHOWN WAS OBTAINED FROM (DEEDS, RECORDED SUBDIVISION PLAT OR OTHER PUBLIC RECORDS)

LOCATIONS AS SHOWN OF ADJACENT WELLS AND SEPTIC TANKS OBTAINED FROM LAKE COUNTY HEALTH DEPARTMENT

### DESIGN CERTIFICATION

THIS PLAT WAS PREPARED BY ME, AND IS CORRECT TO THE BEST OF MY KNOWLEDGE AND BELIEF.

NAME: Harry S. Jones, Jr. SURV. REG. NO. 6343

### CHECK LIST

NO. OF BEDROOMS  
DIMENSIONS  
BEARINGS  
TIE TO NEAREST STREET  
SUBLOT NO. PARCEL NO.  
SURROUNDING OWNERS  
BLDG. DIMENSIONS FIN GR.  
BLDG. TIES FL'R. GRADES  
APRON TYPE WIDTH THICKNESS  
SIDEWALK TYPE WIDTH THICKNESS  
CULVERT TYPE DIA. LENGTH  
ROCK OUTCROPPINGS

WATER MAIN SIZE, LOCATION  
SAN. SEWER SIZE & GR. LOC.  
SAN. MH. CAST. ELEV. INV. ELEV.  
SAN. CONN. SIZE, LOC. DEPTH  
STORM SEWER SIZE & GR. LOC.  
STORM MH. CAST. ELEV. INV. ELEV.  
PAV'T TYPE GRADE CURVES  
GAS LINE LOC. SIZE PRESSURE  
SEPTIC TANK LOCATION & DUPLICATION AREA  
WELL LOCATION  
ISOLATION RADIUS FROM WELL

REVISIONS			PLAN PREPARED BY:	
NO.	DATE	BY	bj BABCOCK - JONES & ASSOCIATES, INC.	
1			PAINESVILLE, OHIO	
2			DRAWN BY T.R.	SCALE 1"=20'
3			CHK'D. H.J.	DATE 3/6/00
4			CREW CHIEF W.B.	APP'D H.J.
5				

"AS BUILT" CERTIFICATION  
I, HEREBY CERTIFY THAT THE CIRCLED GRADES ARE EXISTING  
FINISH GRADES CHECKED IN THE FIELD ON \_\_\_\_\_, 20\_\_\_\_  
AND ARE CORRECT TO THE BEST OF MY KNOWLEDGE AND BELIEF.

REGISTERED SURVEYOR

REG. NO.

TBM-TOP OF HYDRANT  
ELEV.=632.89

APPROVED  
PAINESVILLE TOWNSHIP  
ZONING DEPARTMENT  
2000-06-2  
D. R. Jones

