

EROSION CONTROL PLAN & SCHEDULE

SILT FENCE TO BE INSTALLED PRIOR TO ANY EARTHWORK ACTIVITY, IN LOCATION SHOWN ON PLANS, PER DETAIL.

STONE SHALL BE INSTALLED IN FUTURE DRIVEWAY AREA 20 FEET WIDE AND 50 FEET LONG TO PREVENT VEHICLES FROM TRACKING SEDIMENT OFF THIS SITE INGRESS AND EGRESS TO BE LIMITED TO THIS AREA ONLY.

SEDIMENT CONTROL PRACTICES SHALL BE FUNCTIONAL THROUGHOUT ALL PHASES OF EARTH DISTURBING ACTIVITY, SETTLING FACILITIES, PERMETER CONTROLS, AND OTHER PRACTICES INTENDED TO TRAP SEDIMENT SHALL BE IMPLEMENTED AS THE FIRST STEP OF GRADING AND WITHIN SEVEN (7) DAYS FROM THE START OF GRUBBING. THEY SHALL CONTINUE TO FUNCTION UNTIL THE DISTURBED AREA IS PERMANENTLY RESTABILIZED.

DISTURBED AREAS SHALL HAVE SOIL STABILIZATION WITHIN NO MORE THAN SEVEN (7) DAYS IF THEY ARE TO REMAIN DORMANT UNDISTURBED FOR MORE THAN THIRTY-FIVE (35) DAYS. PERMANENT OR TEMPORARY SOIL STABILIZATION SHALL BE APPLIED TO DISTURBED AREAS WITHIN NO MORE THAN SEVEN (7) DAYS AFTER FINAL GRADE IS REACHED ON ANY PORTION OF THE SITE, AND SHALL ALSO BE APPLIED WITHIN NO MORE THAN SEVEN (7) DAYS TO DISTURBED AREAS WHICH MAY NOT BE AT FINAL GRADE, BUT WILL REMAIN DORMANT FOR LONGER THAN THIRTY-FIVE (35) DAYS.

STABILIZATION OF CRITICAL AREAS WITHIN 50 FEET OF ANY STREAM OR WETLAND SHALL BE TEMPORARILY STABILIZED WITHIN TWO (2) DAYS OF DISTURBANCE IF AREA WILL REMAIN INACTIVE FOR FOURTEEN (14) DAYS OR LONGER. CONSTRUCTION VEHICLES SHALL AVOID STREAMS AND THEIR BUFFER AREAS IF ANY ACTIVE DRAINAGE WAY MUST BE CROSSED BY CONSTRUCTION VEHICLES REPEATEDLY DURING CONSTRUCTION, AN APPROVED TEMPORARY STREAM CROSSING SHALL BE CONSTRUCTED.

SOIL STOCKPILES SHALL BE STABILIZED OR PROTECTED TO PREVENT SOIL LOSS. STABILIZATION SHALL BE REQUIRED IF STOCKPILES ARE LOCATED WITHIN CRITICAL AREAS NEAR STREAM OR WETLANDS, OR IF DETERMINED BY THE ADMINISTRATOR THAT SEDIMENT FROM STOCKPILES WILL LEAVE THE SITE.

SEDIMENT AND EROSION CONTROLS SHALL BE INSPECTED BY THE OWNER OR HIS/HER AGENT EVERY SEVEN (7) DAYS AND WITHIN 24 HOURS OF A 0.5" OR GREATER RAINFALL EVENT. A WRITTEN LOG OF THESE INSPECTIONS AND UPDATES TO CONTROLS SHALL BE KEPT ON SITE. THESE INSPECTIONS SHALL INCLUDE THE DATE OF INSPECTION, NAME OF INSPECTOR, WEATHER CONDITIONS, THE ACTIONS TAKEN TO CORRECT ANY PROBLEMS, AND THE DATE ACTIONS WERE TAKEN.

MEASURES SHALL BE TAKEN TO PREVENT SOIL TRANSPORT ONTO SURFACES WHERE RUNOFF IS NOT CHECKED BY SEDIMENT CONTROLS, OR ONTO PUBLIC ROADS. WHERE SOIL IS TRANSPORTED ONTO A PUBLIC ROAD SURFACE, THE ROADS SHALL BE CLEANED THOROUGHLY AT THE END OF EACH DAY, OR MORE FREQUENTLY AS NECESSARY. SOIL SHALL BE REMOVED FROM PAVED SURFACES BY SHOVELING OR SWEEPING. STREET WASHING SHALL BE ALLOWED ONLY AFTER MOST SEDIMENT HAS BEEN REMOVED BY SHOVELING OR SWEEPING.

THE ABOVE SPECIFIED EROSION CONTROL STANDARDS ARE GENERAL GUIDELINES AND SHALL NOT LIMIT THE RIGHT OF THE COUNTY TO IMPOSE, AT ANY TIME, ADDITIONAL, MORE STRINGENT REQUIREMENTS, NOR SHALL THE STANDARDS LIMIT THE RIGHT OF THE COUNTY TO WAIVE, IN WRITING, INDIVIDUAL REQUIREMENTS.


PERMANENT SEEDING TO BE INSTALLED AFTER ALL CONSTRUCTION ACTIVITY IS COMPLETE.

SEEDING AND MULCHING NOTES

SEDIMENT CONTROL SHALL BE ACCOMPLISHED BY SEEDING AND MULCHING IMMEDIATELY UPON COMPLETION OF EXCAVATION OF FILL AND FINISHED GRADING IN ACCORDANCE WITH ITEM NO. 650 CDDT CONSTRUCTION AND MATERIAL SPECIFICATIONS OR AS DIRECTED BY THE ENGINEER.

THE FOLLOWING MIXTURE SHALL BE USED FOR SEEDING IN ACCORDANCE WITH CDDT ITEM 650:

KENTUCKY BLUE GRASS-- 40%
CREEPING RED FESCUE-- 40% 3#/ 1000 S.F.
PERENNIAL RYEGRASS-- 20%
FERTILIZER-- 20#/ 1000 S.F. (12-12-12)
MULCH--STRAW/ 3 TONS/ ACRE

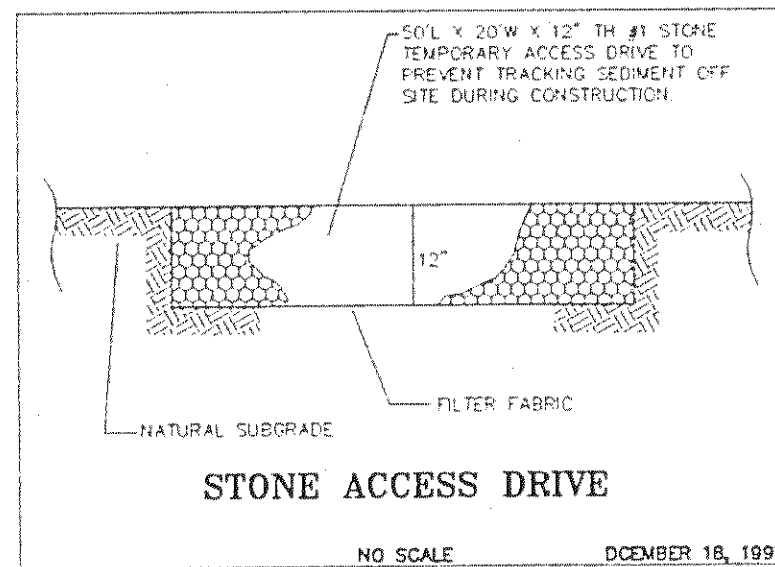

STONE ACCESS DRIVE

NO SCALE DECEMBER 18, 1997


1 STORY HOUSE
RIM 631.61
INV. 631.65

2 CAR GAR.
FLR. 631.61

1 STORY HOUSE
FLR. 632.70

631.57

631.37

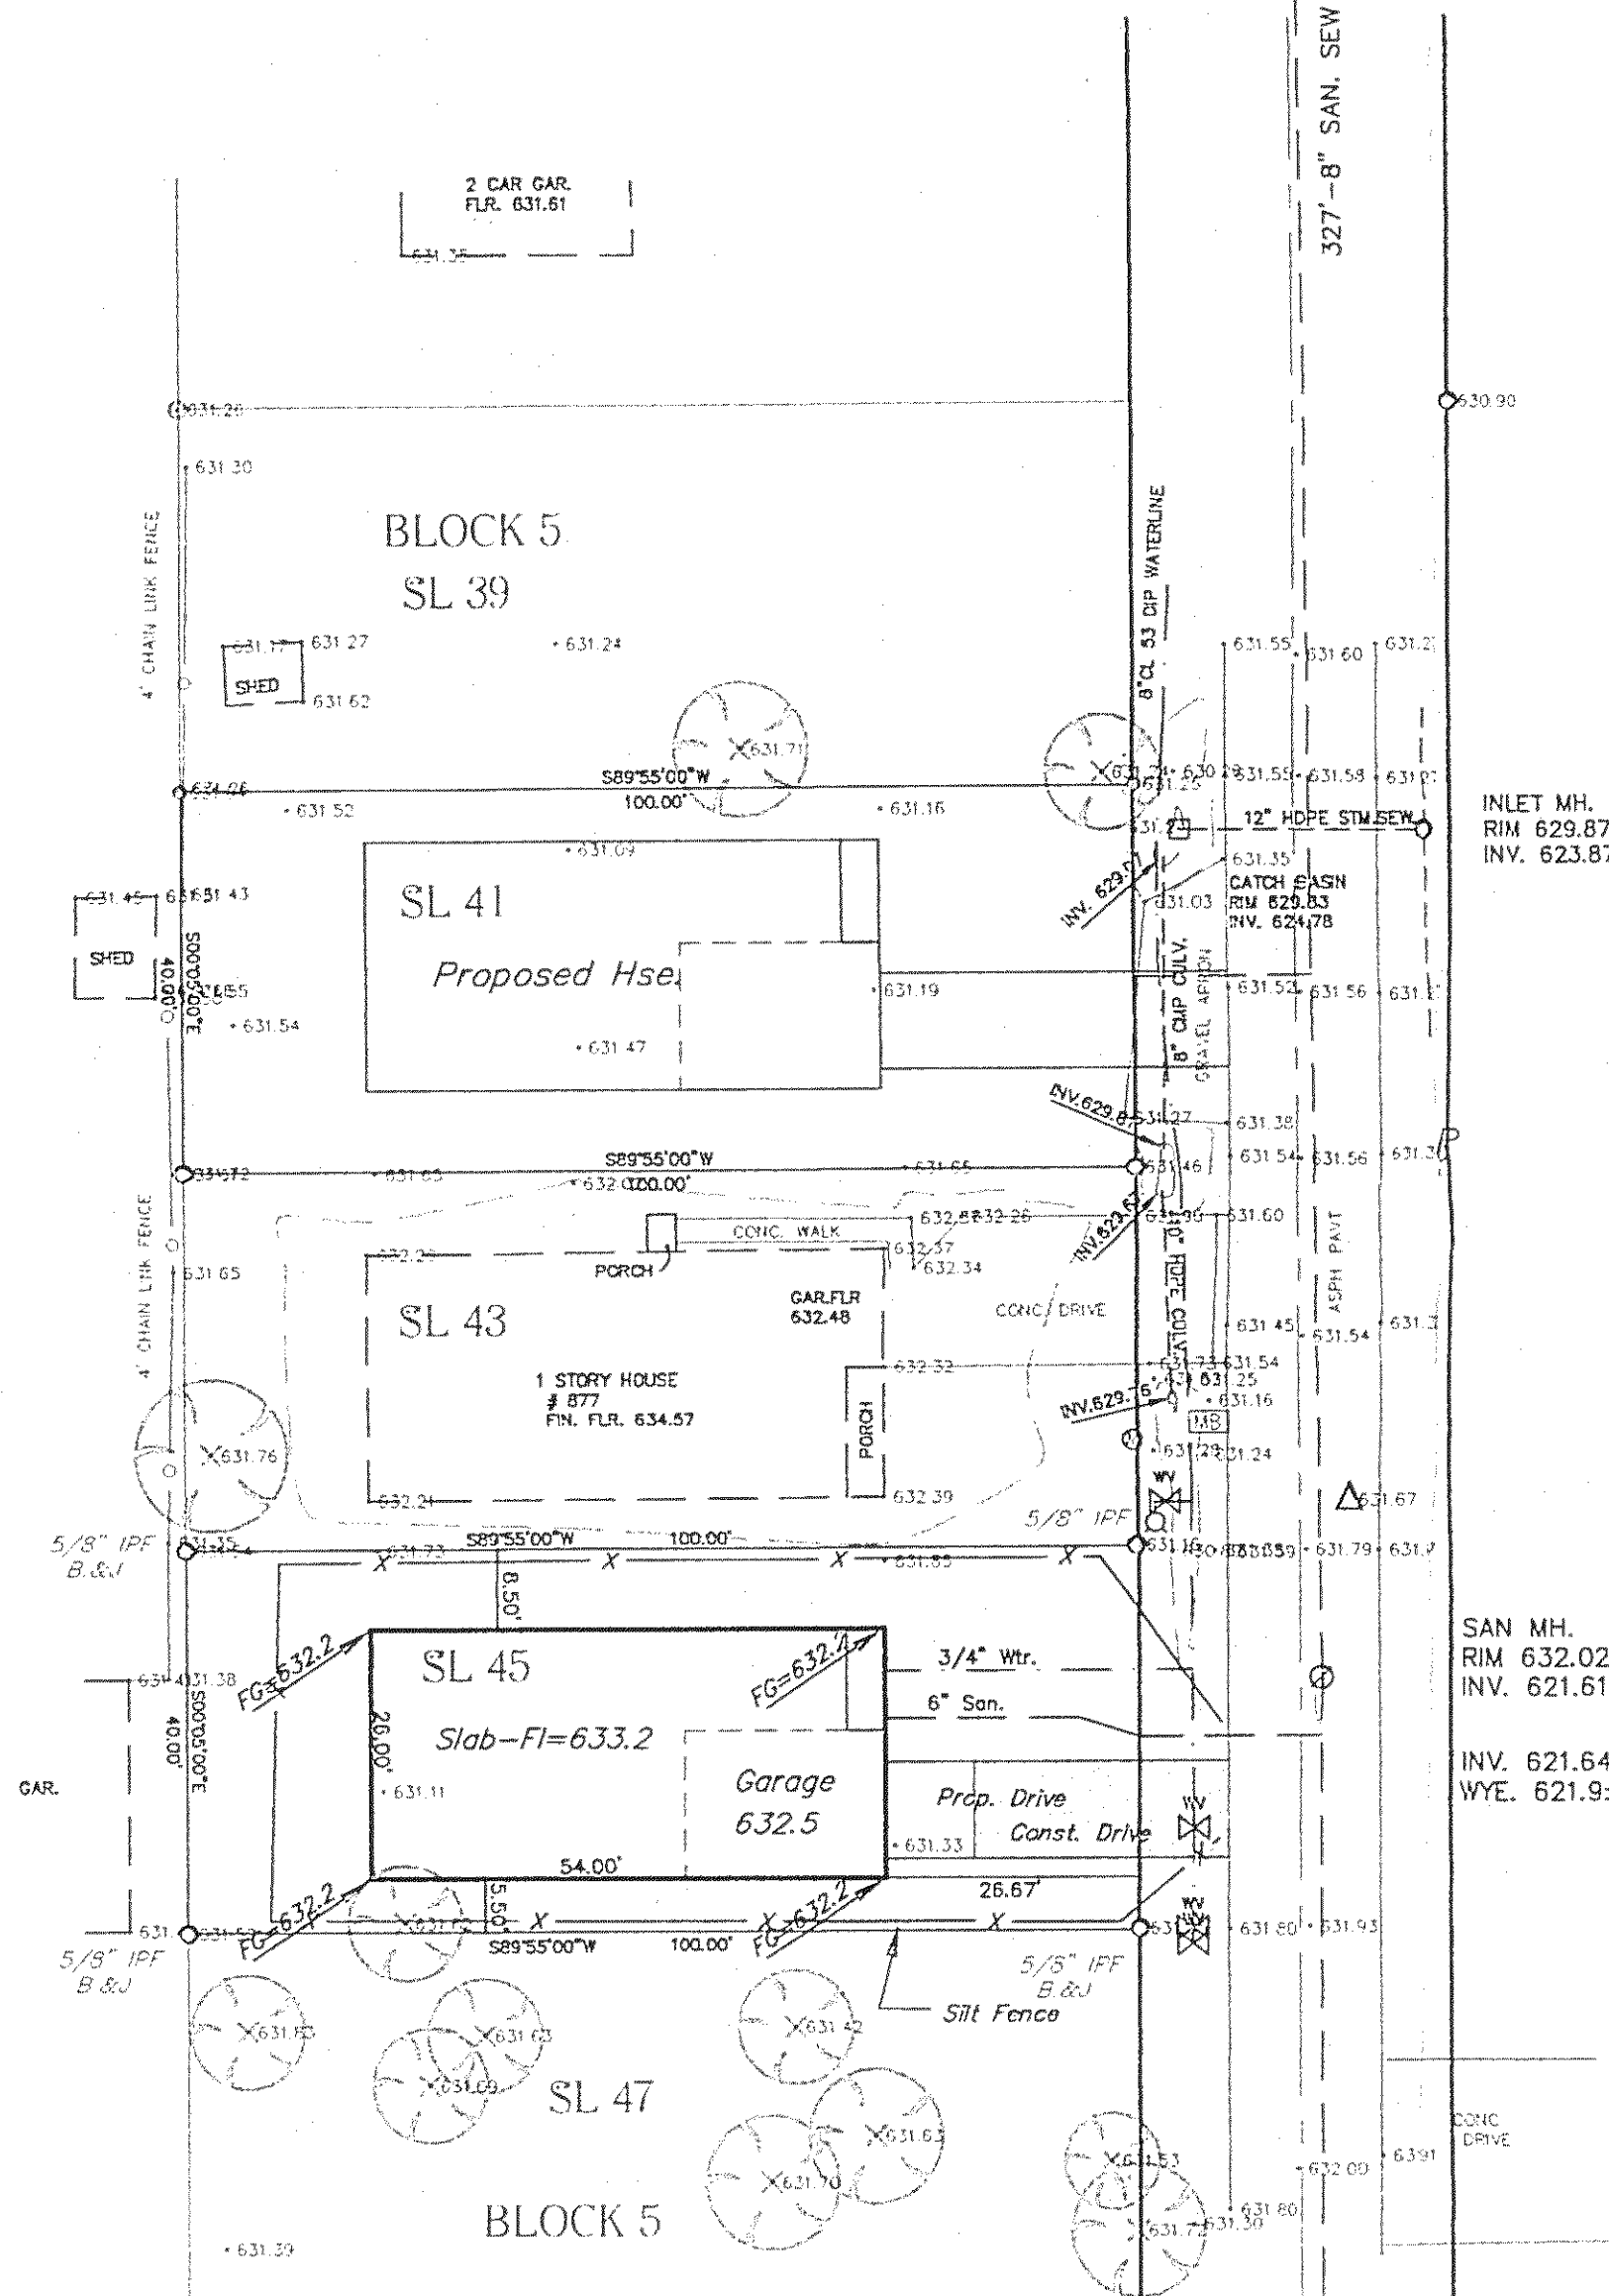


SAN MH.
RIM 632.02
INV. 621.61

INV. 621.64±
WYE. 621.9±

SAN MH.
RIM 631.90
INV. 623.10


FREMONT AVE. 34

NOTE: THE CONTRACTOR/BUILDER SHALL NOTIFY THE APPROVING ENGINEER IF GROUNDWATER IS OBSERVED DURING THE EXCAVATION OF THE BASEMENT.
-Contractor To Verify Depth And Location Of Utility Connections;
-See Architect Plans For Complete House Dimensions.

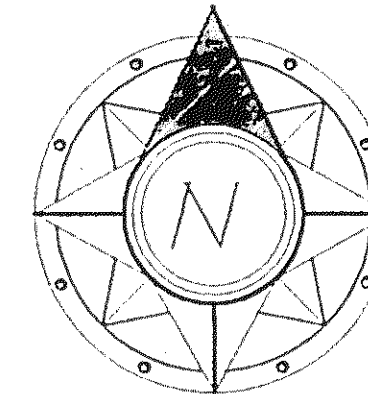

I, THE UNDERSIGNED, HEREBY CERTIFY THAT THIS TOPOGRAPHY, INDICATED BY 6" 1" OR 2" CONTOURS, AND ELEVATIONS SHOWN HEREON, REPRESENT AN ACTUAL FIELD SURVEY MADE BY ME ON THE 1st DAY OF May, 2004, AND THAT THE ELEVATIONS WERE TAKEN AT APPROPRIATE INTERVALS AND THAT AS OF THAT DATE, THEY EXISTED AS INDICATED HEREON.

James R. Pegoraro Jr. 7-7-04
James R. Pegoraro Jr., S.B.130

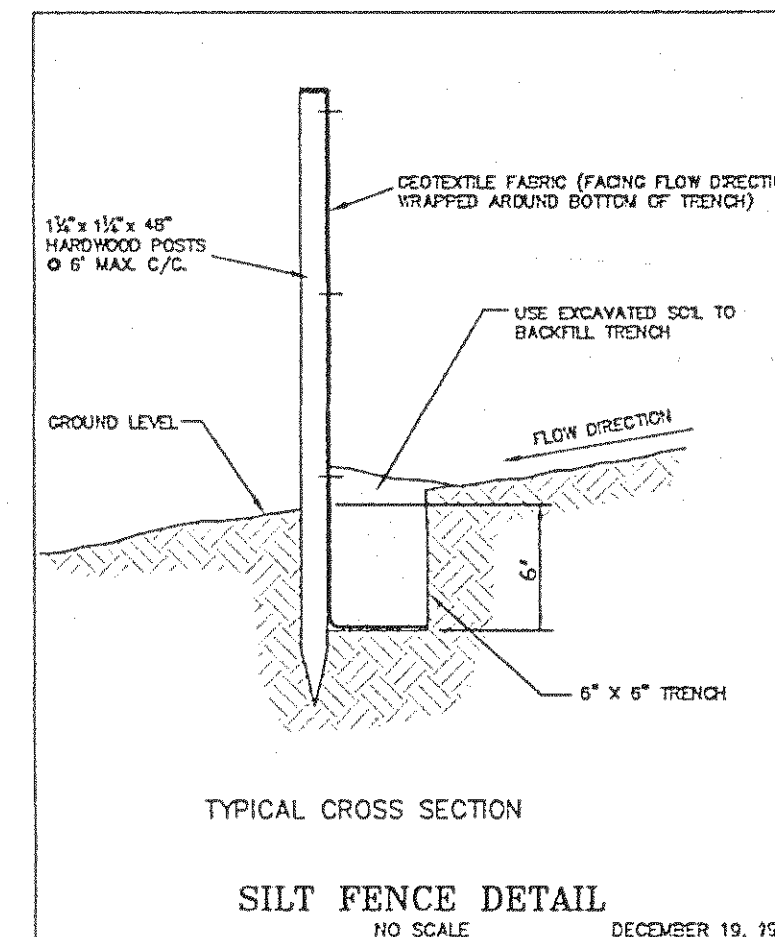

TYPICAL CROSS SECTION

SILT FENCE DETAIL

NO SCALE DECEMBER 19, 1997


1. The height of a silt fence shall not exceed 36 inches (higher fence may impound volumes of water sufficient to cause failure of the structure).
2. The filter fabric shall be purchased in a continuous roll cut to the length of the barrier to avoid the use of joint. When joints are necessary, filter cloth shall be stitched together only at a support post, with a minimum 6-inch overlap, and securely sealed.
3. Posts shall be spaced a maximum of 10 feet apart at the barrier-catch and driven securely into the ground (minimum of 12 inches) when extra strength fabric is used without this wire support fence. Post spacing shall not exceed 9 ft.
4. A trench shall be excavated approximately 4 inches wide and 4 inches deep along the line of posts and backfilled with the barrier.
5. When standard strength filter fabric is used, a wire mesh support fence shall be fastened securely to the updrift side of the posts using heavy duty wire staples at 6" intervals. The wire shall extend into the trench a minimum of 2 inches and shall not extend more than 25 inches above the original ground surface.
6. The standard strength filter fabric shall be stapled or wired to the fence, and 8 inches of the fabric shall be extended into the trench. The fabric shall not extend more than 36 inches above the original ground surface. Filter fabric shall not be stapled to existing trees.
7. When extra strength filter fabric and closer post spacing are used, the wire mesh support fence may be eliminated in such case, the filter fabric is stapled or wired directly to the posts with all other provisions of item No. 6. stapling.
8. The trench shall be backfilled and soil compacted over the filter fabric.
9. Silt fences shall be removed when they have served their useful purpose, but not before the updrift area has been permanently stabilized.

MAINTENANCE

1. Silt fences and filter barriers shall be inspected immediately after each rainfall and at least daily during prolonged rainfall. Any required repairs shall be made immediately.
2. Should the fabric on a silt fence of filter barrier decompose or become ineffective prior to the end of the expected useful life and the barrier is still necessary, the barrier shall be replaced promptly.
3. Sediment deposits should be removed after each storm event. It must be removed when deposits reach approximately one-half the height of the barrier.
4. Any sediment deposits remaining in place after the silt fence filter barrier is no longer required shall be dressed to conform with the existing grade, graded and seeded.

SILT FENCE

NO SCALE

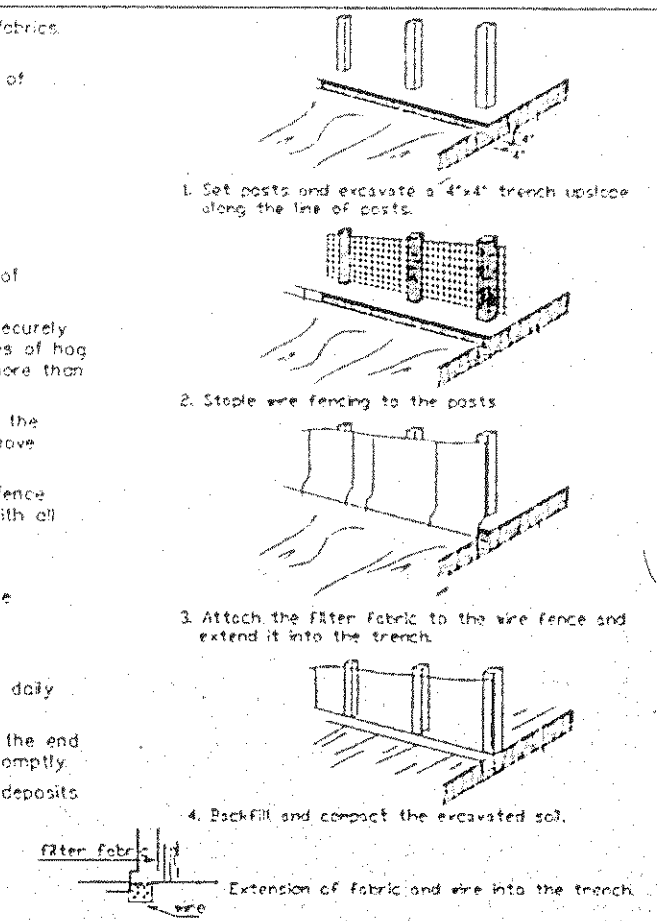

March 1, 1994

Stormwater Management Plan
Approved as shown and/or noted
JAMES R. GILLS, P.E.
County Drainage Engineer
By: [Signature] Date: 07/13/04
Scale to roadway

S/L 45
DWG. NAME
Habif1-0402



STATE OF OHIO
JAMES R. PEGORARO, JR.
S-8150
REGISTERED PROFESSIONAL SURVEYOR

STATE SEAL

"AS BUILT" CERTIFICATION
I HEREBY CERTIFY THAT THE CIRCLED INFORMATION IS EXISTING AS OBTAINED ON THE SITE, AND IS CORRECT TO THE BEST OF MY KNOWLEDGE AND BELIEF.

NAME
DRAWN BY Site-45
CHK'D BY/FIELD DATE 6/04
1
2

LEGEND
STORM MARKS
EXISTING CONTOURS
PROPOSED CONTOURS
EXIST. ELEV. 100.0
F.G. 100.0 = PROP. ELEV.
DIRECTION OF SURFACE DRAINAGE
ACCEPTED: CLIENT DATE

CHECK LIST
LOT DIMENSIONS & BEARINGS
TO NEAREST STREET
SUBLOT NO. (PARCEL NO.)
SURROUNDING OWNERS
ADJACENT DIMENSIONS
EASEMENTS
EASEMENT TYPE, WIDTH, THICKNESS
EASEMENT TYPE, WIDTH, THICKNESS
EASEMENT TYPE, WIDTH, THICKNESS
WATER MAIN SIZE, LOCATION
SAN, SEWER SIZE, GRADE, LOC.
SAN, WH, CAST, ELEV, INV. ELEV.
SAN, WH, CAST, ELEV, INV. ELEV.
STORM SEWER SIZE, GRADE, LOC.
STORM, WH, CAST, ELEV, INV. ELEV.
PAV'T TYPE, GRADE, CURBS
GAS LINE LOC, SIZE
SEPTIC SYSTEM & DUCTILATION
WELL LOCATION & ISOLATION RADIUS

DESIGN CERTIFICATION
THIS PLAN WAS PREPARED BY ME, AND IS CORRECT TO THE BEST OF MY KNOWLEDGE AND BELIEF.
NAME
7-7-04

SITE PLAN
For : Painesville Area Habitat for Humanity
CLIENT
391 Washington St. Painesville
ADDRESS STREET CITY
45 Painesville on the Lake B 13
SUBLOT No. SUBDIVISION NAME VOL. PAGE
2 2 Painesville Twp OHIO
LOT TRACT CITY/TOWNSHIP

Prepared By:
LAND DESIGN consultants
Civil Engineers and Surveyors
6885 EAST AVENUE - MENTOR, OHIO 44060
TELEPHONE 255-8463 354-6938 951-LAND

EXISTING UNDERGROUND UTILITIES NOTE:
THE SIZE & LOCATION, BOTH HORIZONTAL AND VERTICAL, OF THE UNDERGROUND UTILITIES SHOWN HEREON, HAVE BEEN OBTAINED BY A SEARCH OF AVAILABLE RECORDS. VERIFICATION BY FIELD OBSERVATION HAS BEEN CONDUCTED WHERE PRACTICAL. HOWEVER, LDC INC. DOES NOT GUARANTEE THE COMPLETENESS OR ACCURACY THEREOF.

2 WORKING DAYS
BEFORE YOU DIG
CALL TOLL FREE 800-362-2764
OHIO UTILITIES PROTECTION SERVICE