
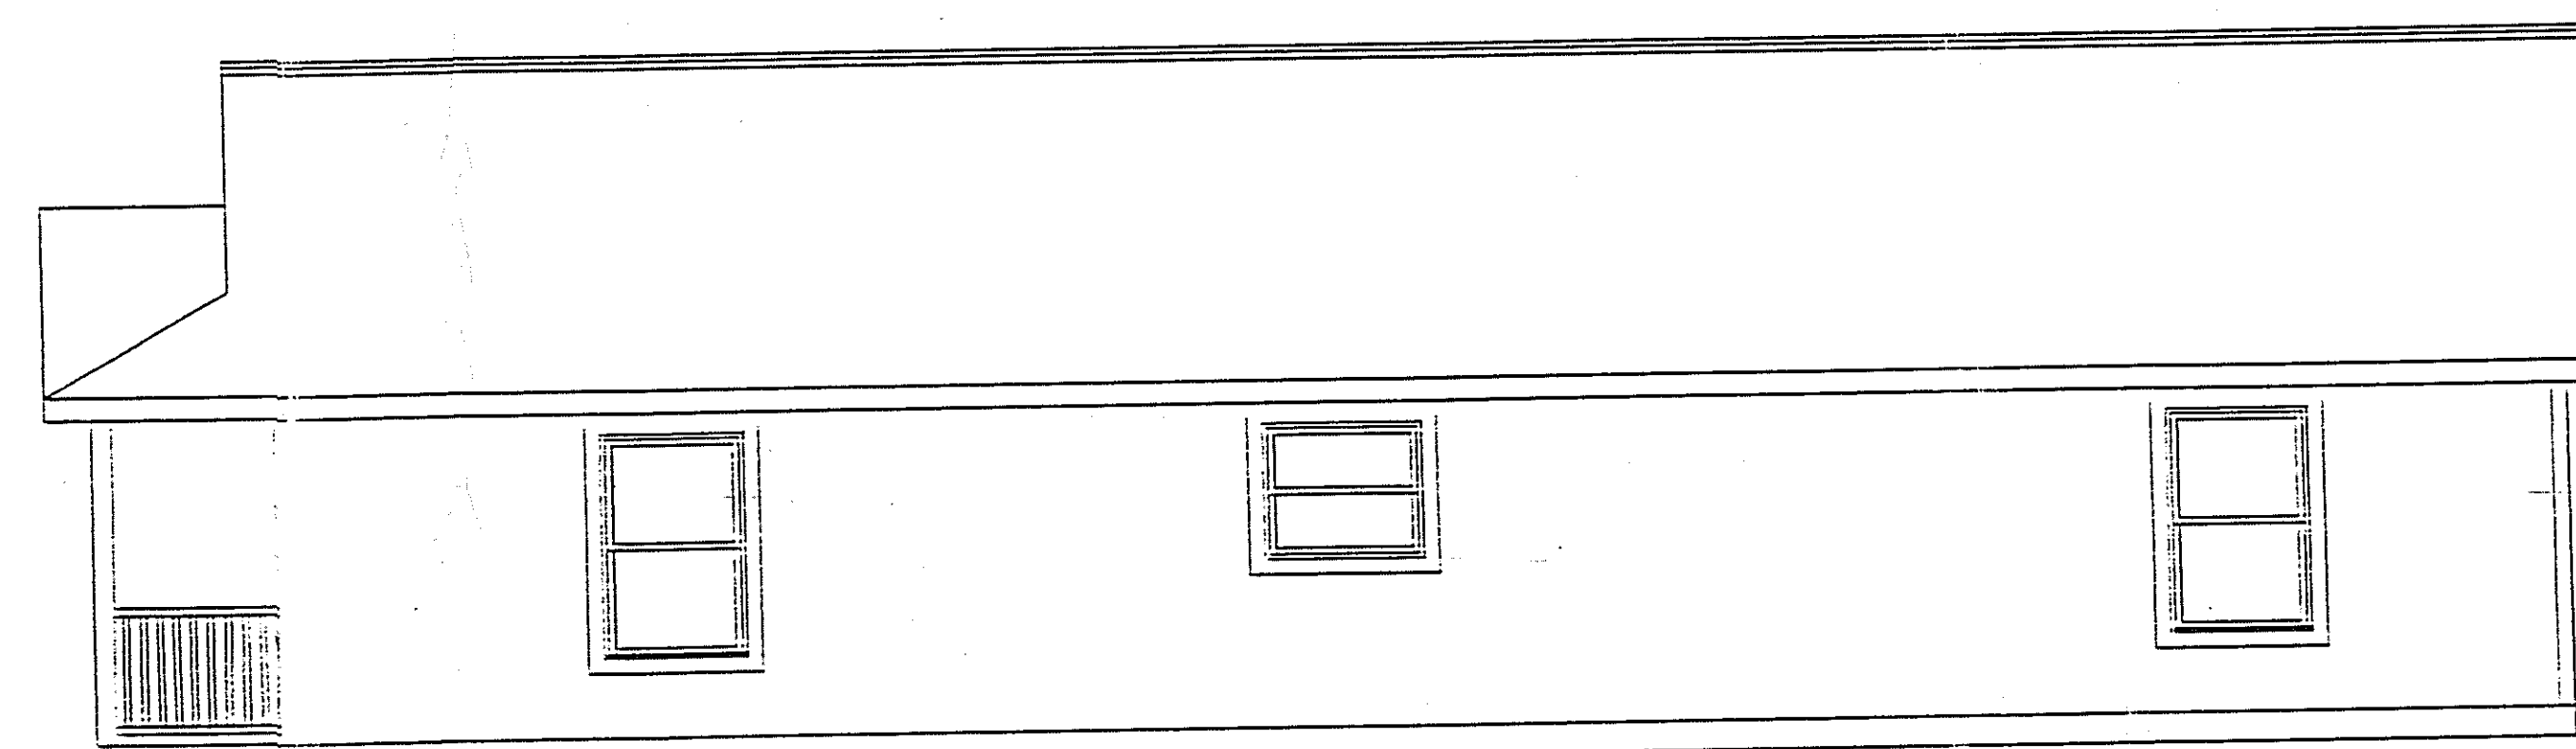
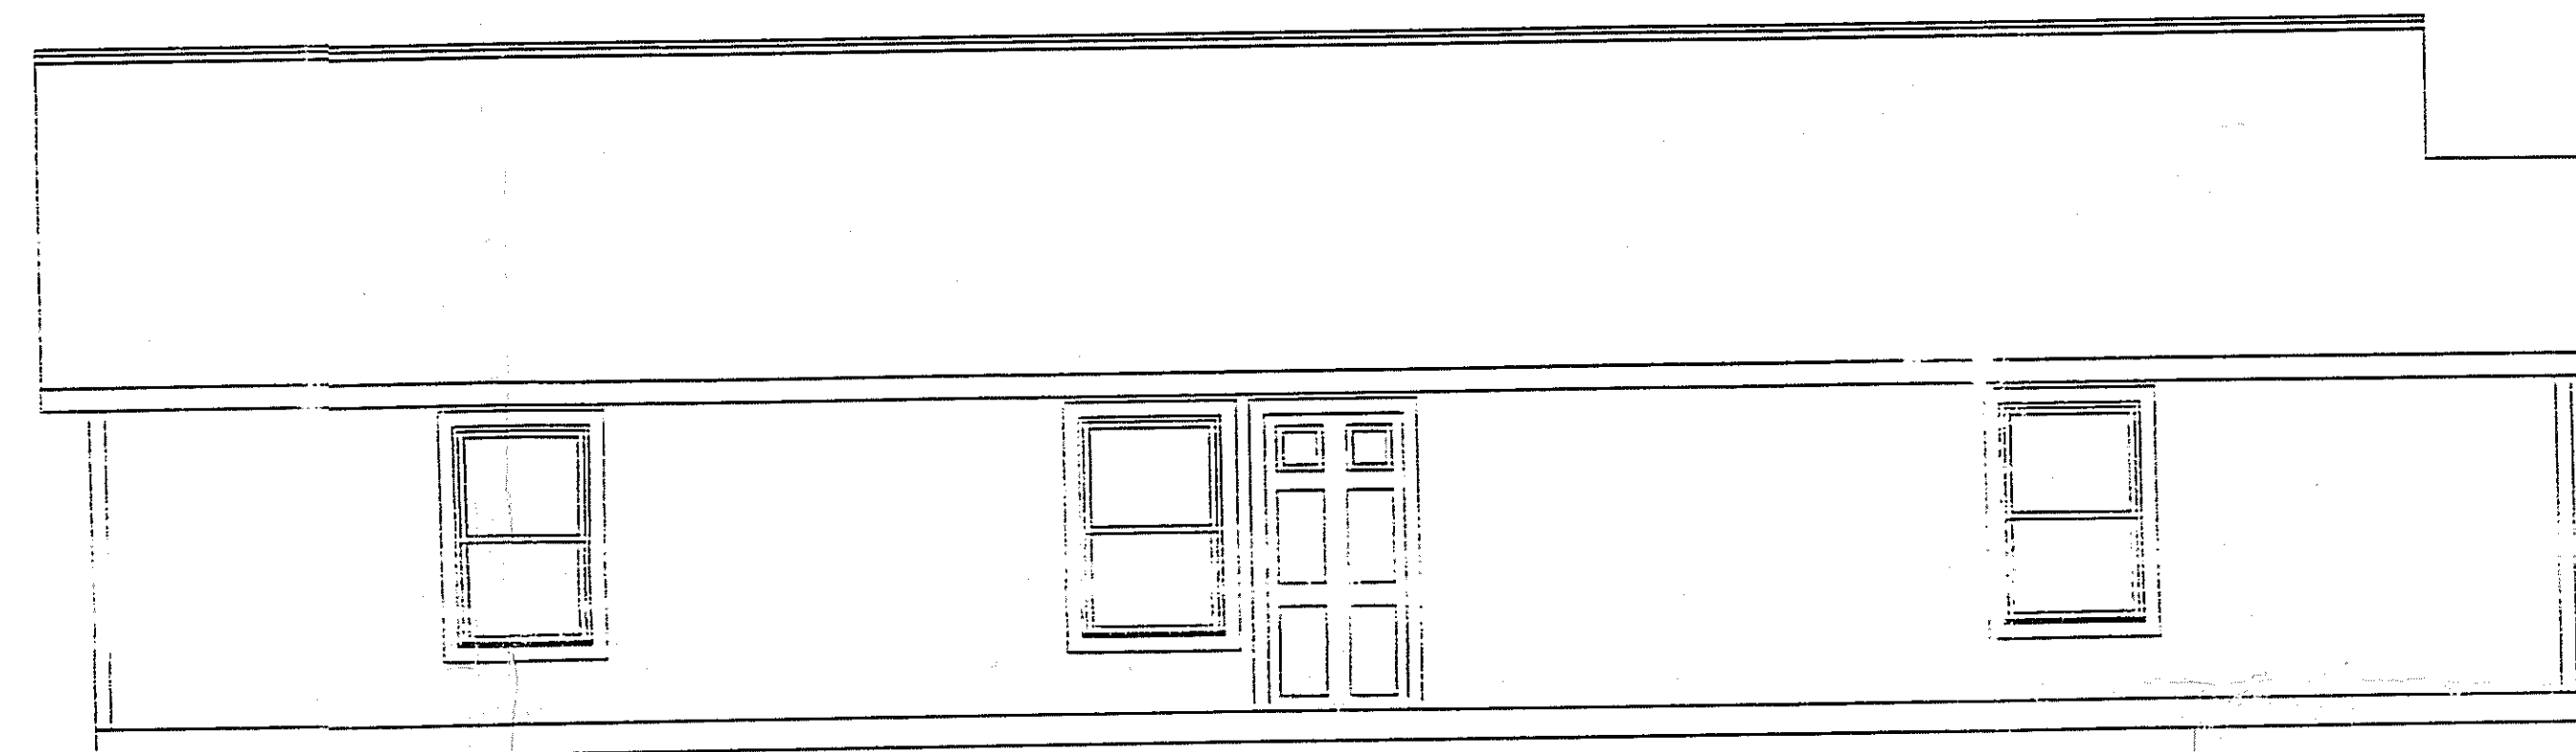
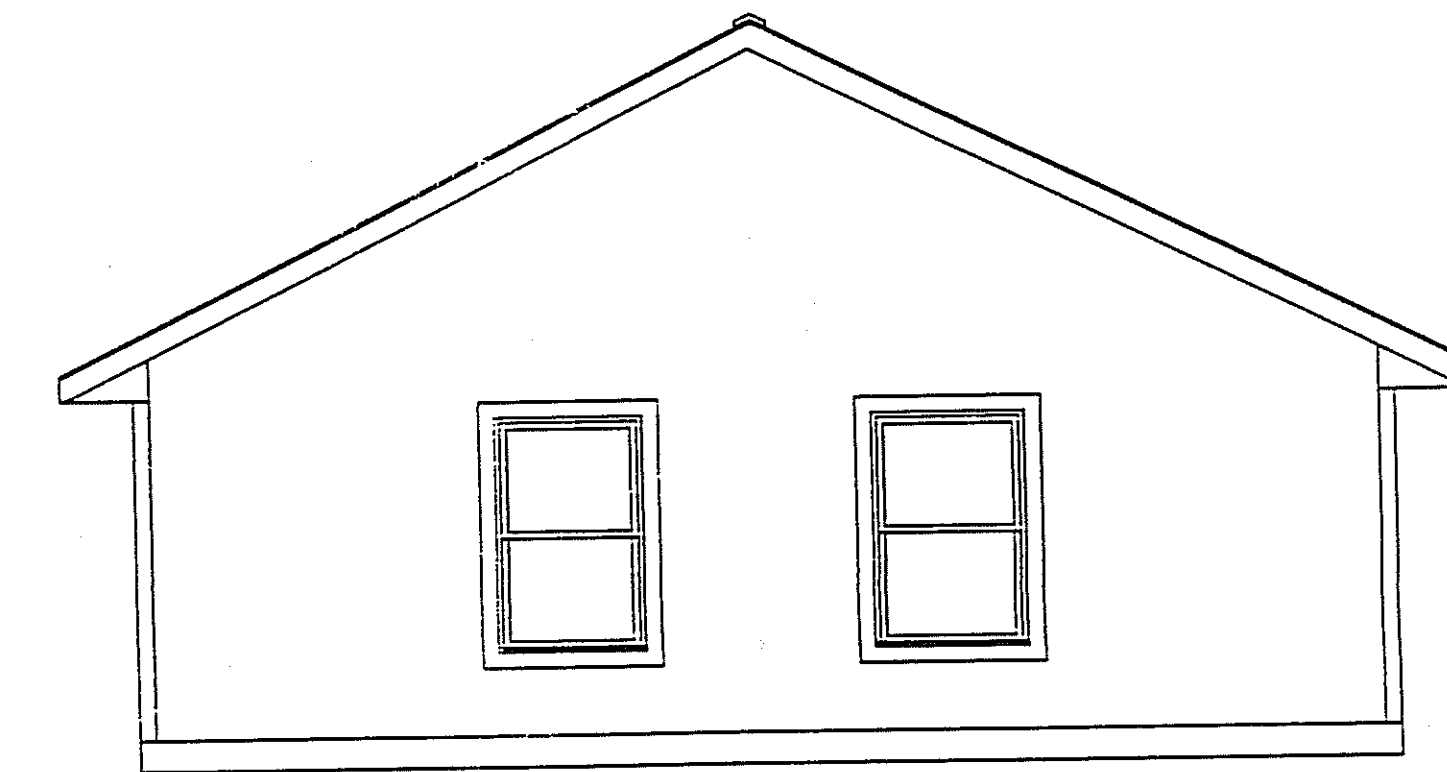
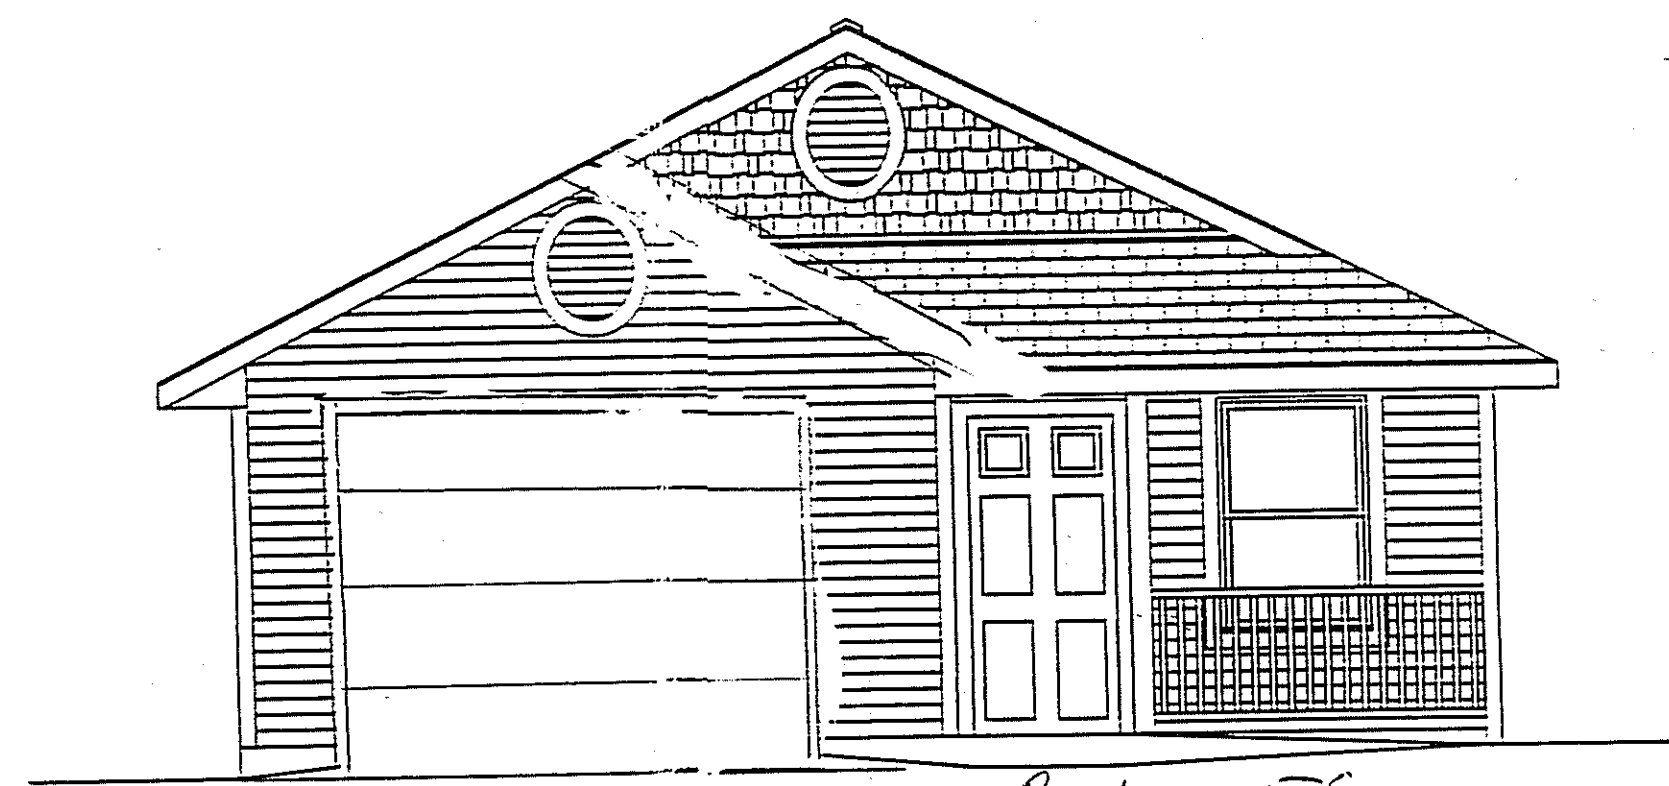
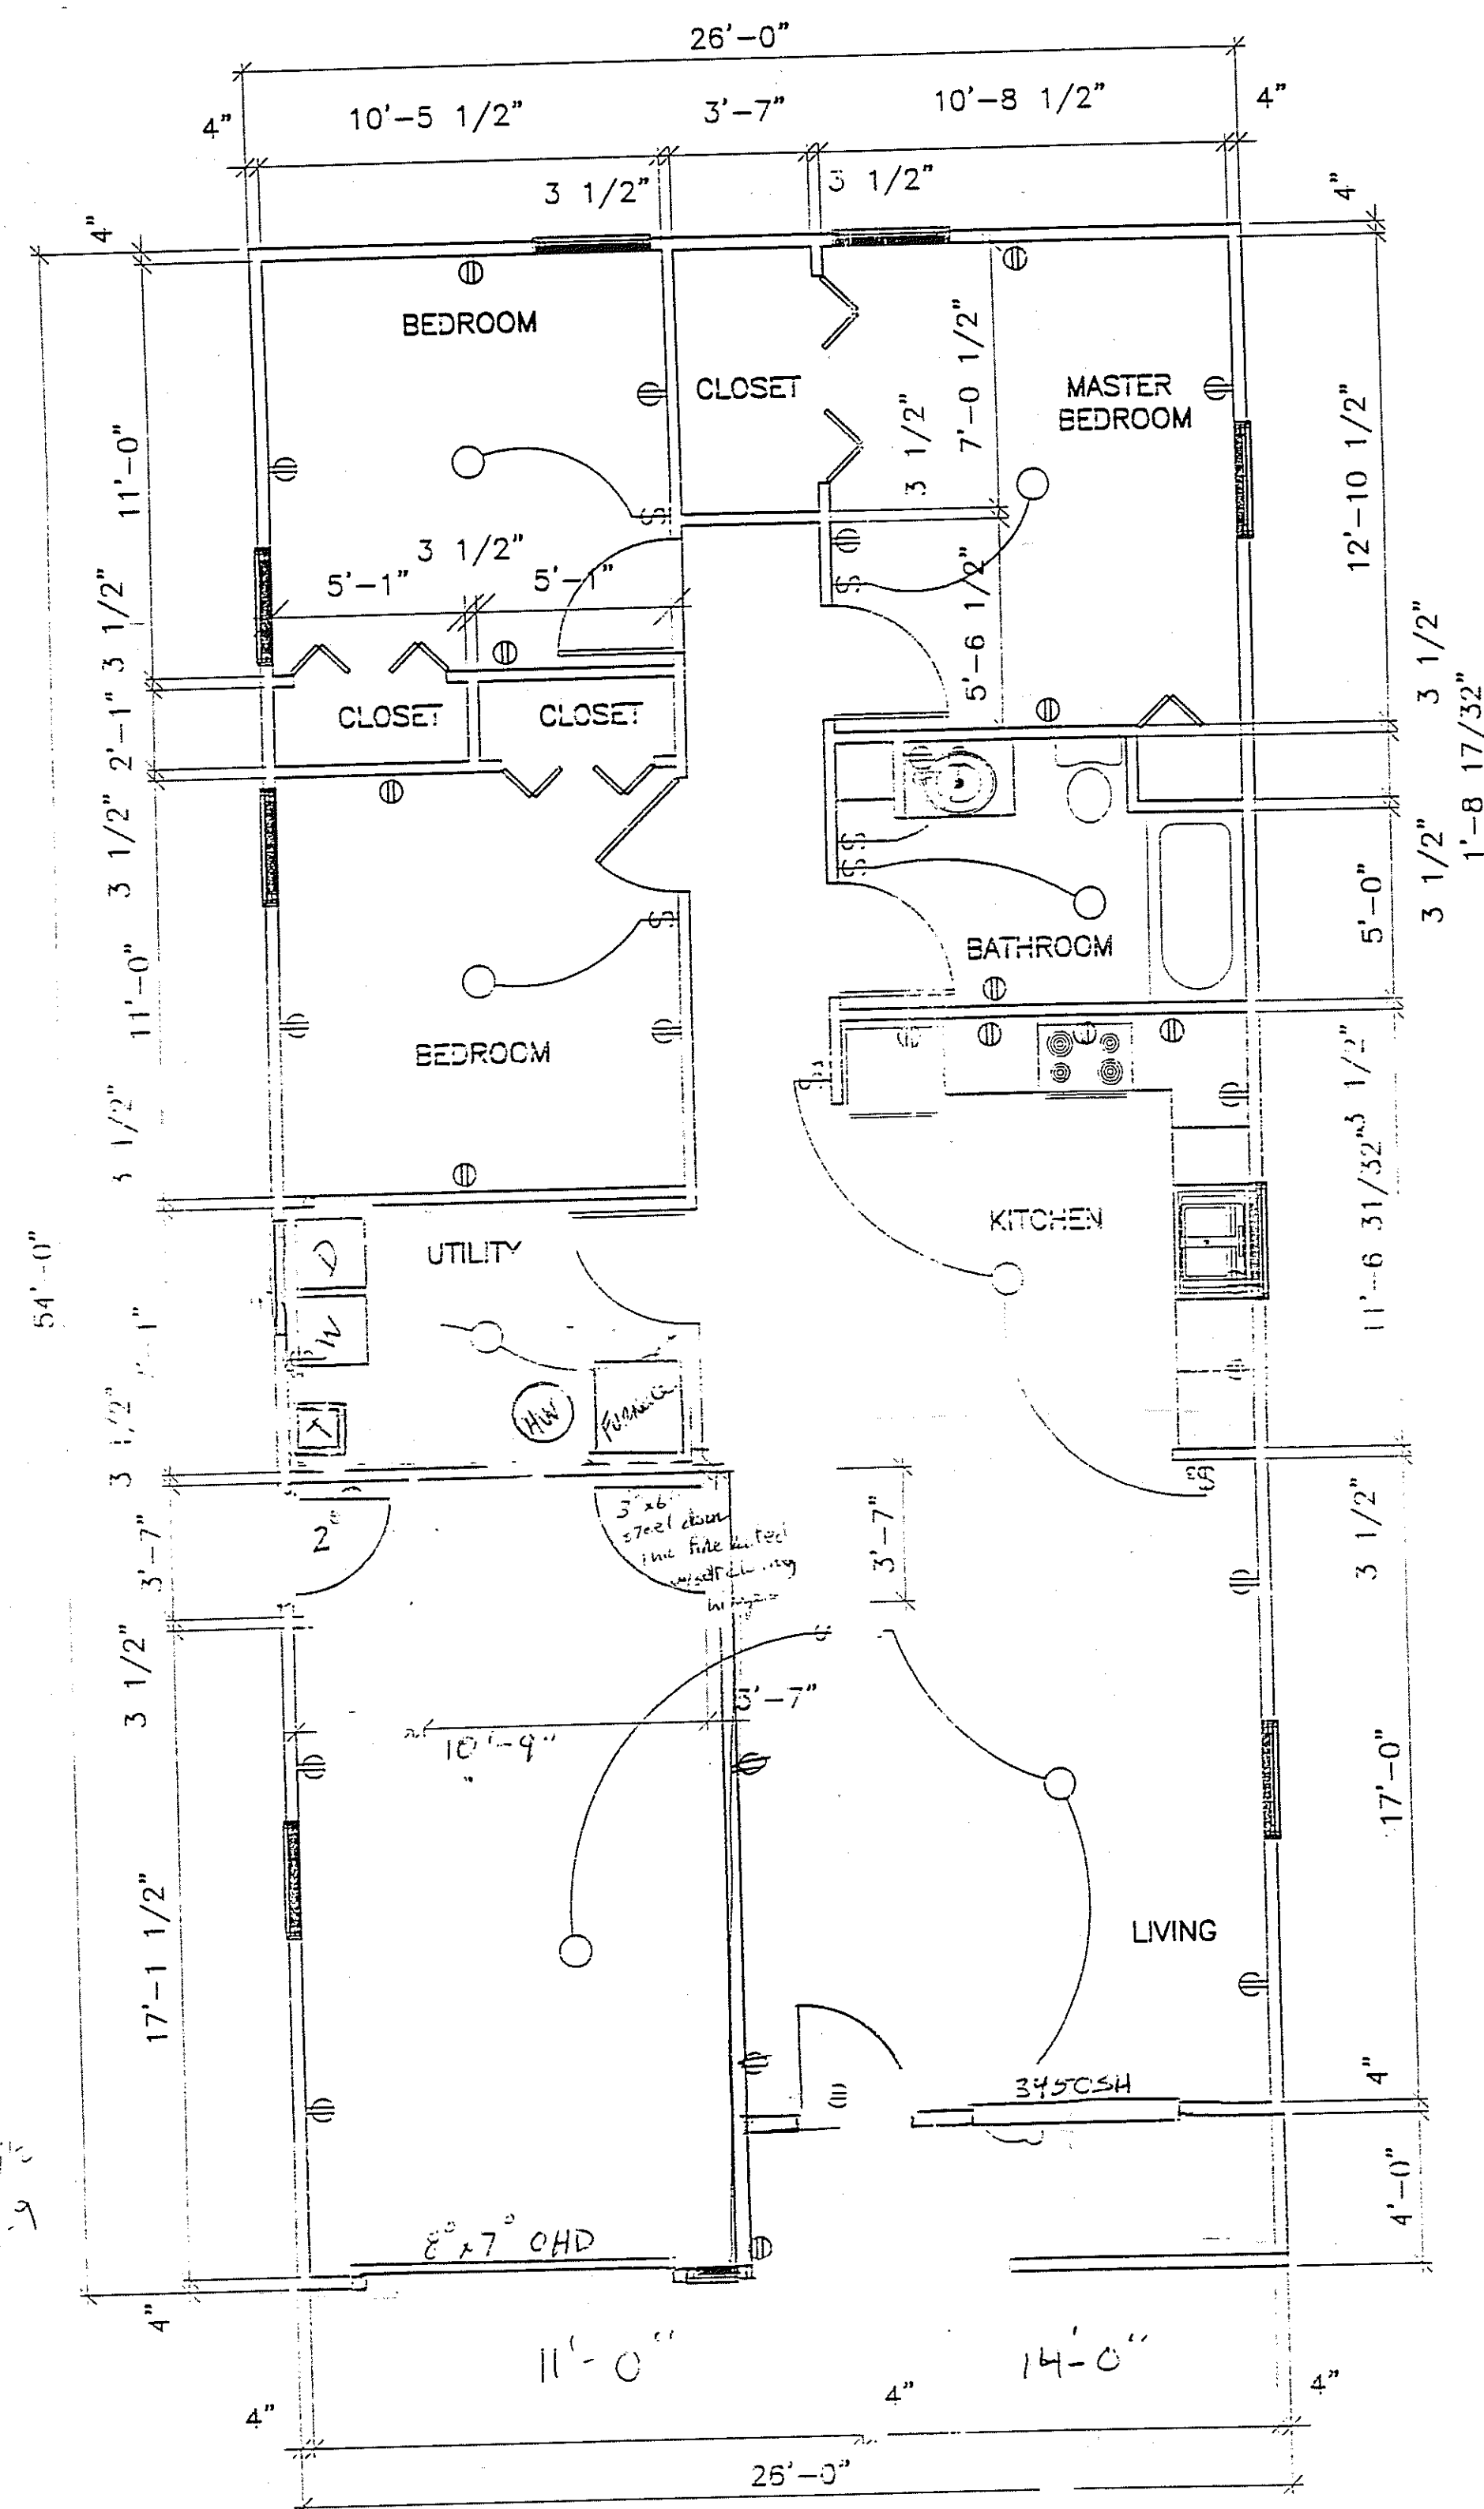


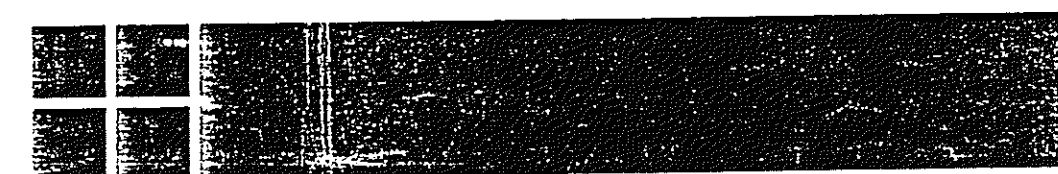

I:\EXPLORERS\40 FOOT LOI.DWG 5-24--04 10:27:05 am DELAMO

[illegible]

HABITAT FOR HUMANITY

JOB NO.	
DESIGNED BY:	EXP
DRAWN BY:	EXP
CHECKED BY:	RAY
APPROVED BY:	RAY
DATE:	6/04

FLOOR PLAN AND ELEVATIONS

SCALE:

AS NOTED

SHEET NO.	OF
2	2