



BENCHMARK - 707.65
N. RIM SAN. M. H. : INV. 697.83

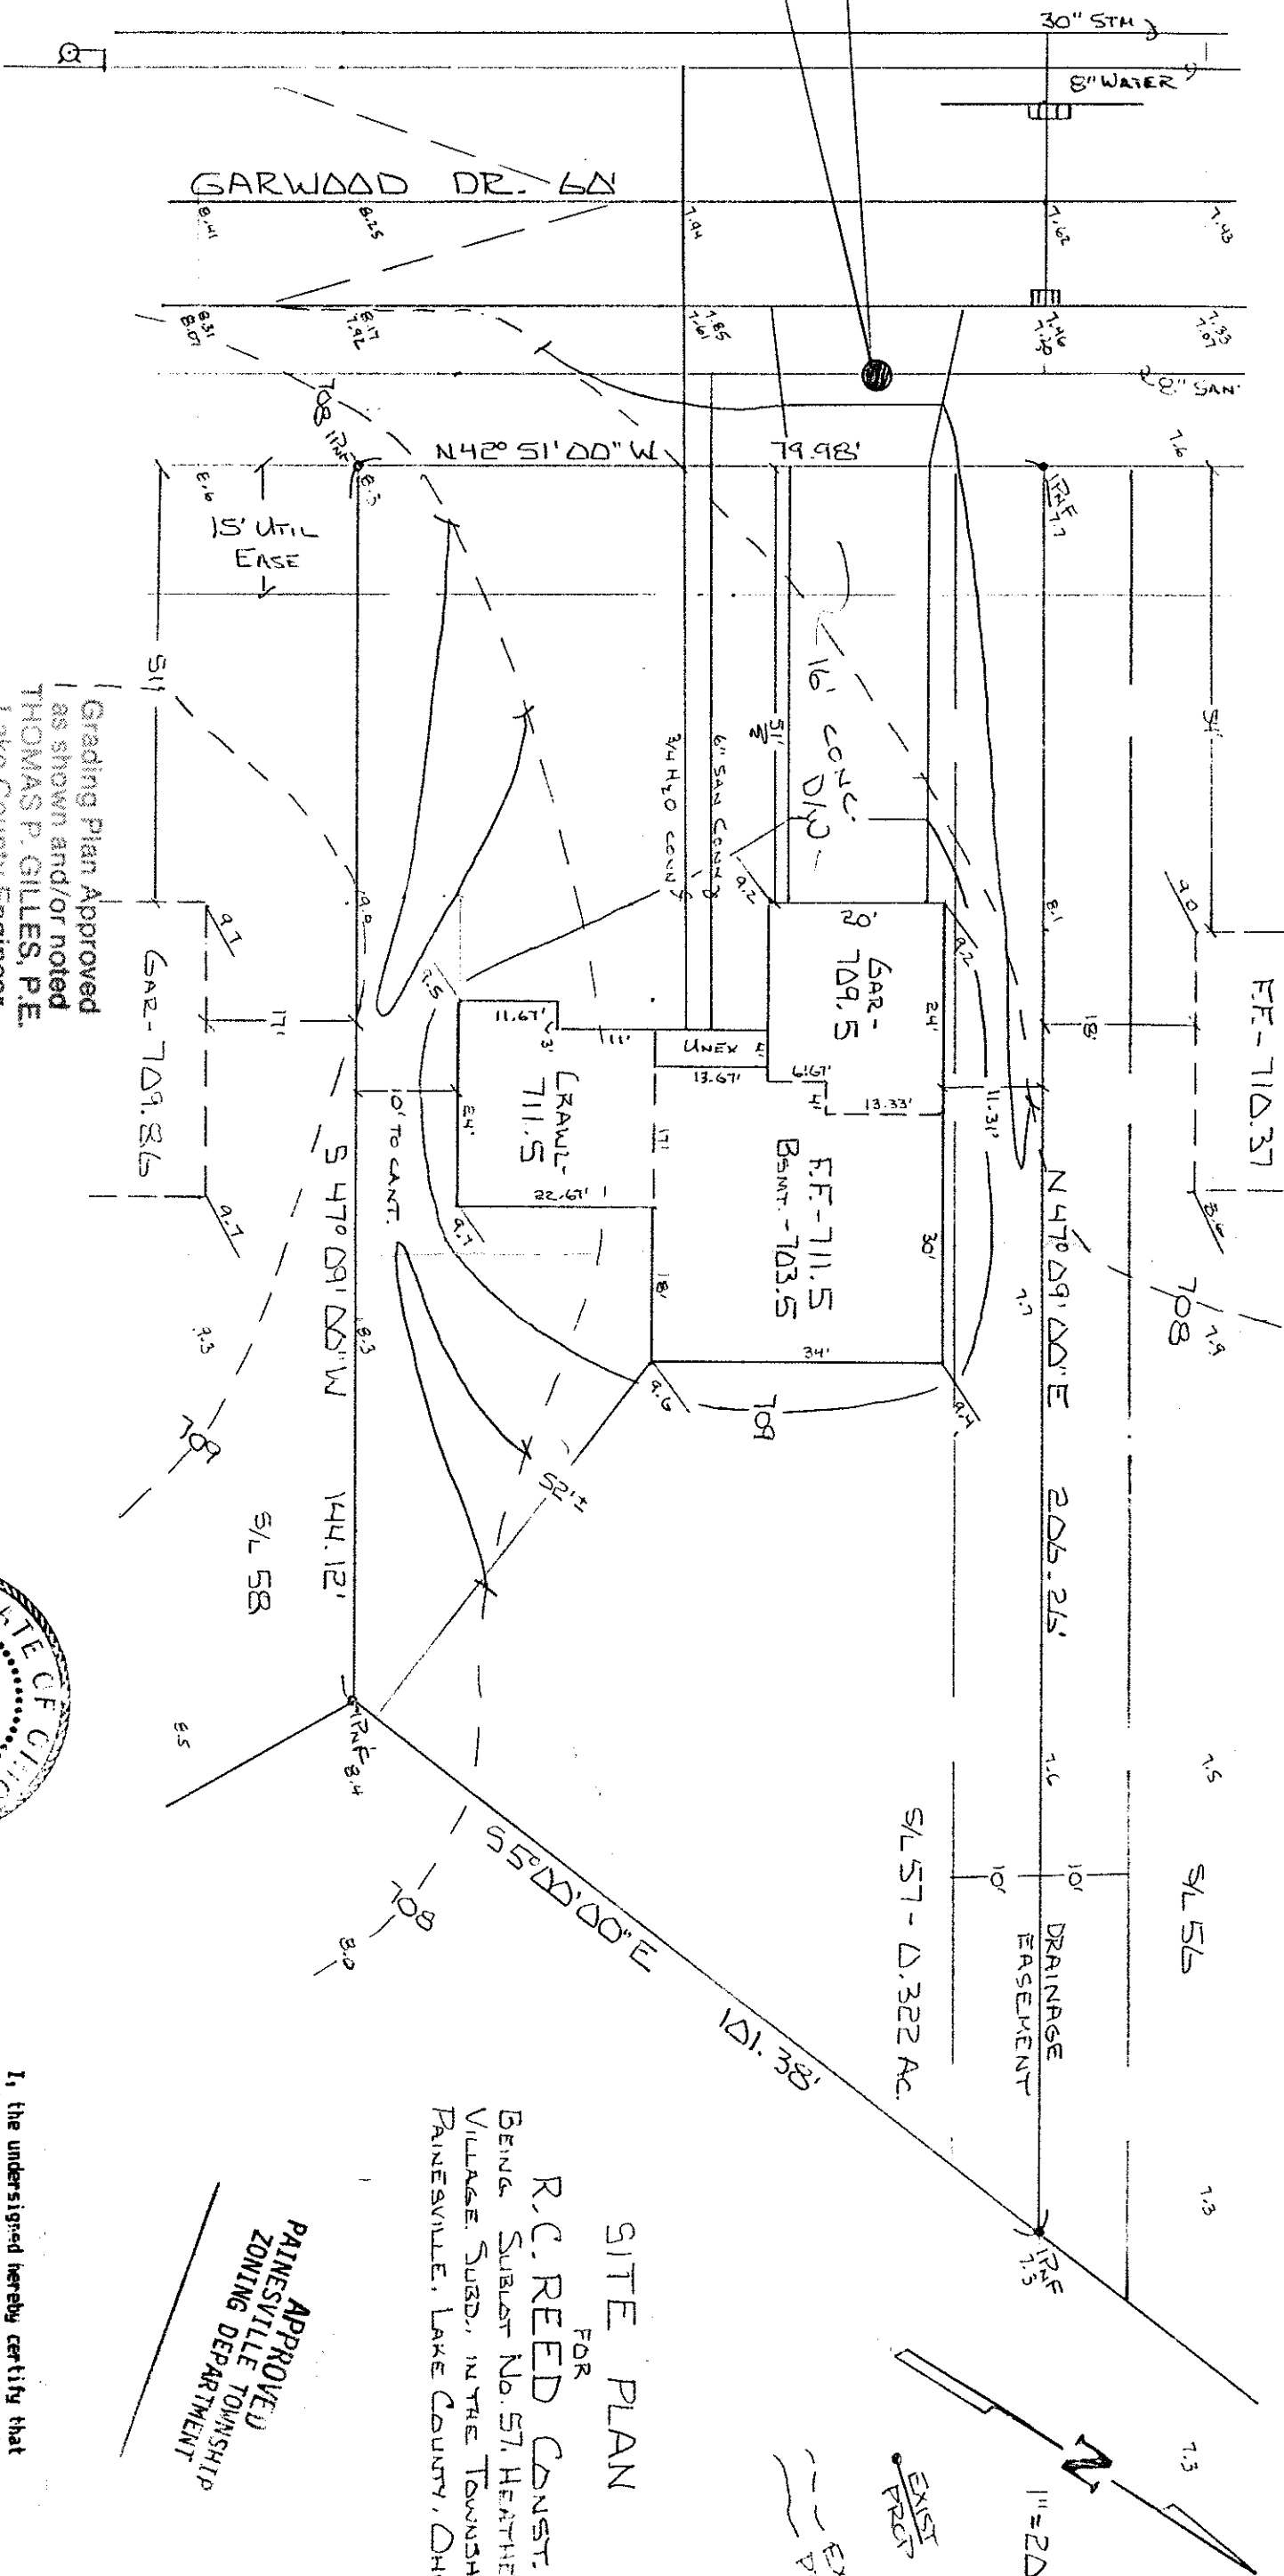

Grading Plan Approved
as shown and/or noted
THOMAS P. GILLES, P.E.
Lake County Engineer
BY GPJ Date 9-10-92
DISCHARGE SUMP PUMP TO
STM. SEWER.

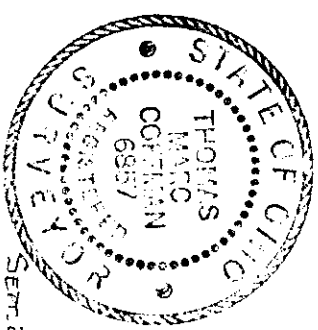

VILLAGE SURVEYING Co.
202 THIRD ST., FAIRPORT HBR., OH 44077
(216) 357-1359

APPROVED
PAINESVILLE TOWNSHIP
ZONING DEPARTMENT

SITE PLAN
FOR
R.C. REED CONST.
BEING SUBLOT NO. 57, HEATHERSTONE
VILLAGE SUBD., IN THE TOWNSHIP OF
PAINESVILLE, LAKE COUNTY, OHIO.

I, the undersigned hereby certify that
this topography, indicated by 1' contours,
and elevations shown hereon represent an
actual field survey made by me on July 31, 1992
and that the elevations were taken at
appropriate intervals and that as of that
date they existed as indicated hereon.

J. M. Coffman, P.S.
146657